

# Grisim Family

110 Columbus St.  
El Granada, CA 94018

March 10, 2021

To whom it may concern;

We live next door to 1120 Columbus St. and are writing this letter to explain why we would like the pony wall on the back of the deck to remain. This pony wall creates a sense of privacy between the two properties, and without the pony wall, the deck is next to our kitchen and dining room, creating a clear view of our home. The wall currently provides us with some privacy from the neighbor. Visually it looks very appealing and makes an excellent separation between the two balconies. We would like for the wall to be allowed to remain. Please, don't hesitate to contact us if you have any questions or concerns.

Sincerely,

A handwritten signature in black ink, appearing to read "Lisa and Brad Grisim". The signature is fluid and cursive, with the first name "Lisa" being more prominent and the second name "Brad" following it.

Lisa and Brad Grisim

**RECEIVED**

Apr 01, 2021

San Mateo County  
Planning Division


RECEIVED

Apr 01, 2021

San Mateo County  
Planning Division

PLANNING DATA

GROSS LOT AREA	=	6026 SF	
ZONING-S-17 COMBING DISTRICT(MID COAST)			
ALLOWABLE FLOOR AREA	=	3193.78 SF	
<b>PROPOSED FLOOR AREAS</b>			
MAIN LEVEL		1081 SF	}
LOWER LEVEL	+	1281 SF	
LIVING SUBTOTAL	=	2362 SF	
FRONT PORCH	+	25 SF	
GARAGE	+	437 SF	
TOTAL	=	2824 SF	
FLOOR AREA RATIO	=	46.86%	
<b>SETBACKS</b>			
FRONT	=	20'	
SIDES COMBINED TOTAL OF 15'	=	5' MIN.	
REAR	=	20'	
PARCEL COVERAGE 35% MAX.	=	2109.1 SF	} 34.4%
PROPOSED COVERAGE	=	2074 SF	
HEIGHT LIMIT	=	28'	

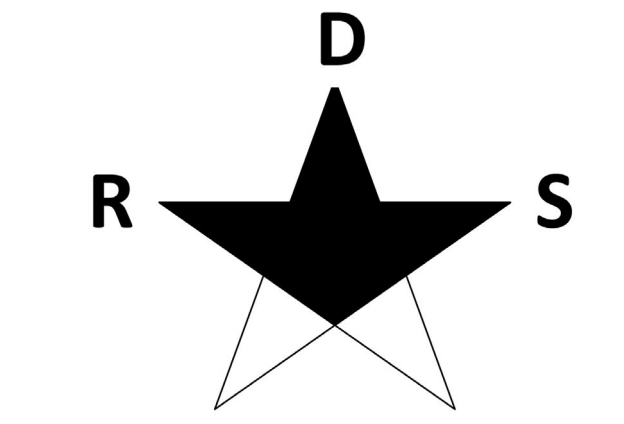


**RESIDENTIAL  
DESIGN SOLUTIONS**


406 LA JOLLA AVENUE  
SAN MATEO, CA 94403  
(650) 218-8161  
EMAIL RDS@CHRISTIANRUFFAT.COM  
WEB CHRISTIANRUFFAT.COM



BLOCK 20  
5 MAPS 43

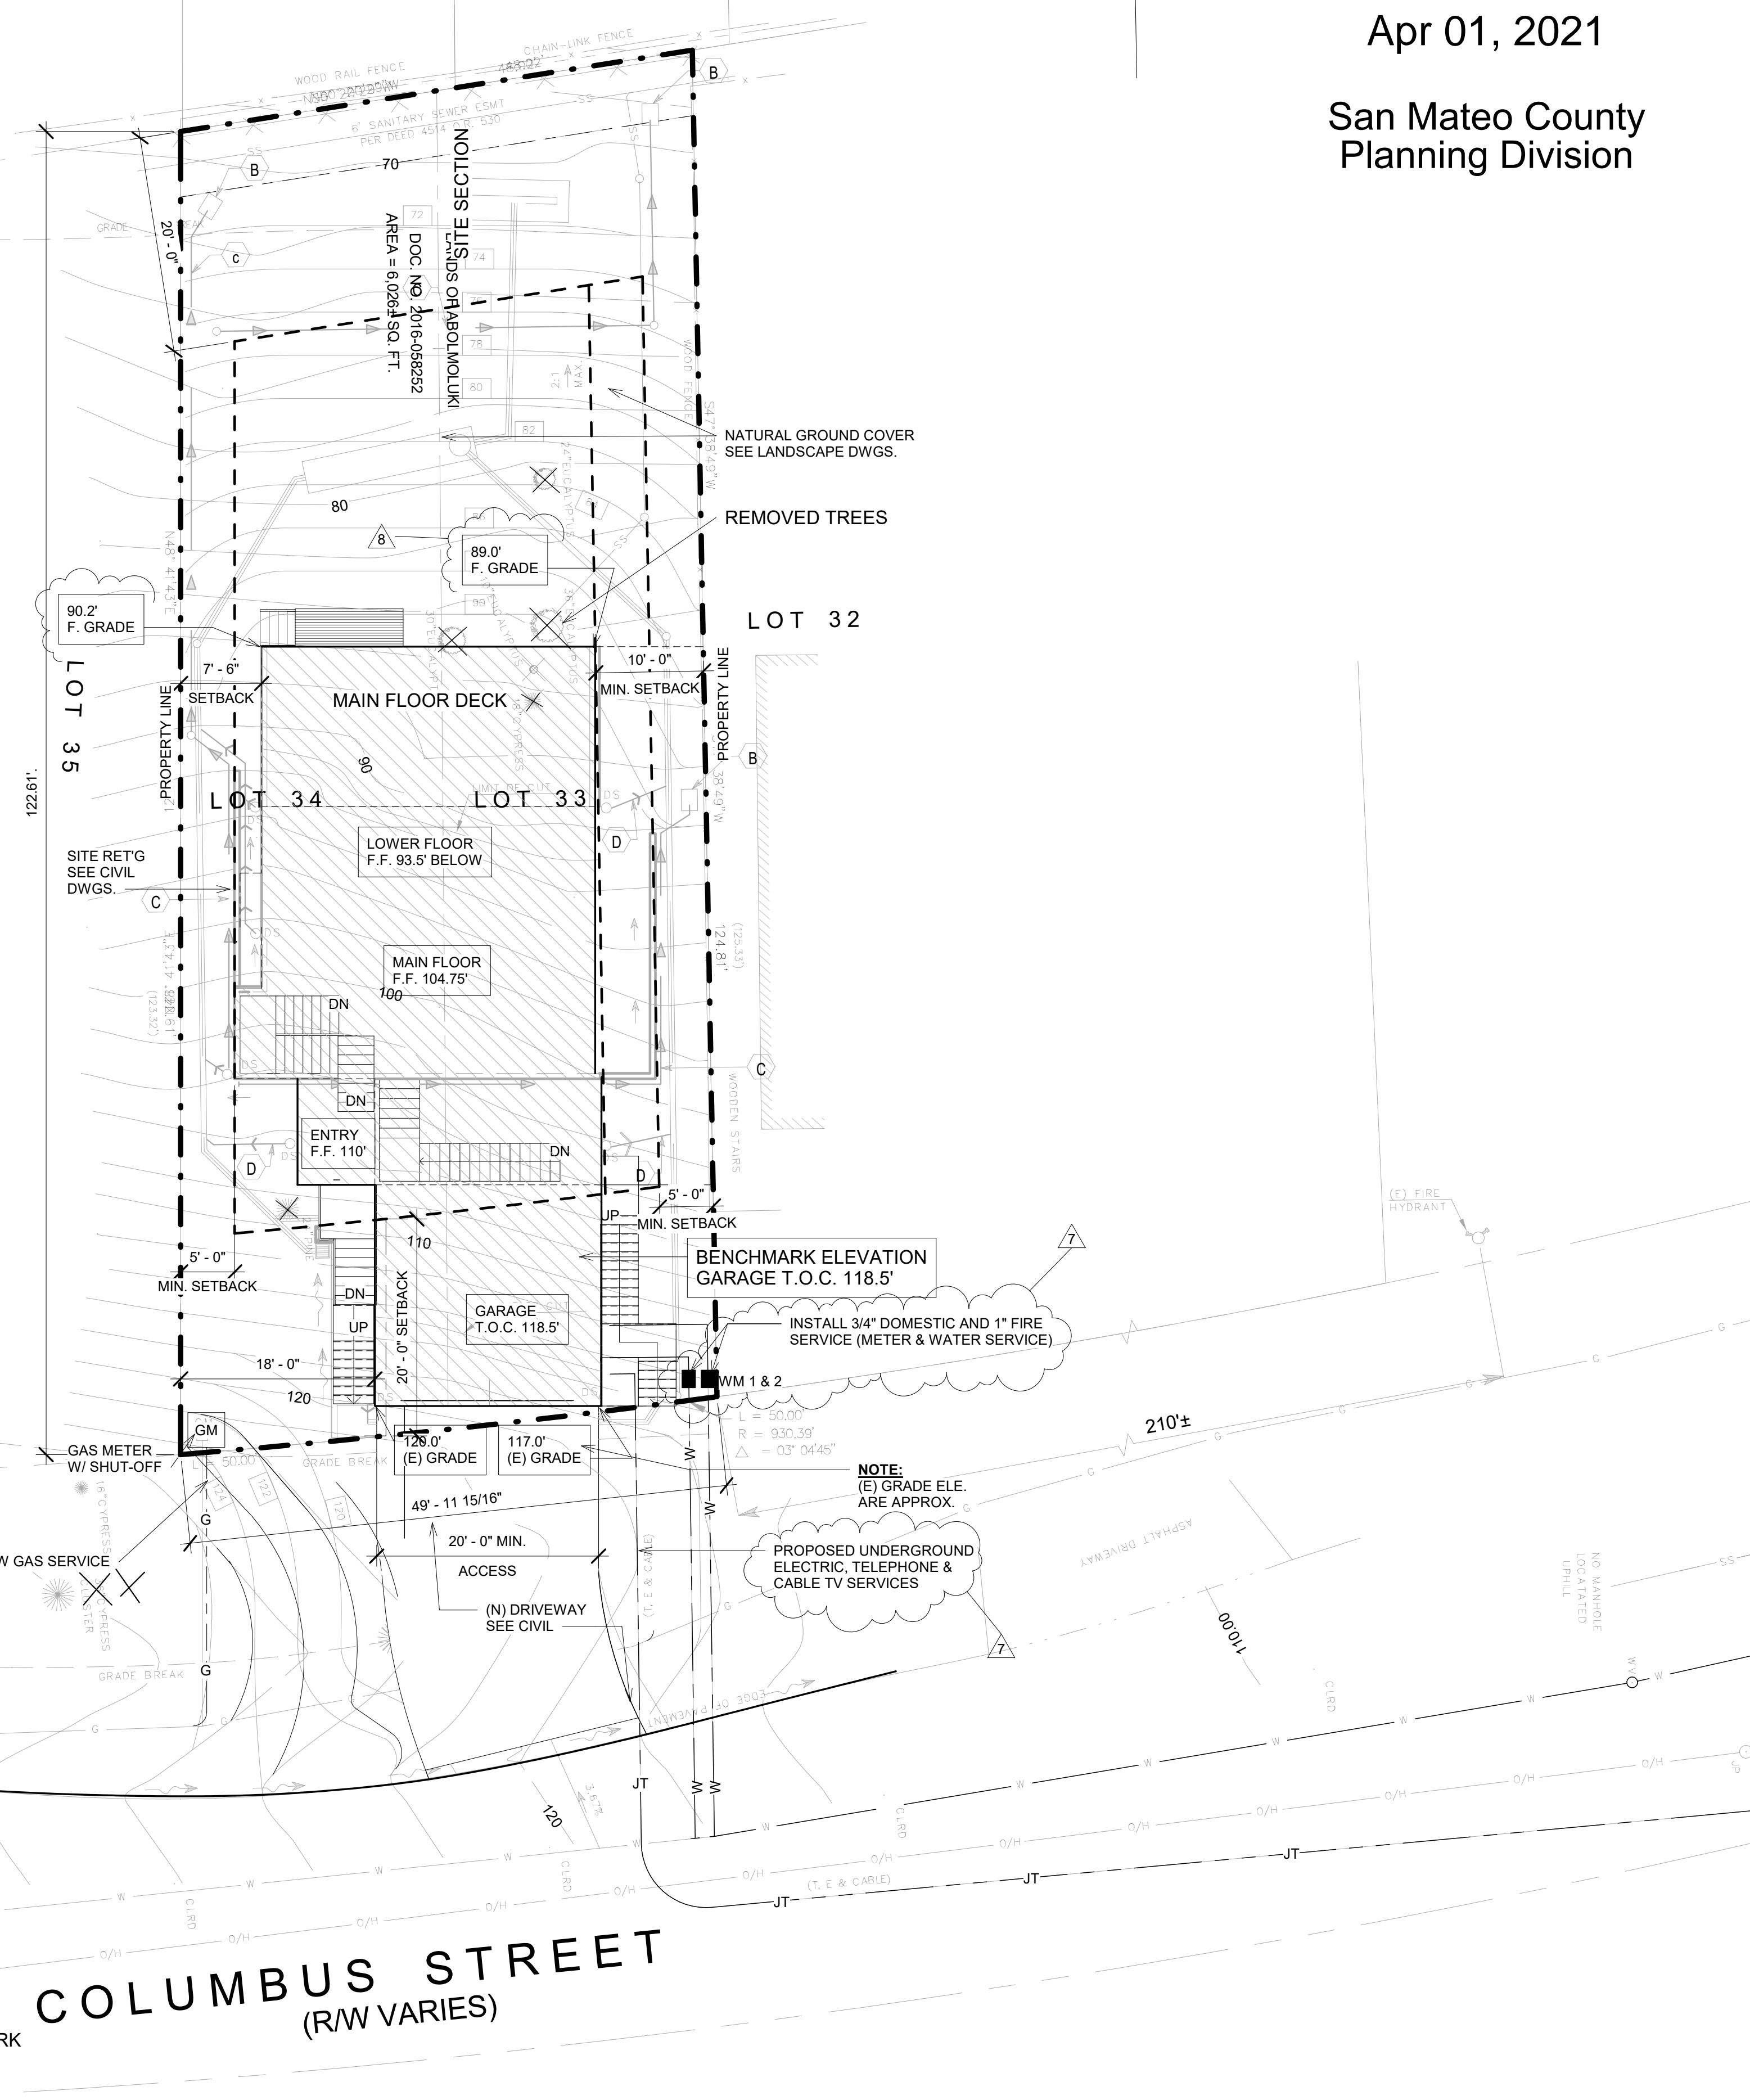

LOCATION MAP

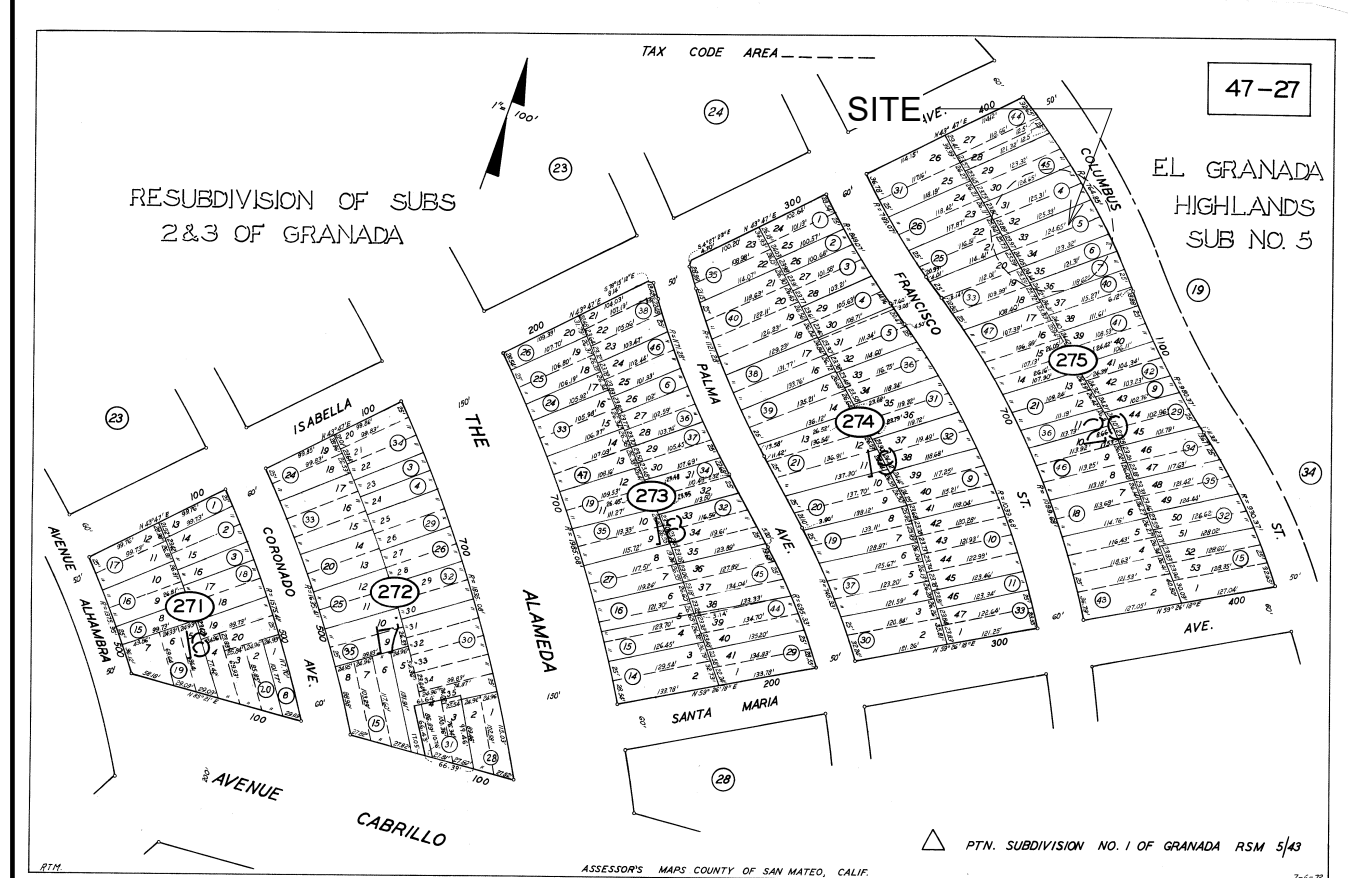

**NEW  
RESIDENCE**  
1120 COLUMBUS ST.  
EL GRANADA, CA.  
APN.047-275-050

-DESIGN REVIEW  
RESUBMITTAL-V1

SITE PLAN NOTES

1. SEE CIVIL DRAWINGS FOR ALL SITE GRADING ETC. TYPICAL.

REVISIONS	DESCRIPTION	DATE	BY
1	PLANNING RESUBMITTAL	3-2-2021	CR
2			
3			
4			
5			

DRAWING STATUS	_____
PRELIMINARY DESIGN	_____
PLANNING	_____
PC1	_____
PC2	_____
PERMIT	_____


DATE 3/5/2021 Drawing Number \_\_\_\_\_

Scale 1" = 10'-0" **A1**

Project Number AB03

PROPOSED SITE PLAN

**PLN2017-00296**

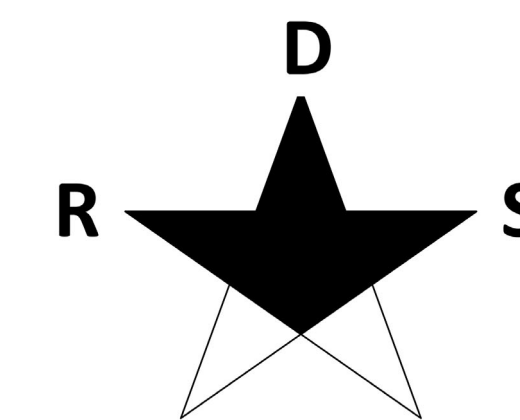

**RESIDENTIAL  
DESIGN SOLUTIONS**

406 LA JOLLA AVENUE  
SAN MATEO, CA 94403  
(650) 218-8161  
EMAIL RDS@CHRISTIANRUFFAT.COM  
WEB CHRISTIANRUFFAT.COM



**NEW  
RESIDENCE**  
1120 COLUMBUS ST.  
EL GRANADA, CA.  
APN.047-275-050

-DESIGN REVIEW  
RESUBMITTAL-V1

REVISIONS	DESCRIPTION	DATE	BY
1	PLANNING RESUBMITTAL	3-2-2021	CR
2			
3			
4			
5			


DRAWING STATUS
PRELIMINARY DESIGN
PLANNING
PC1
PC2
PERMIT

DATE 3/5/2021 Drawing Number


Scale 1/4" = 1'-0" **A2**

Project Number AB03


**NOTE:** SEE DETAILS FOR IMPERVIOUS MOISTURE BARRIER INFO. CONTRACTOR SHALL PROVIDE CONSTRUCTION DOCUMENTATION FOR ALL ELEMENTS OF THE IMPERVIOUS BARRIER SYSTEM AND SHALL BE INSTALLED AS PER MANUFACTURER'S RECOMMENDATIONS.

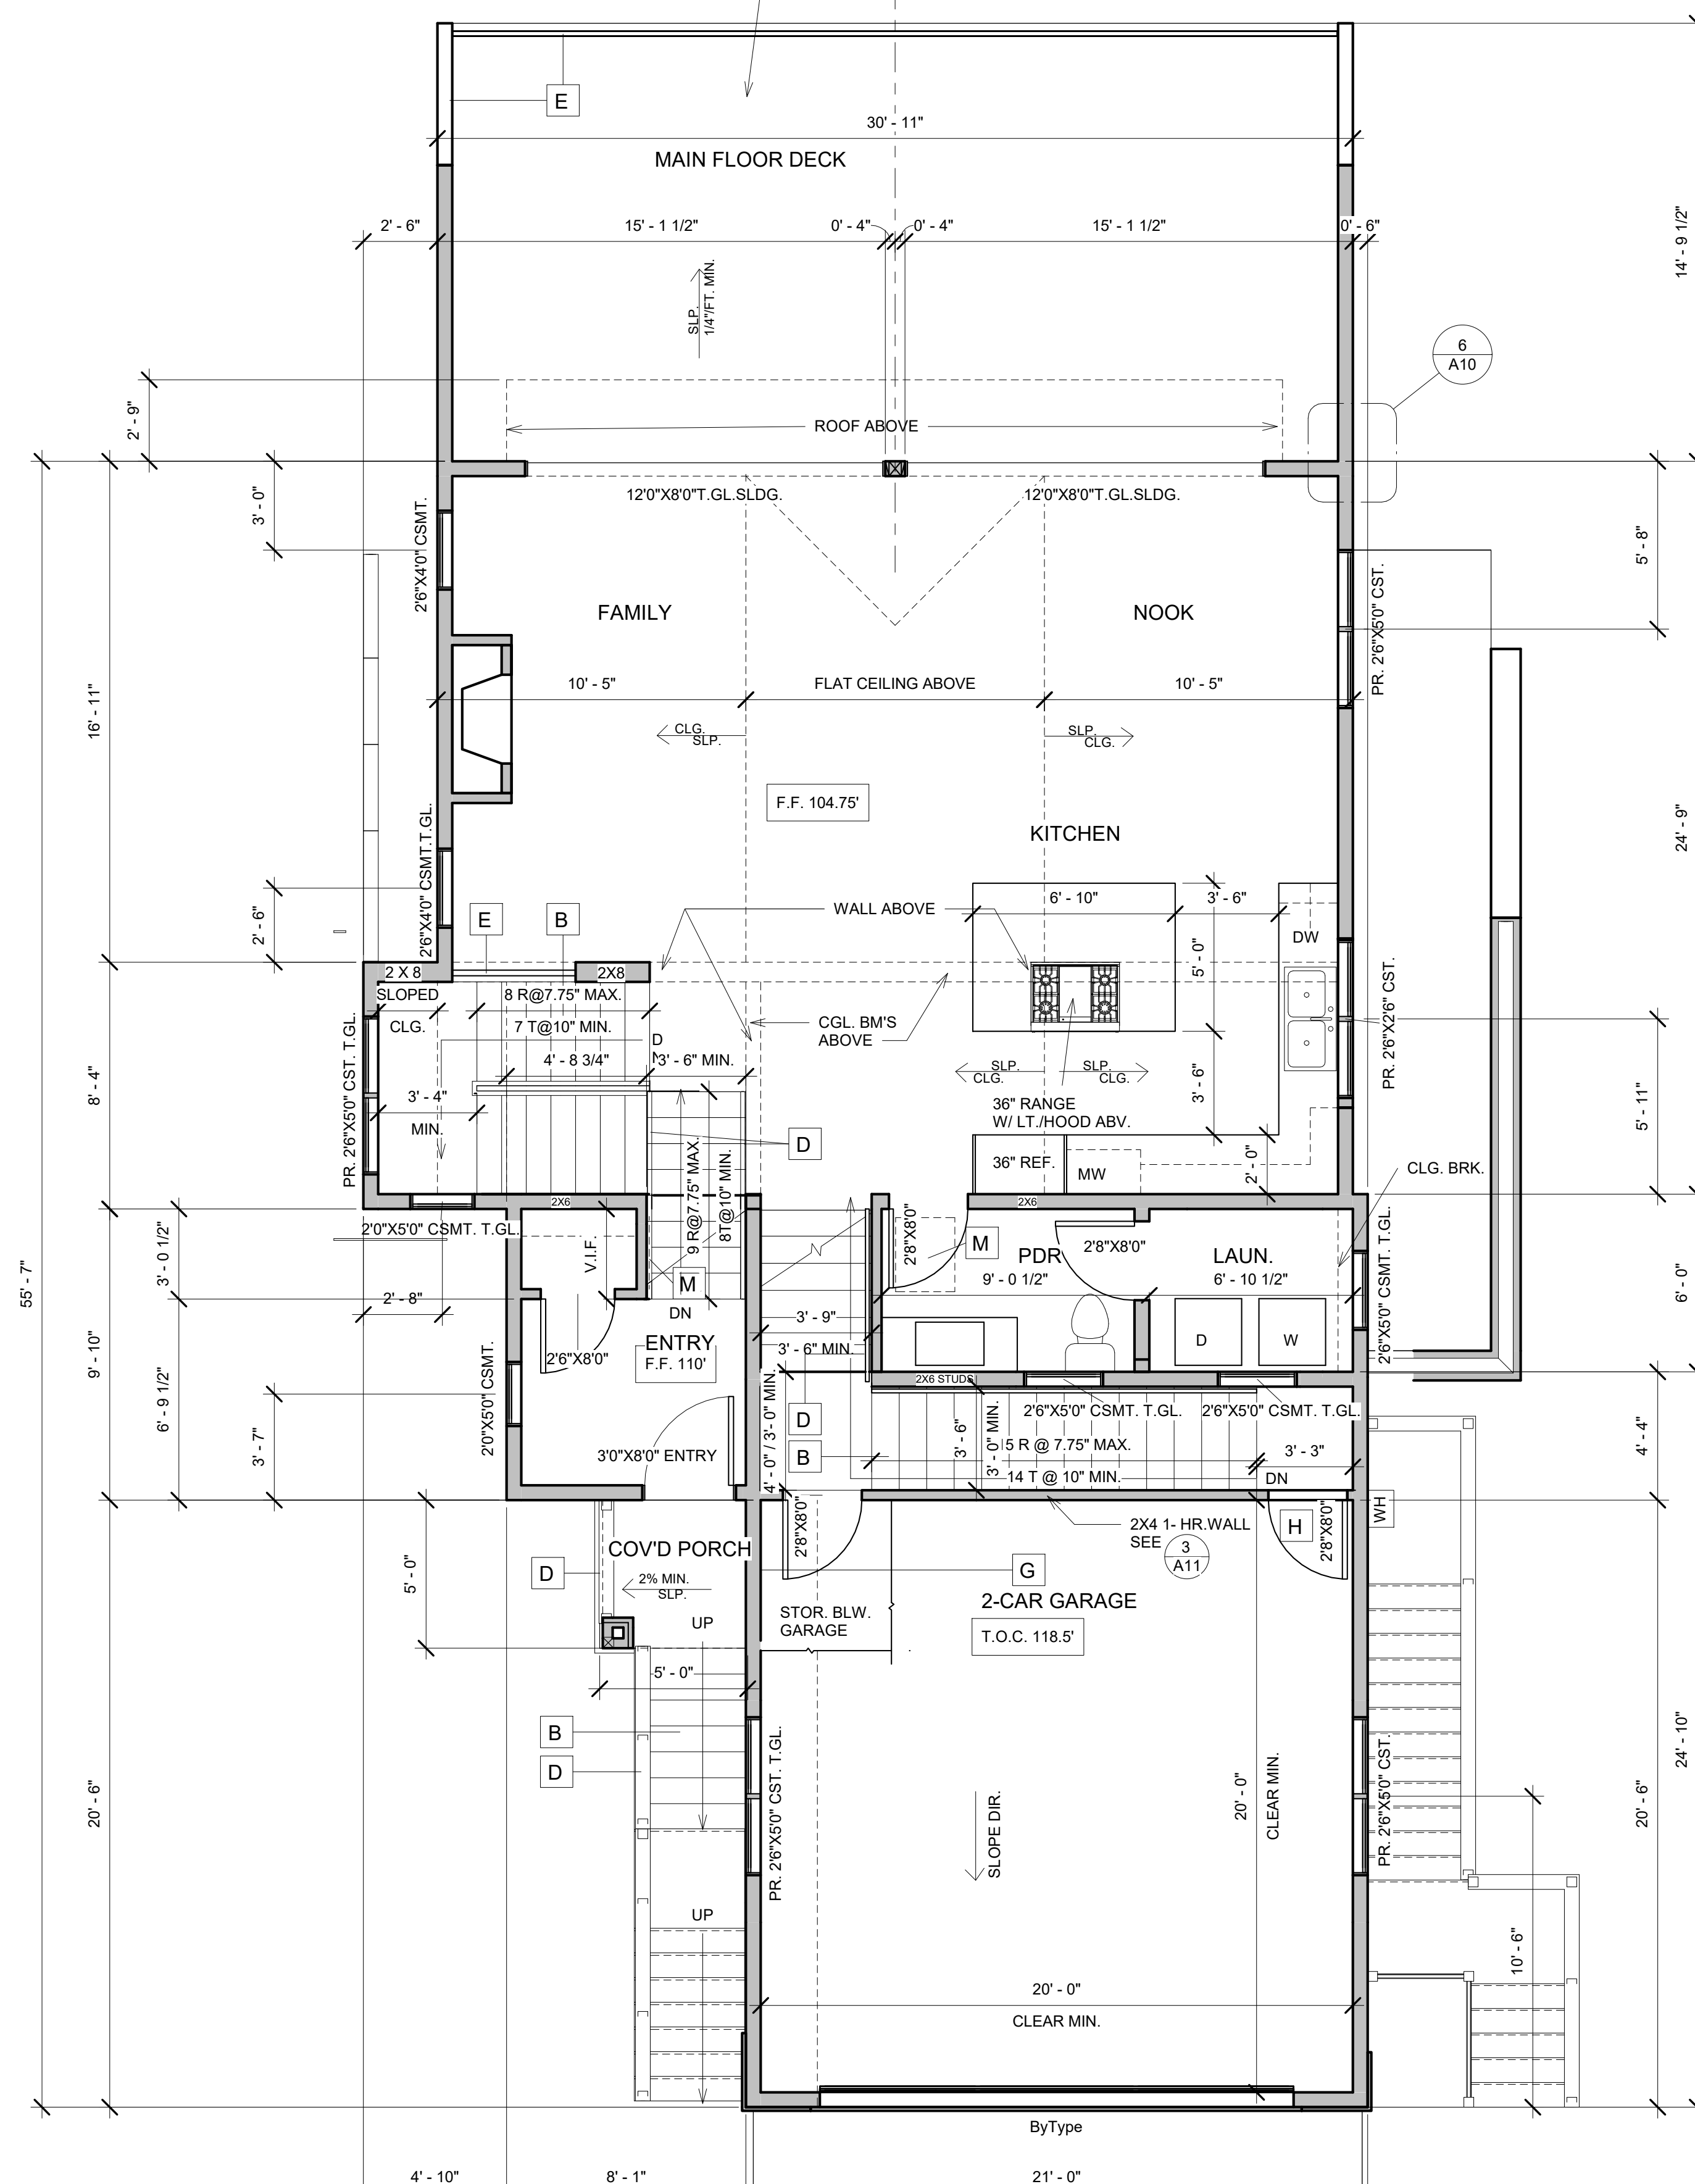

**1 MAIN FLOOR PLAN-AS BUILT**  
SCALE: 1/4" = 1'-0"

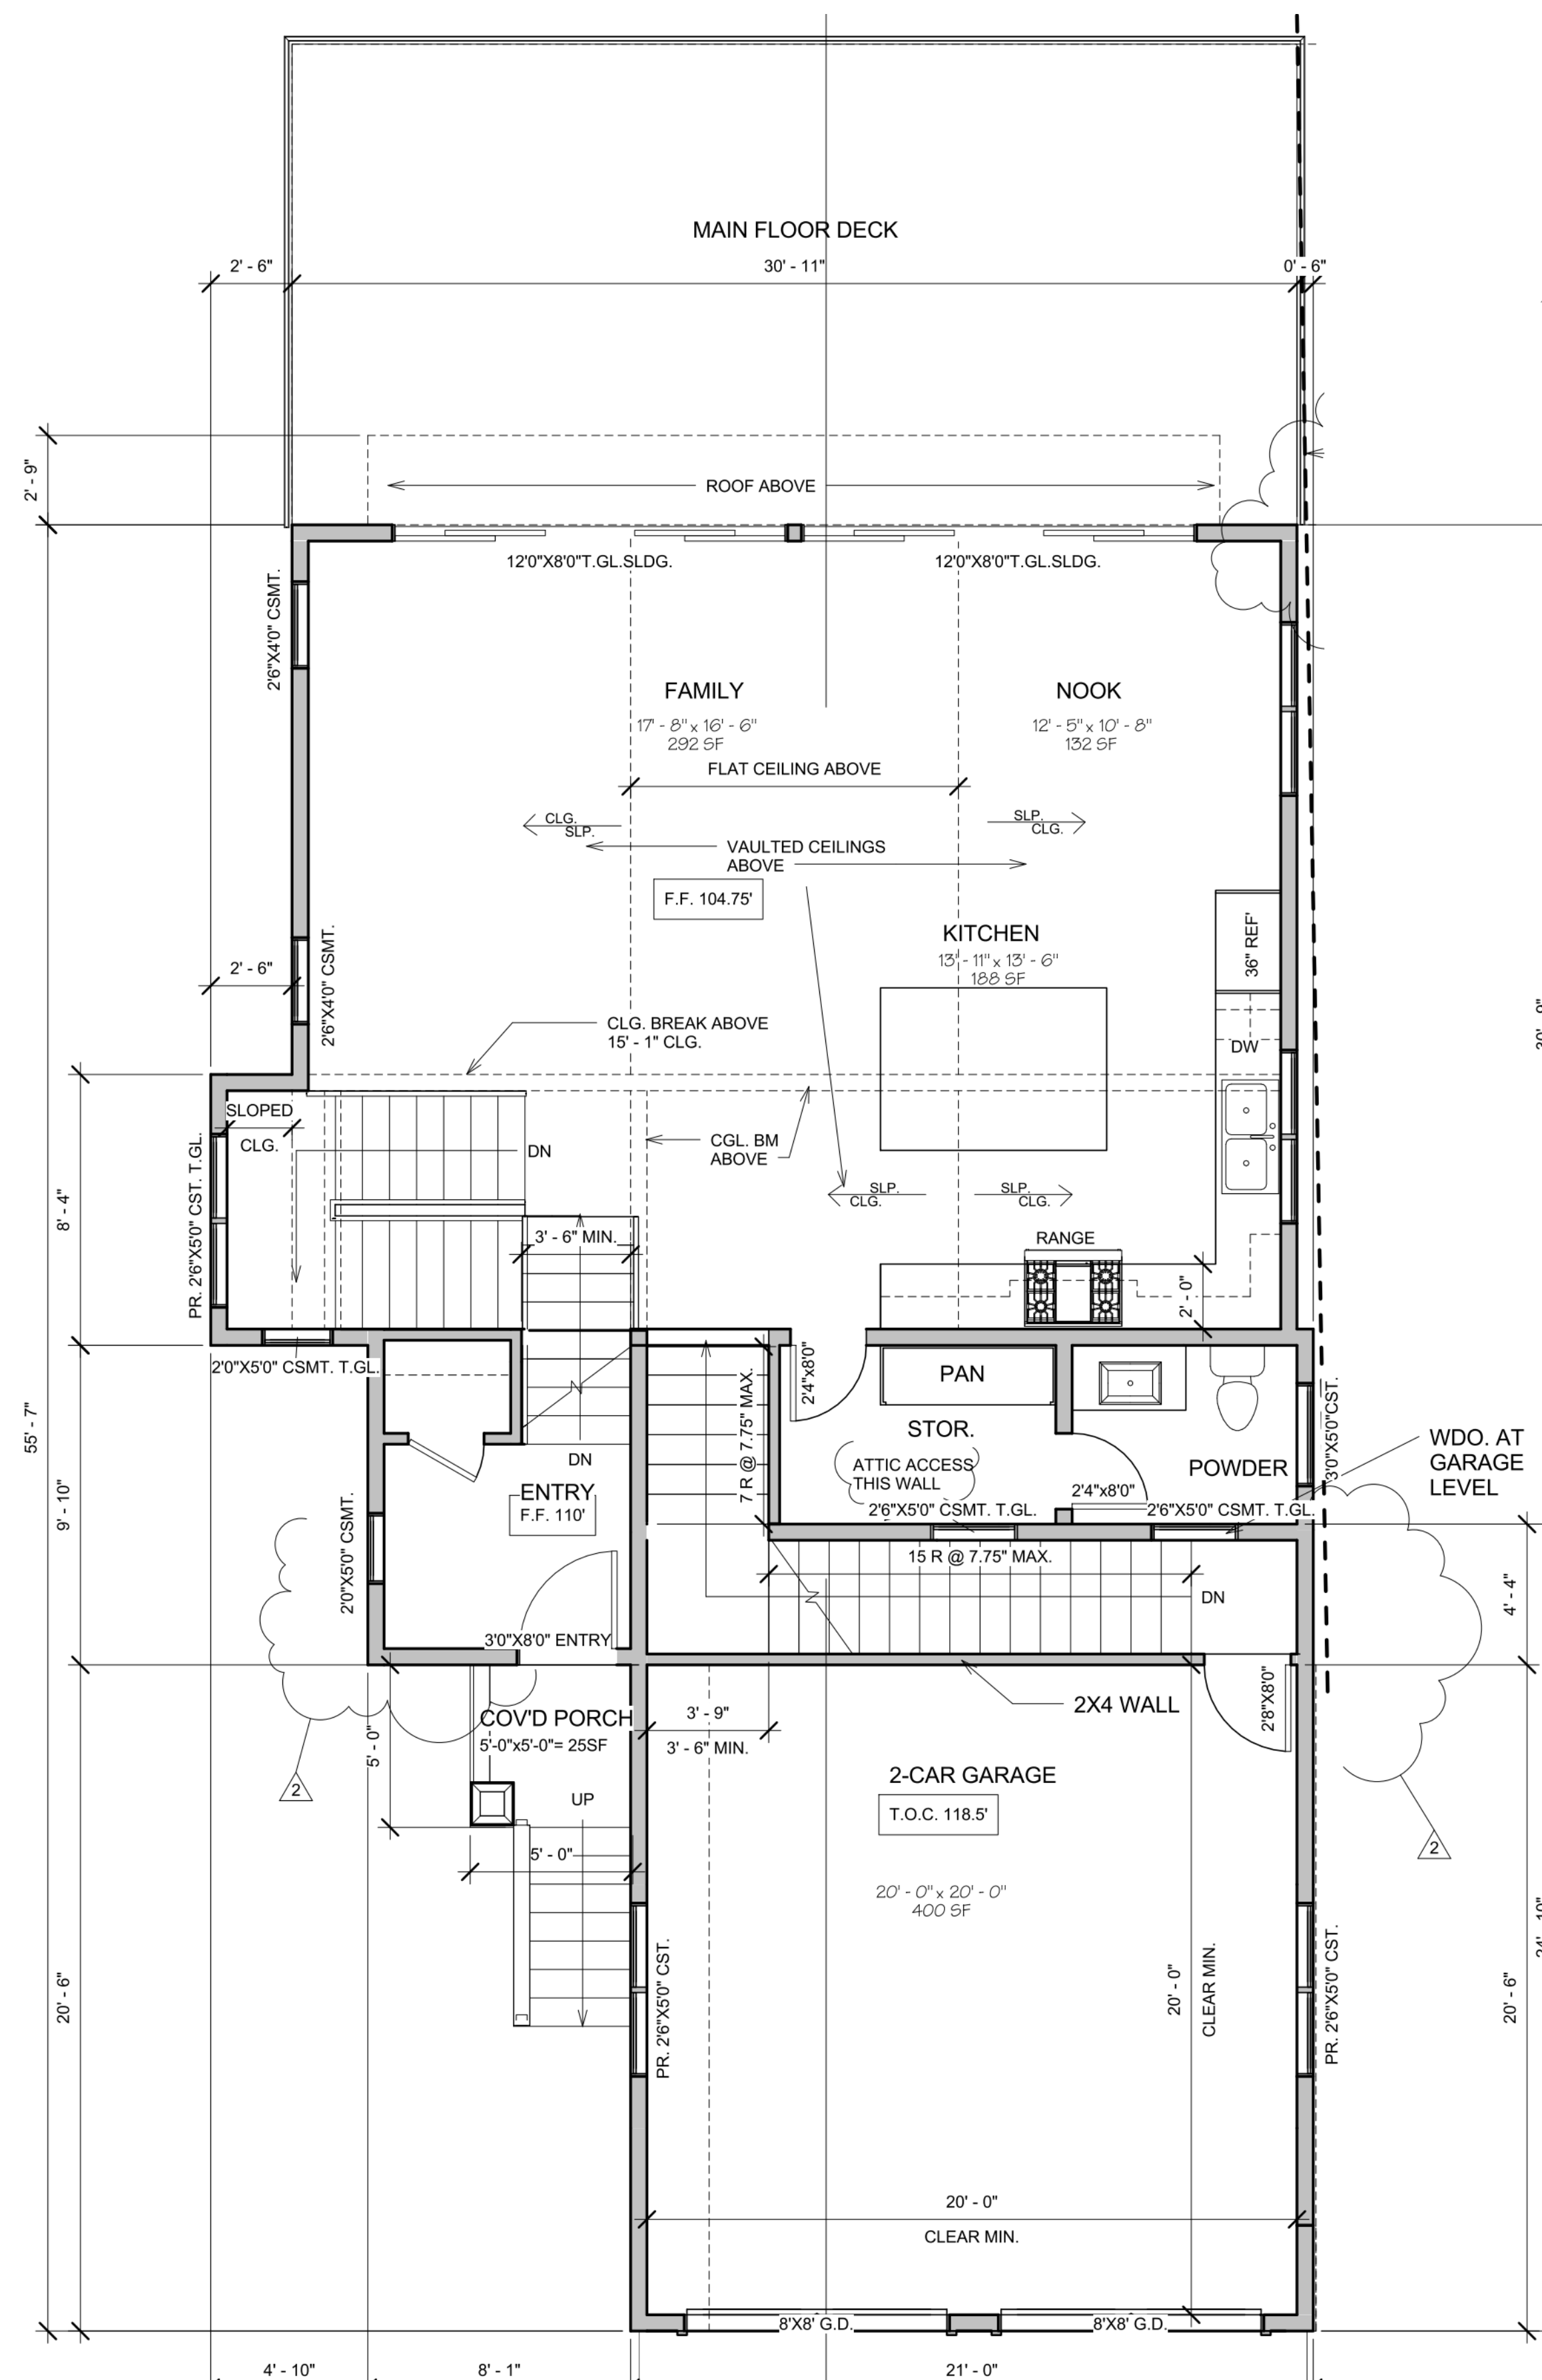


**2 MAIN FLOOR PLAN-APPROVED**  
SCALE: 1/4" = 1'-0"

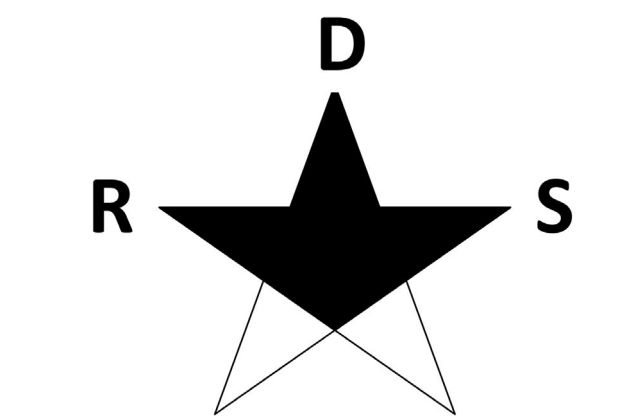

**RESIDENTIAL  
DESIGN SOLUTIONS**

406 LA JOLLA AVENUE  
SAN MATEO, CA 94403  
(650) 218-8161  
EMAIL RDS@CHRISTIANRUFFAT.COM  
WEB CHRISTIANRUFFAT.COM

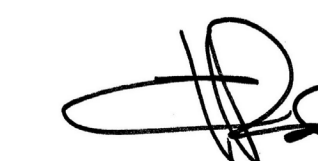

**NEW  
RESIDENCE**  
1120 COLUMBUS ST.  
EL GRANADA, CA.  
APN.047-275-050

**-DESIGN REVIEW  
RESUBMITTAL-V1**


REVISIONS	DESCRIPTION	DATE	BY
1	PLANNING RESUBMITTAL	3-2-2021	CR
2			
3			
4			
5			

DRAWING STATUS
PRELIMINARY DESIGN
PLANNING
PC1
PC2
PERMIT


DATE 3/5/2021 Drawing Number

Scale 1/4" = 1'-0" **A3**


Project Number AB03

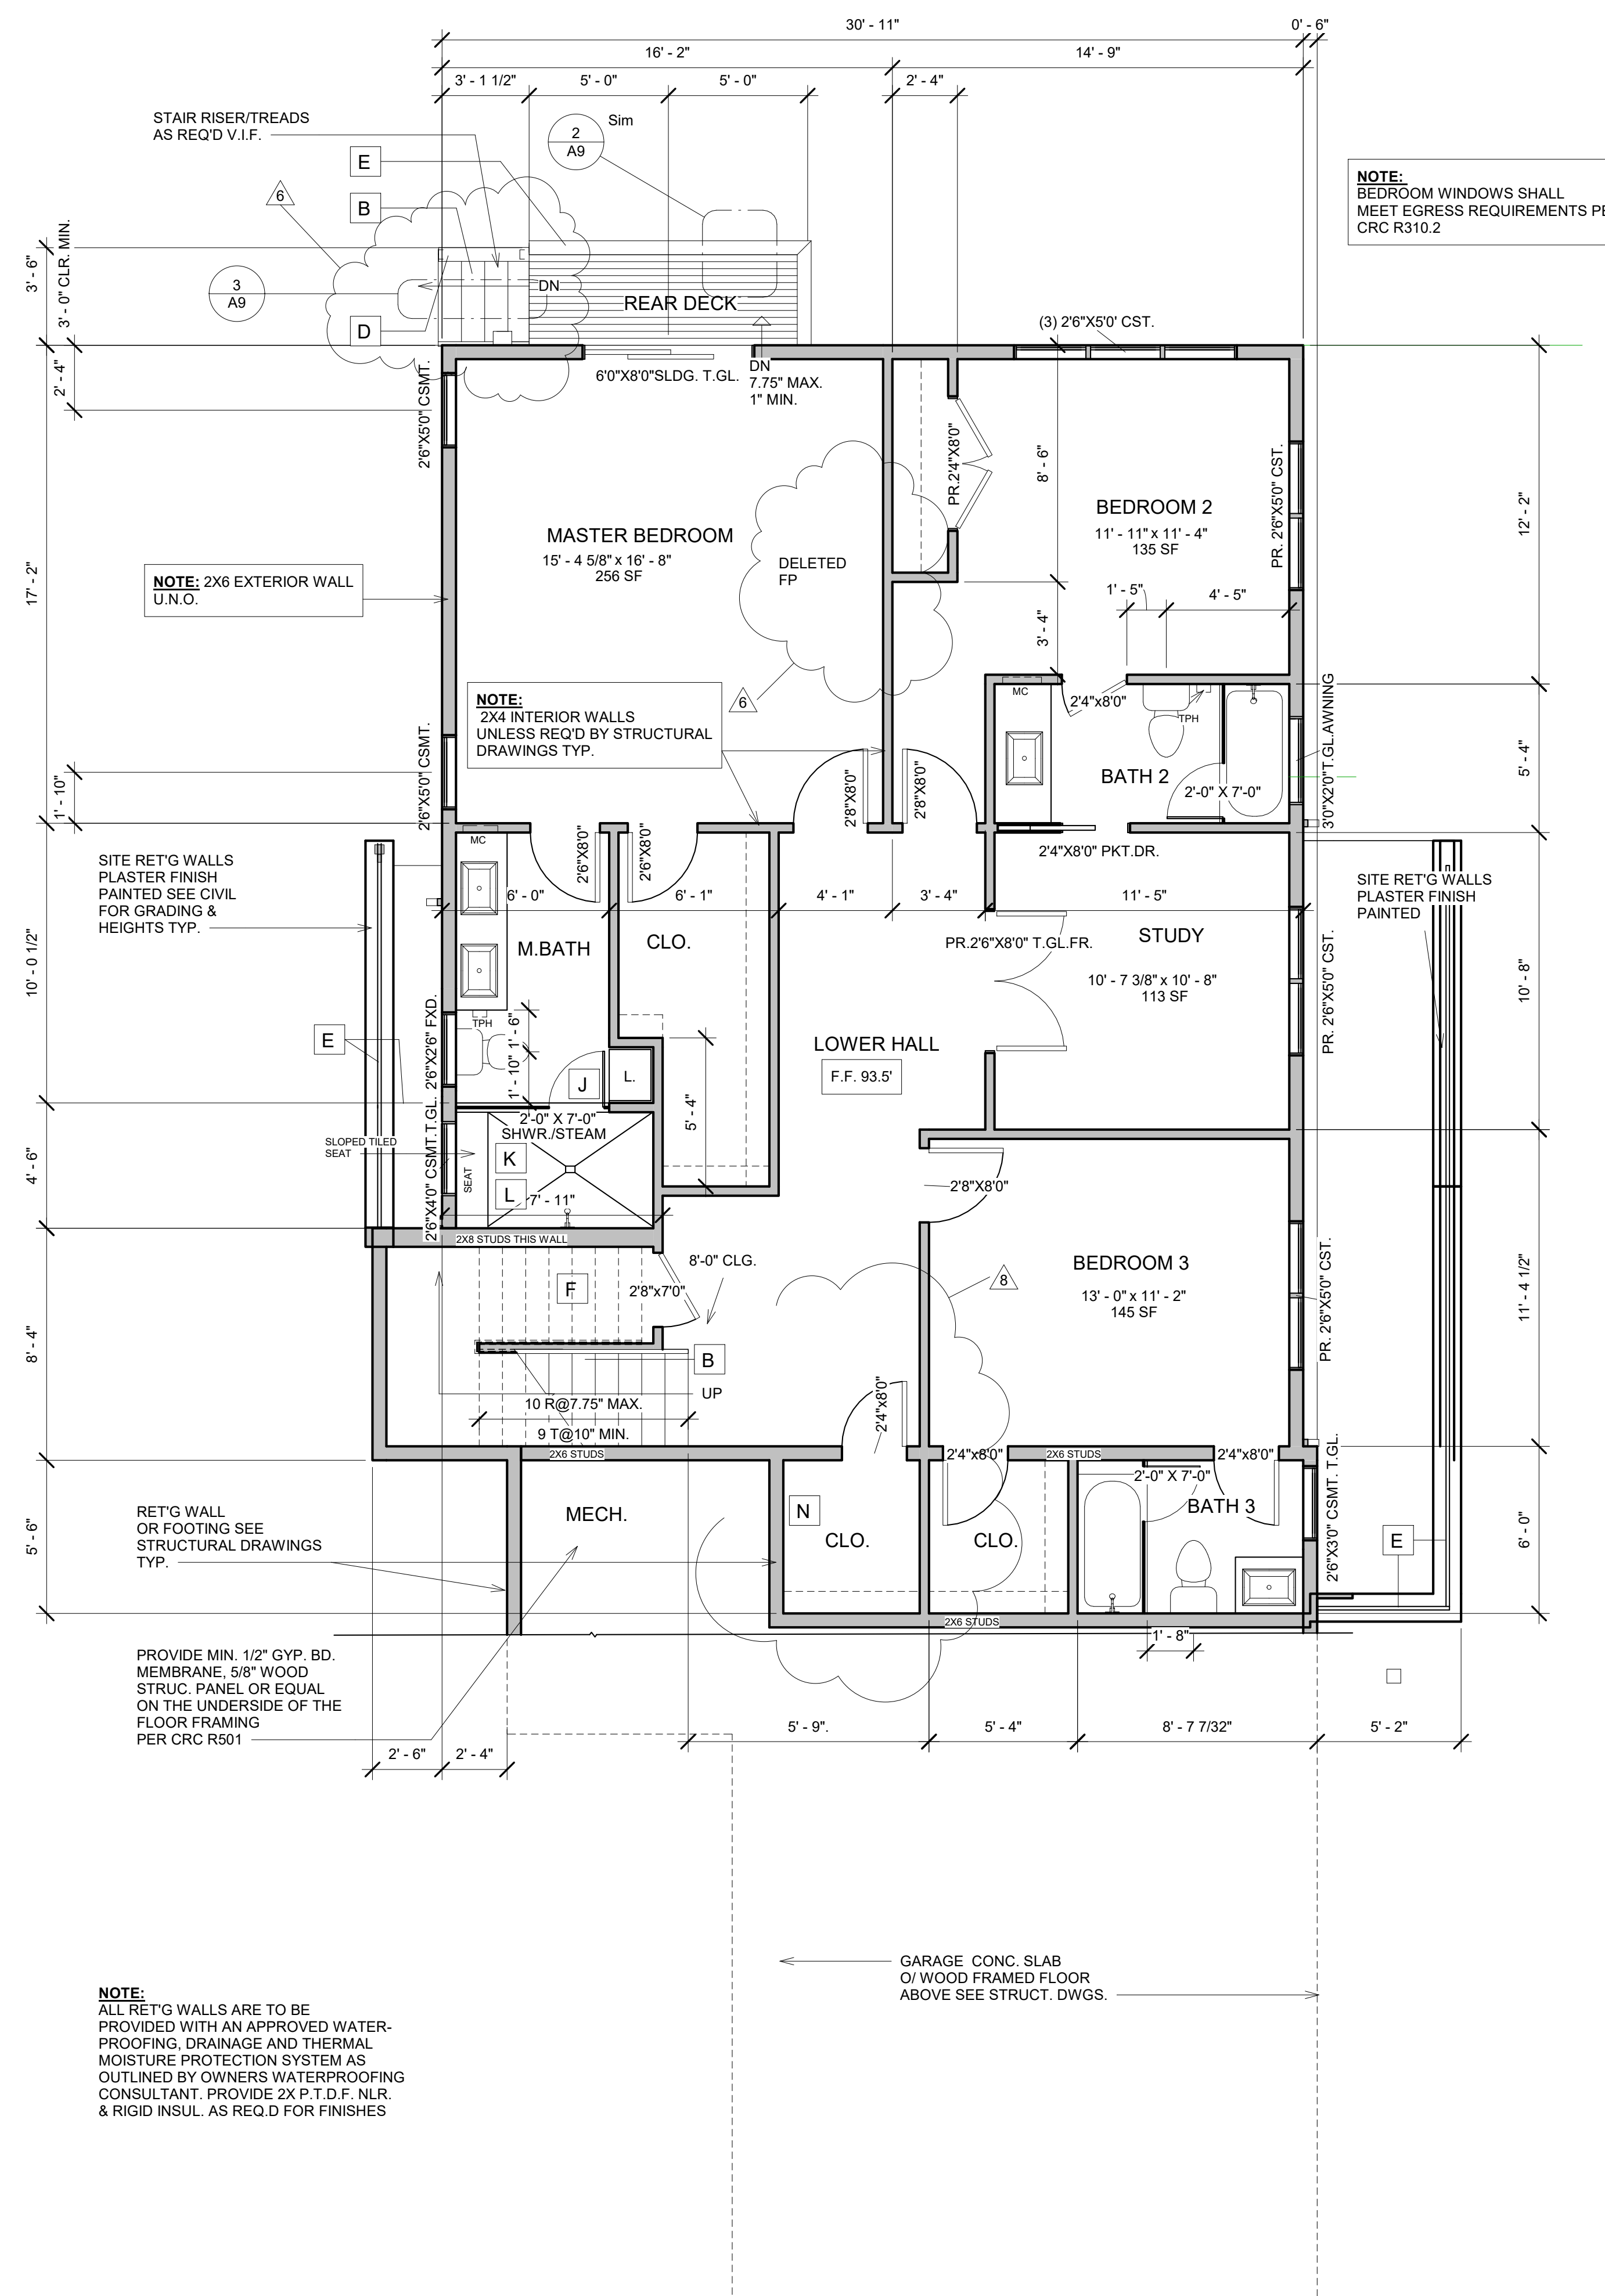

**1 LOWER LEVEL-AS BUILT**  
SCALE: 1/4" = 1'-0"

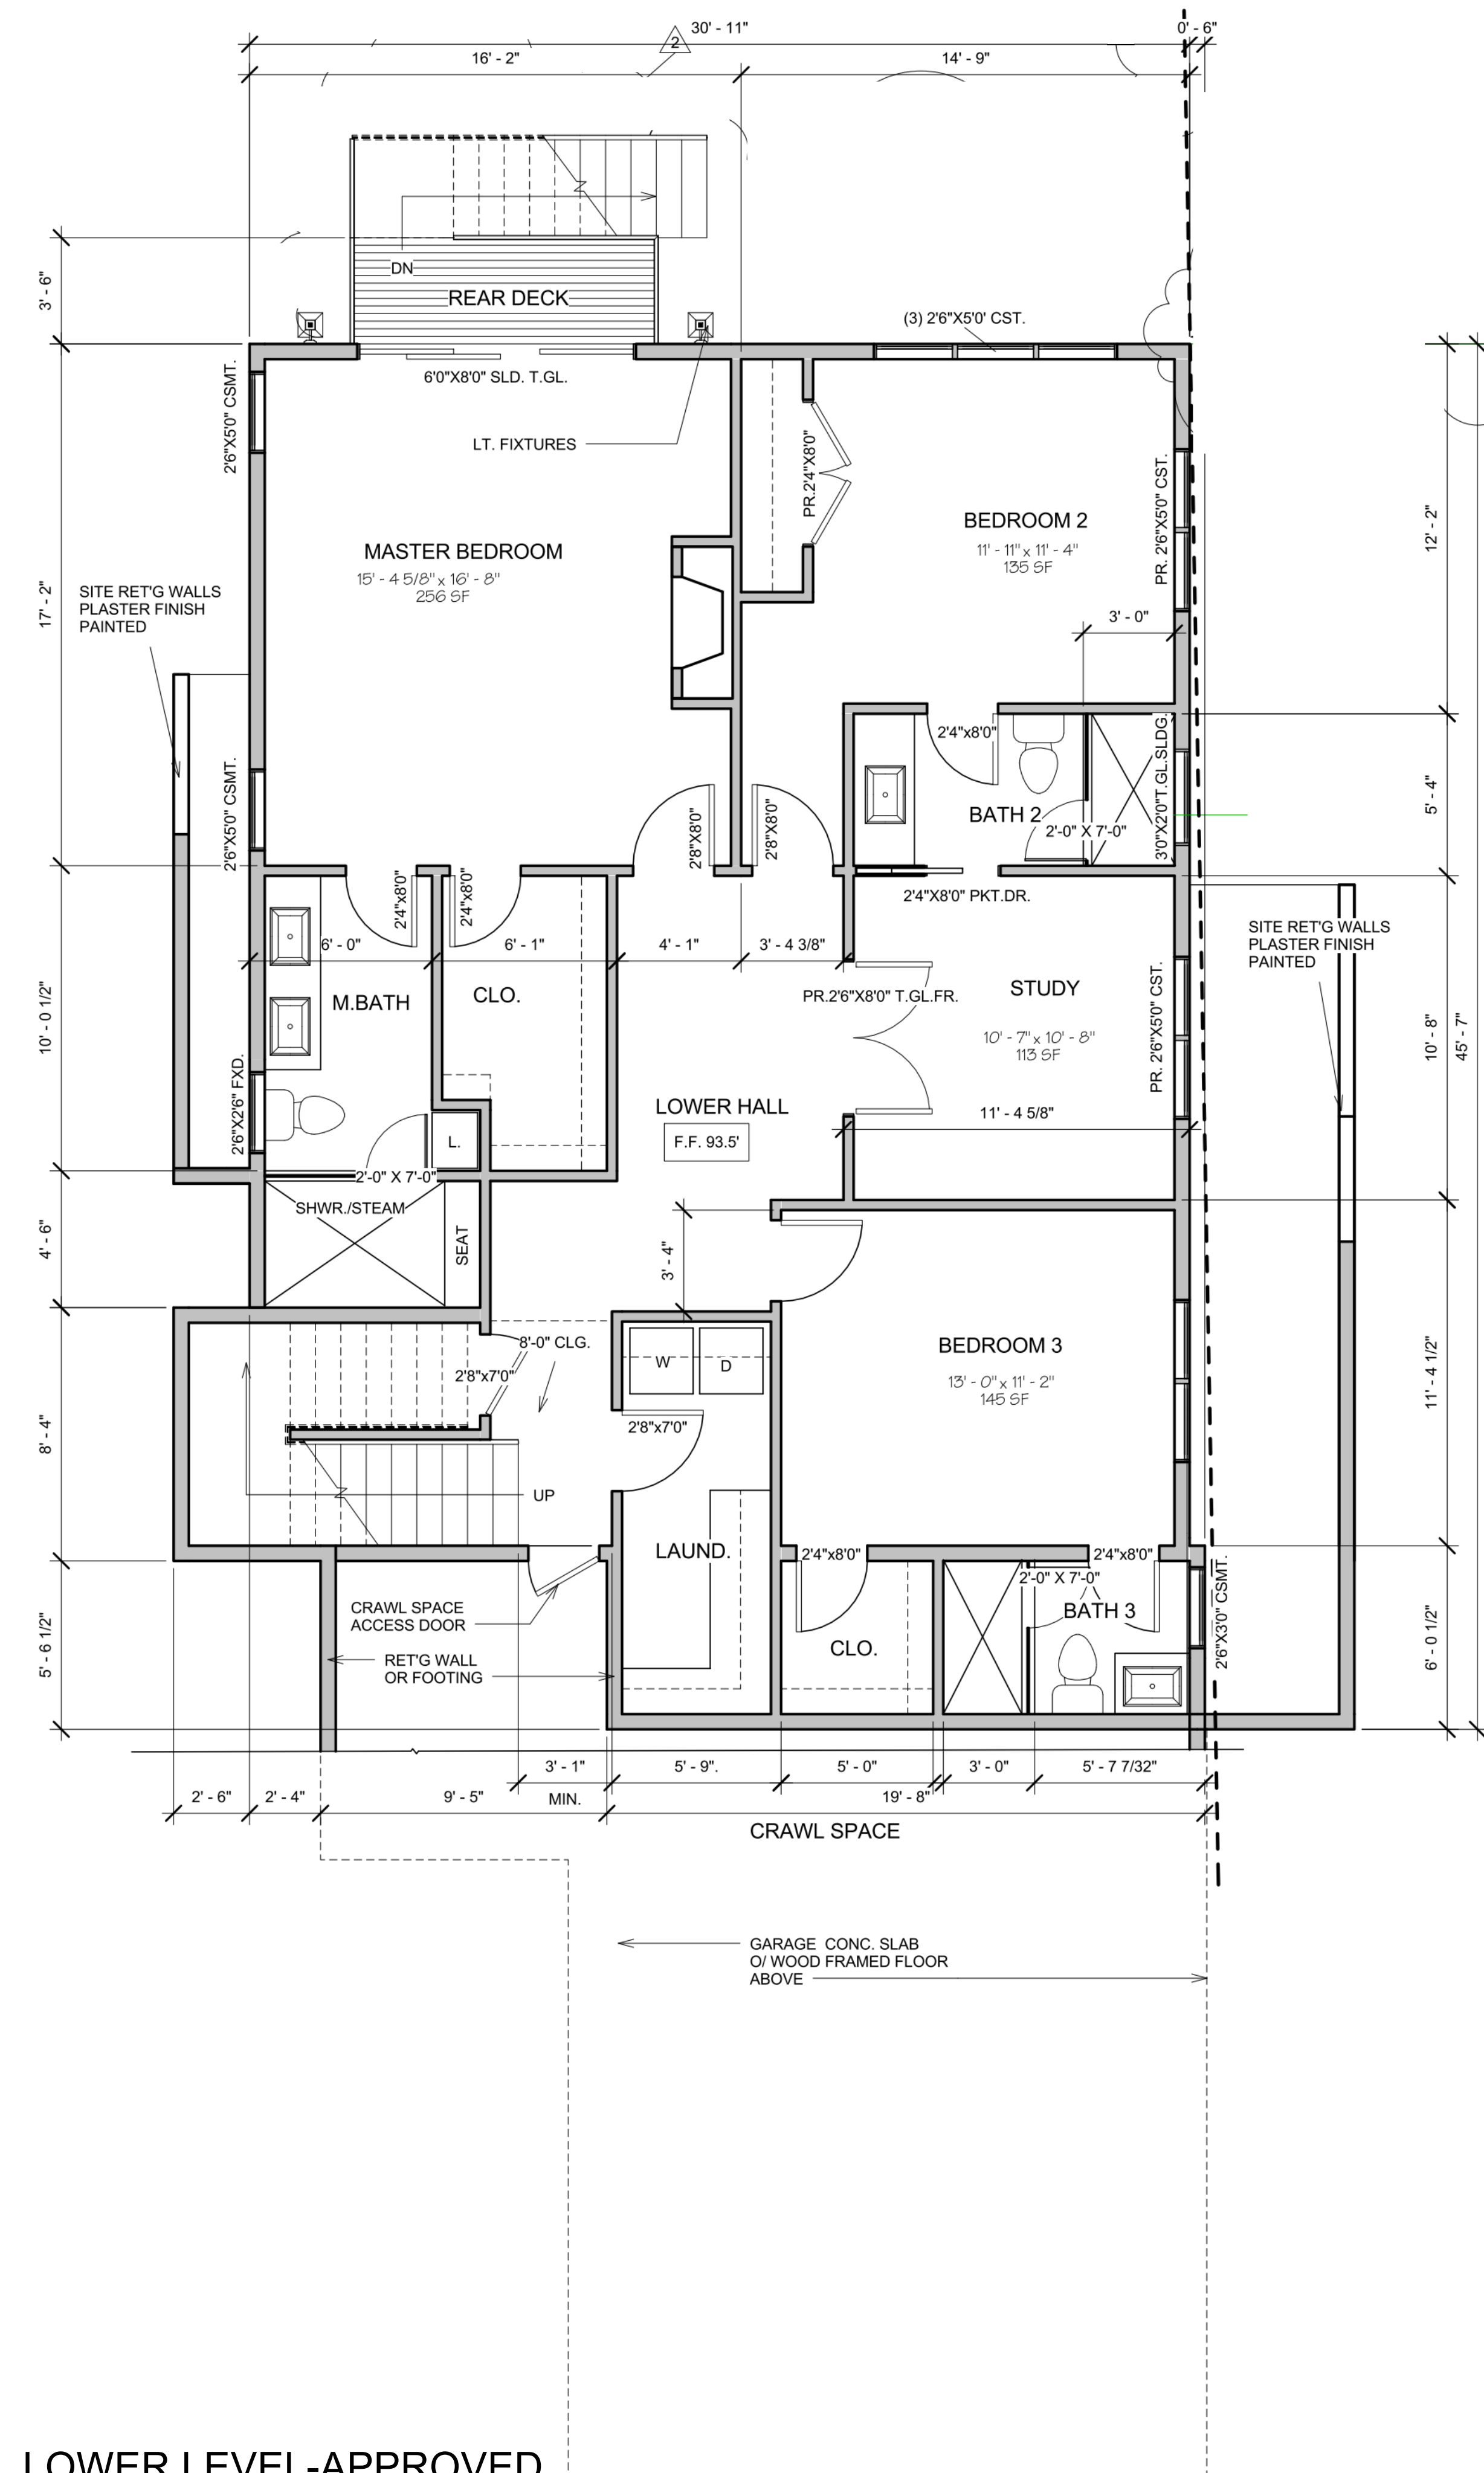

**2 LOWER LEVEL-APPROVED**  
SCALE: 1/4" = 1'-0"

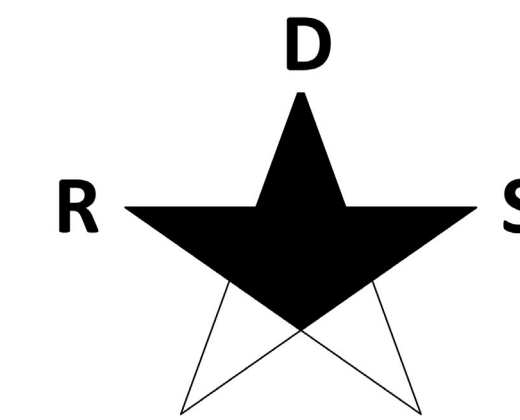

**RESIDENTIAL  
DESIGN SOLUTIONS**

406 LA JOLLA AVENUE  
SAN MATEO, CA 94403  
(650) 218-8161  
EMAIL RDS@CHRISTIANRUFFAT.COM  
WEB CHRISTIANRUFFAT.COM



**NEW  
RESIDENCE**  
1120 COLUMBUS ST.  
EL GRANADA, CA.  
APN.047-275-050

-DESIGN REVIEW  
RESUBMITTAL-V1

REVISIONS	DESCRIPTION	DATE	BY
1	PLANNING RESUBMITTAL	3-2-2021	CR
2			
3			
4			
5			



DRAWING STATUS
PRELIMINARY DESIGN
PLANNING
PC1
PC2
PERMIT


DATE 3/5/2021 Drawing Number

Scale  
1/4" = 1'-0"

**A4**

Project Number  
AB03

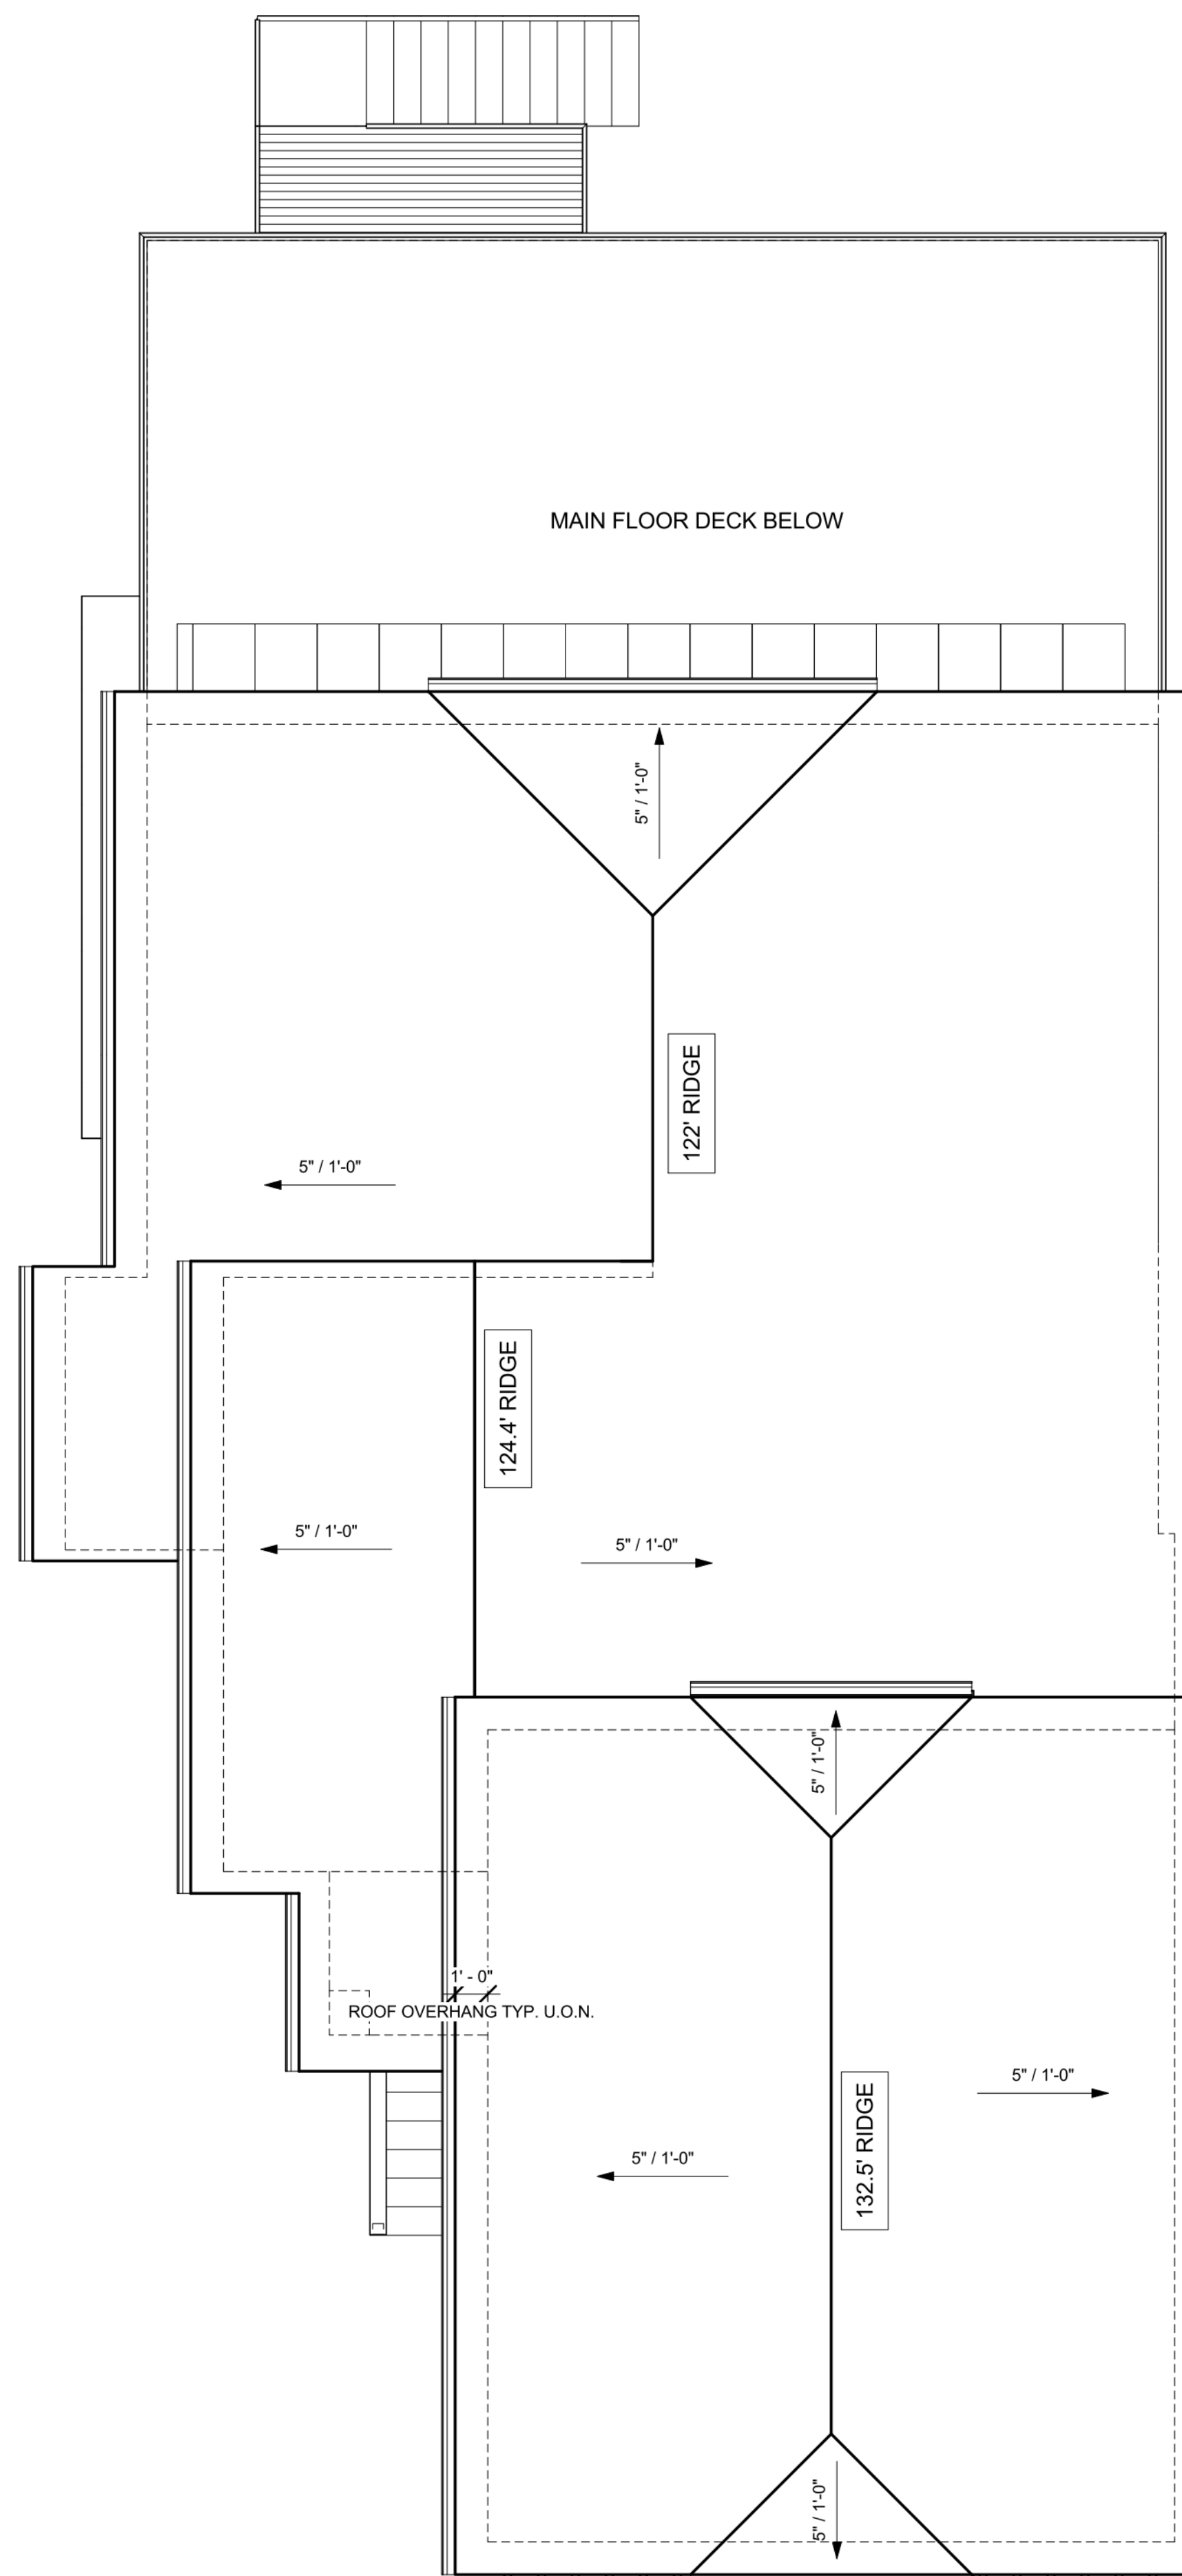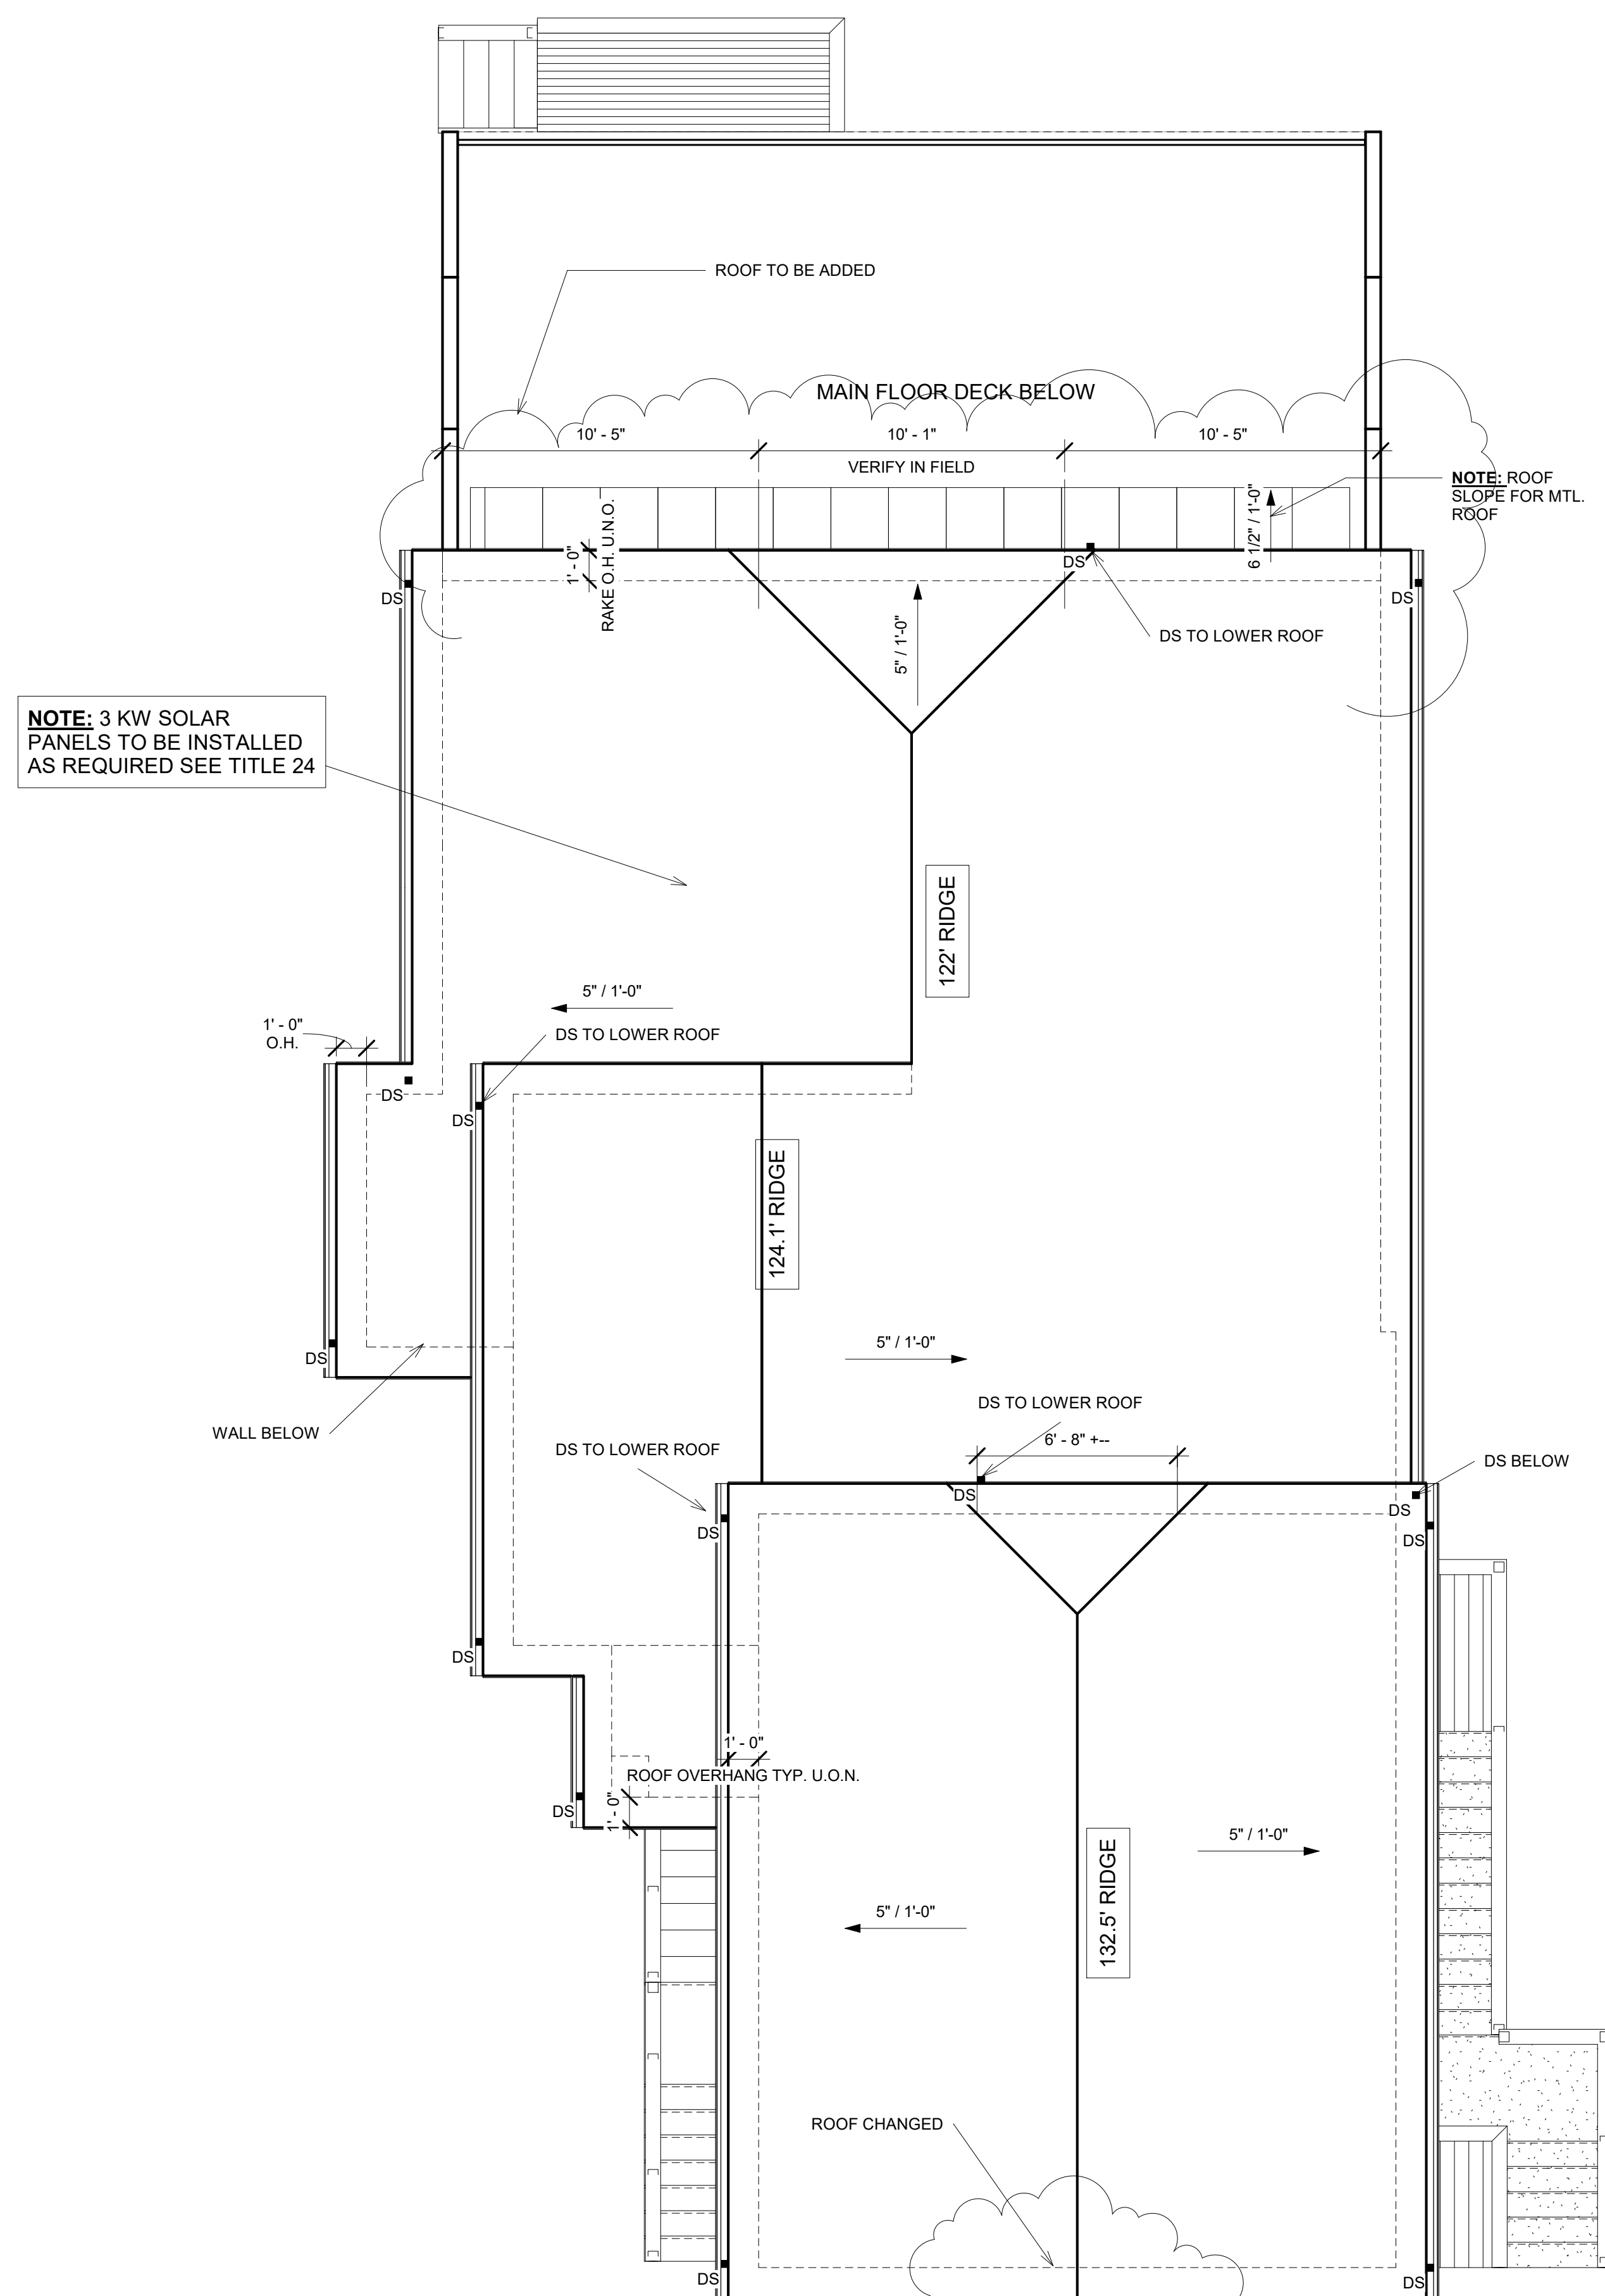

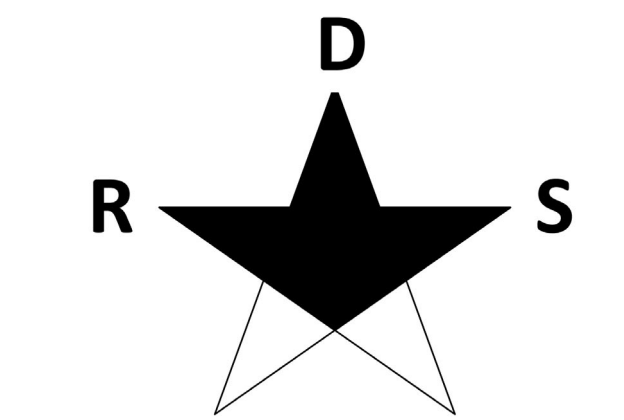

# RESIDENTIAL DESIGN SOLUTIONS

406 LA JOLLA AVENUE  
SAN MATEO, CA 94403  
(650) 218-8161


EMAIL RDS@CHRISTIANRUFFAT.COM  
WEB CHRISTIANRUFFAT.COM



## URBAN - model: WS-W11 LED Outdoor Sconce Luminaire



Fixture Type: BRONZE  
Catalog Number: [ ]  
Project: ABOLMOLUKI RESIDENCE  
Location: EL GRANADA

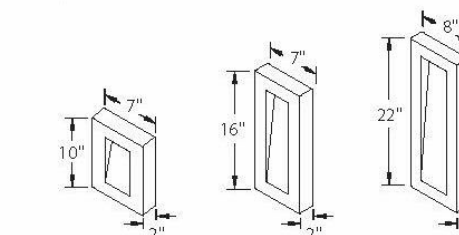

### PRODUCT DESCRIPTION

Like urban renewal, the Urban sconce gives new life to the conventional step baffle. Form follows function in this simplified indirect wall sconce. Clean styling and robust LED performance are combined in this modern, dark sky luminaire.

### FEATURES

- ETL & cETL listed for wet locations: IP66
- Interior light and down light
- Low profile design
- Replaceable LED module
- 277V option available (special order)
- 50,000 hour potential life
- Color Temp: 3000K
- CRI: 85

### SPECIFICATIONS

- Construction:** Aluminum
- Power:** No driver or transformer required.
- Light Source:** High output LED.
- Dimming:** Dims to 10% with an electronic low voltage (ELV) dimmer.
- Mounting:** Mounts directly to junction box.
- Finish:** Black (BK), Bronze (BZ), Graphite (GH), White (WT).
- Standards:** ETL & cETL listed, ADA compliant, Dark Sky friendly, IP66, Wet location.

### ORDER NUMBER

Model	Height	Watt	# of LEDs	LED Lumens	Photometric Lumens	Finish
WS-W11	10"	12W	3	220	370	BK
	16"	36W	6	660	490	BZ
	22"	20W	5	300	410	WT

### REPLACEMENT GLASS

Model	Fixture	Description
RPL-GLA-1110-01	WS-W1110	Top Lens
RPL-GLA-1110-02		Bottom Lens
RPL-GLA-1116-01	WS-W1116	Top Lens
RPL-GLA-1116-02		Bottom Lens
RPL-GLA-1122-01	WS-W1122	Top Lens
RPL-GLA-1122-02		Bottom Lens

### Back Plate Dimensions:

Model	Dimension
WS-W1110	10"L x 7"W x 2"H
WS-W1116	16"L x 7"W x 2"H
WS-W1122	22"L x 8"W x 2"H

modernforms.com  
Phone (800) 526-2588  
Fax: (800) 526-2585

Headquarters/Eastern Distribution Center  
44 Harbor Park Drive  
Port Washington, NY 11050

Central Distribution Center  
1600 Distribution Ct.  
Urbia Springs, GA 30122

Western Distribution Center  
1750 Archibald Avenue  
Ontario, CA 91760

WAC Lighting retains the right to modify the design of our products at any time as part of the company's continuous improvement program. AUG 2015

## 3 LIGHT FIXTURE CUT SHEET

Capital Lighting - 9092RI-GD - Outdoor Dark Sky-Energy Saver One Light Wall Lantern in Mediterranean Bronze  
SKU#: 9092RI-GD  
Availability: In Stock



Capital Lighting - 9092RI-GD - Outdoor Dark Sky-Energy Saver One Light Wall Lantern in Mediterranean Bronze

Retail Price: \$145.00  
Your Savings: \$29.00  
Your Price: \$116.00

Quantity: 1

### Features:


- Wall lantern
- Outdoor collection
- Mediterranean Bronze finish
- Acid washed glass lens shade
- Traditional style
- UL listed for wet locations
- Dark sky
- Energy saver
- Eco friendly

### Specifications:

- Accommodates (1) 18W GU24 fluorescent base bulb (included)
- Backplate dimensions: 7.64" H x 5.71" W x 1.1" D
- Overall dimensions: 8.25" H x 10" W x 11" D


## 1 FRONT ELEVATION-AS BUILT

SCALE: 1/4" = 1'-0"

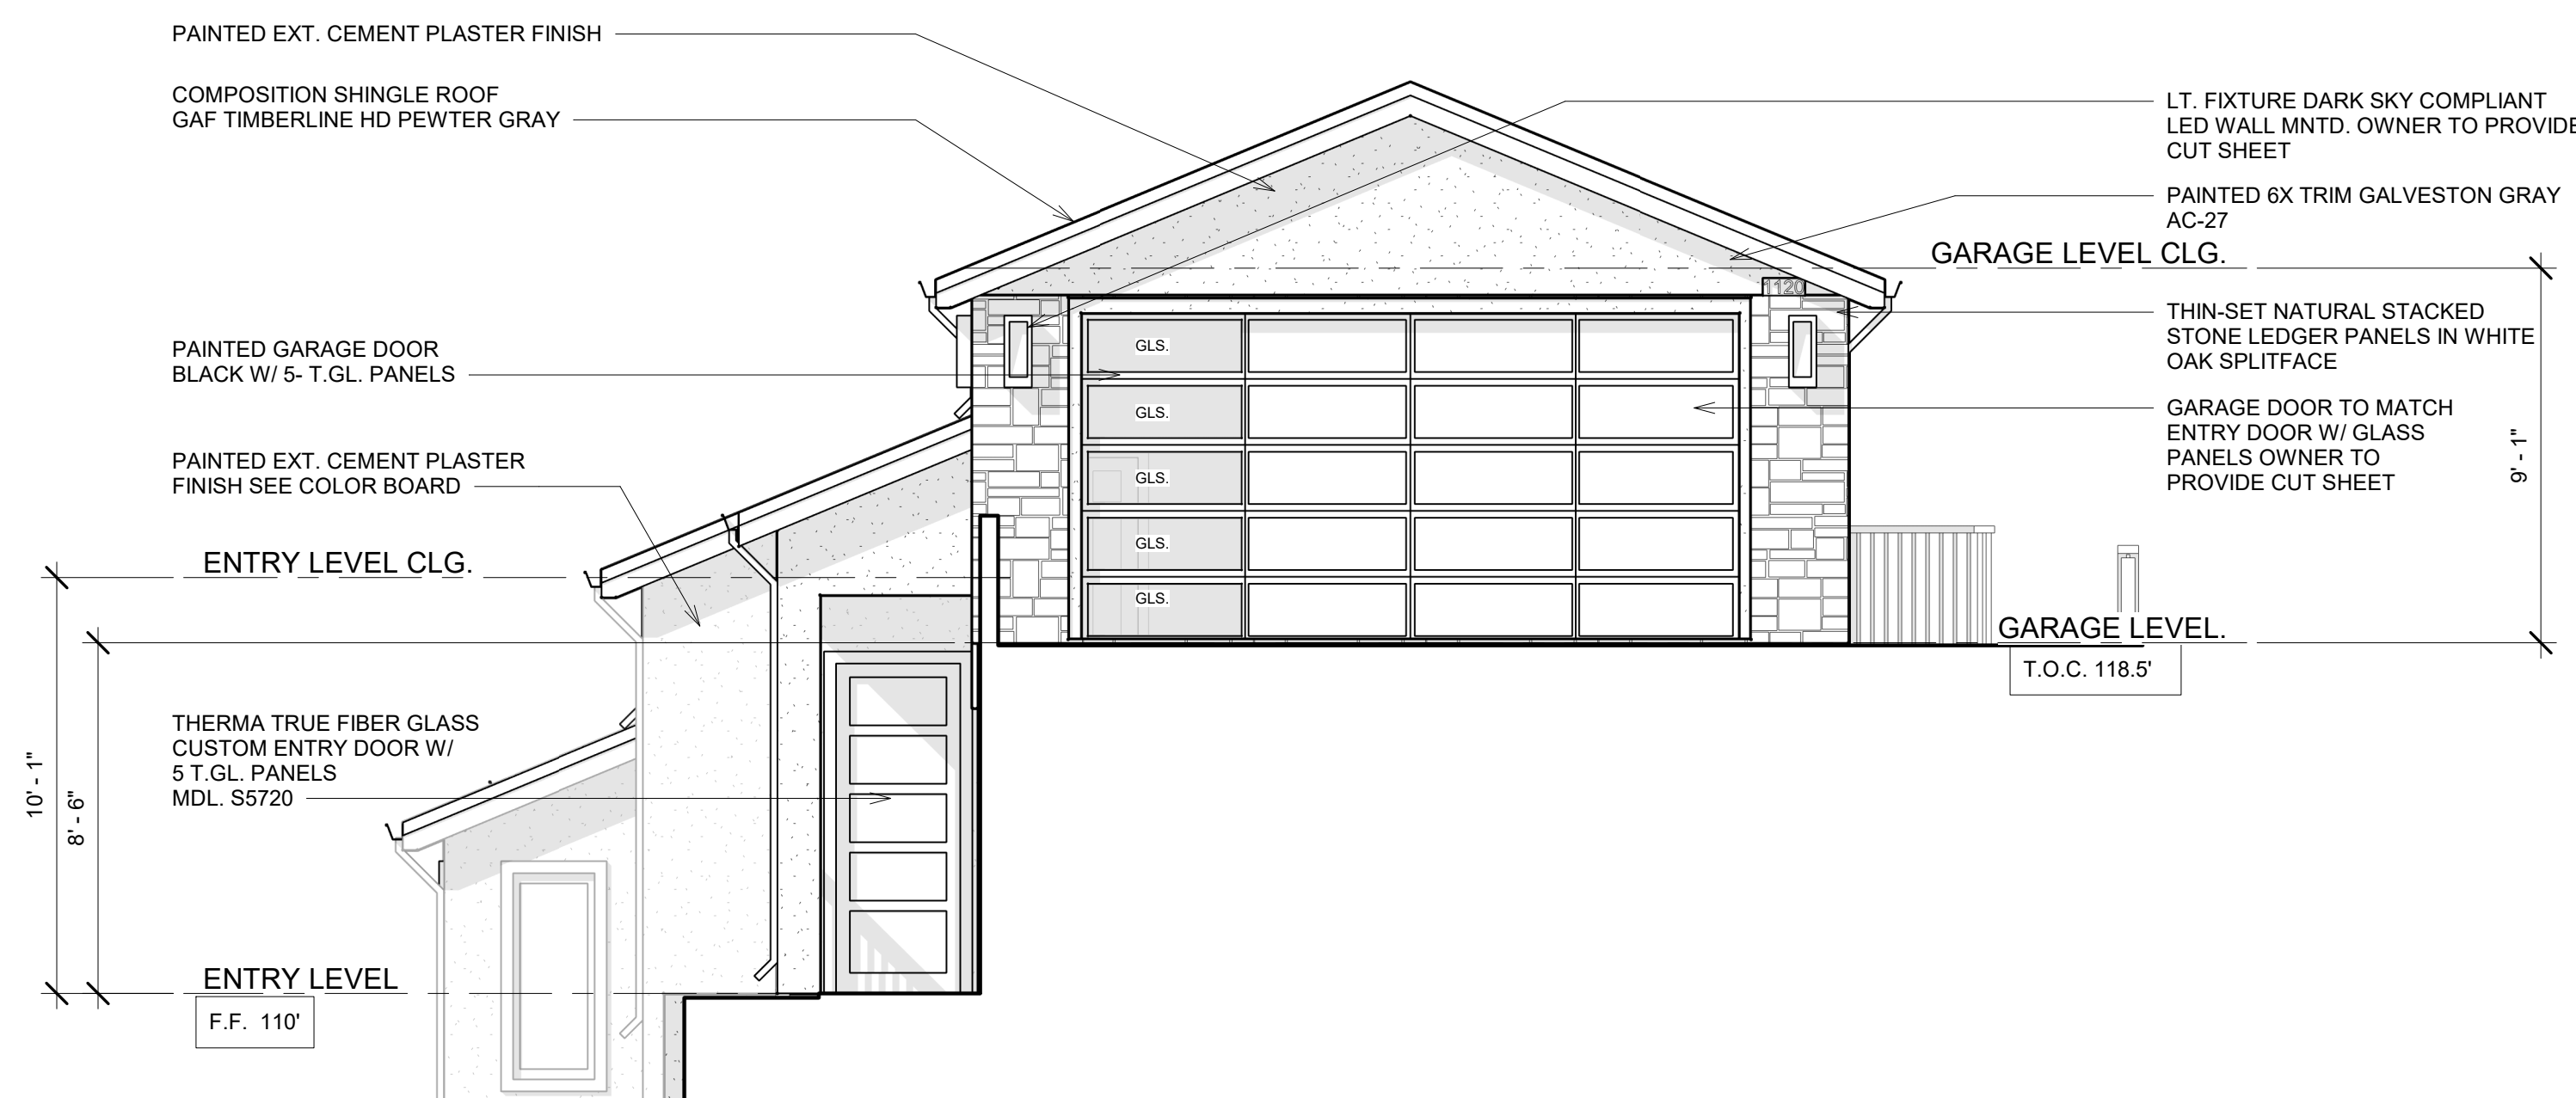

## 2 FRONT ELEVATION-APPROVED

SCALE: 1/4" = 1'-0"

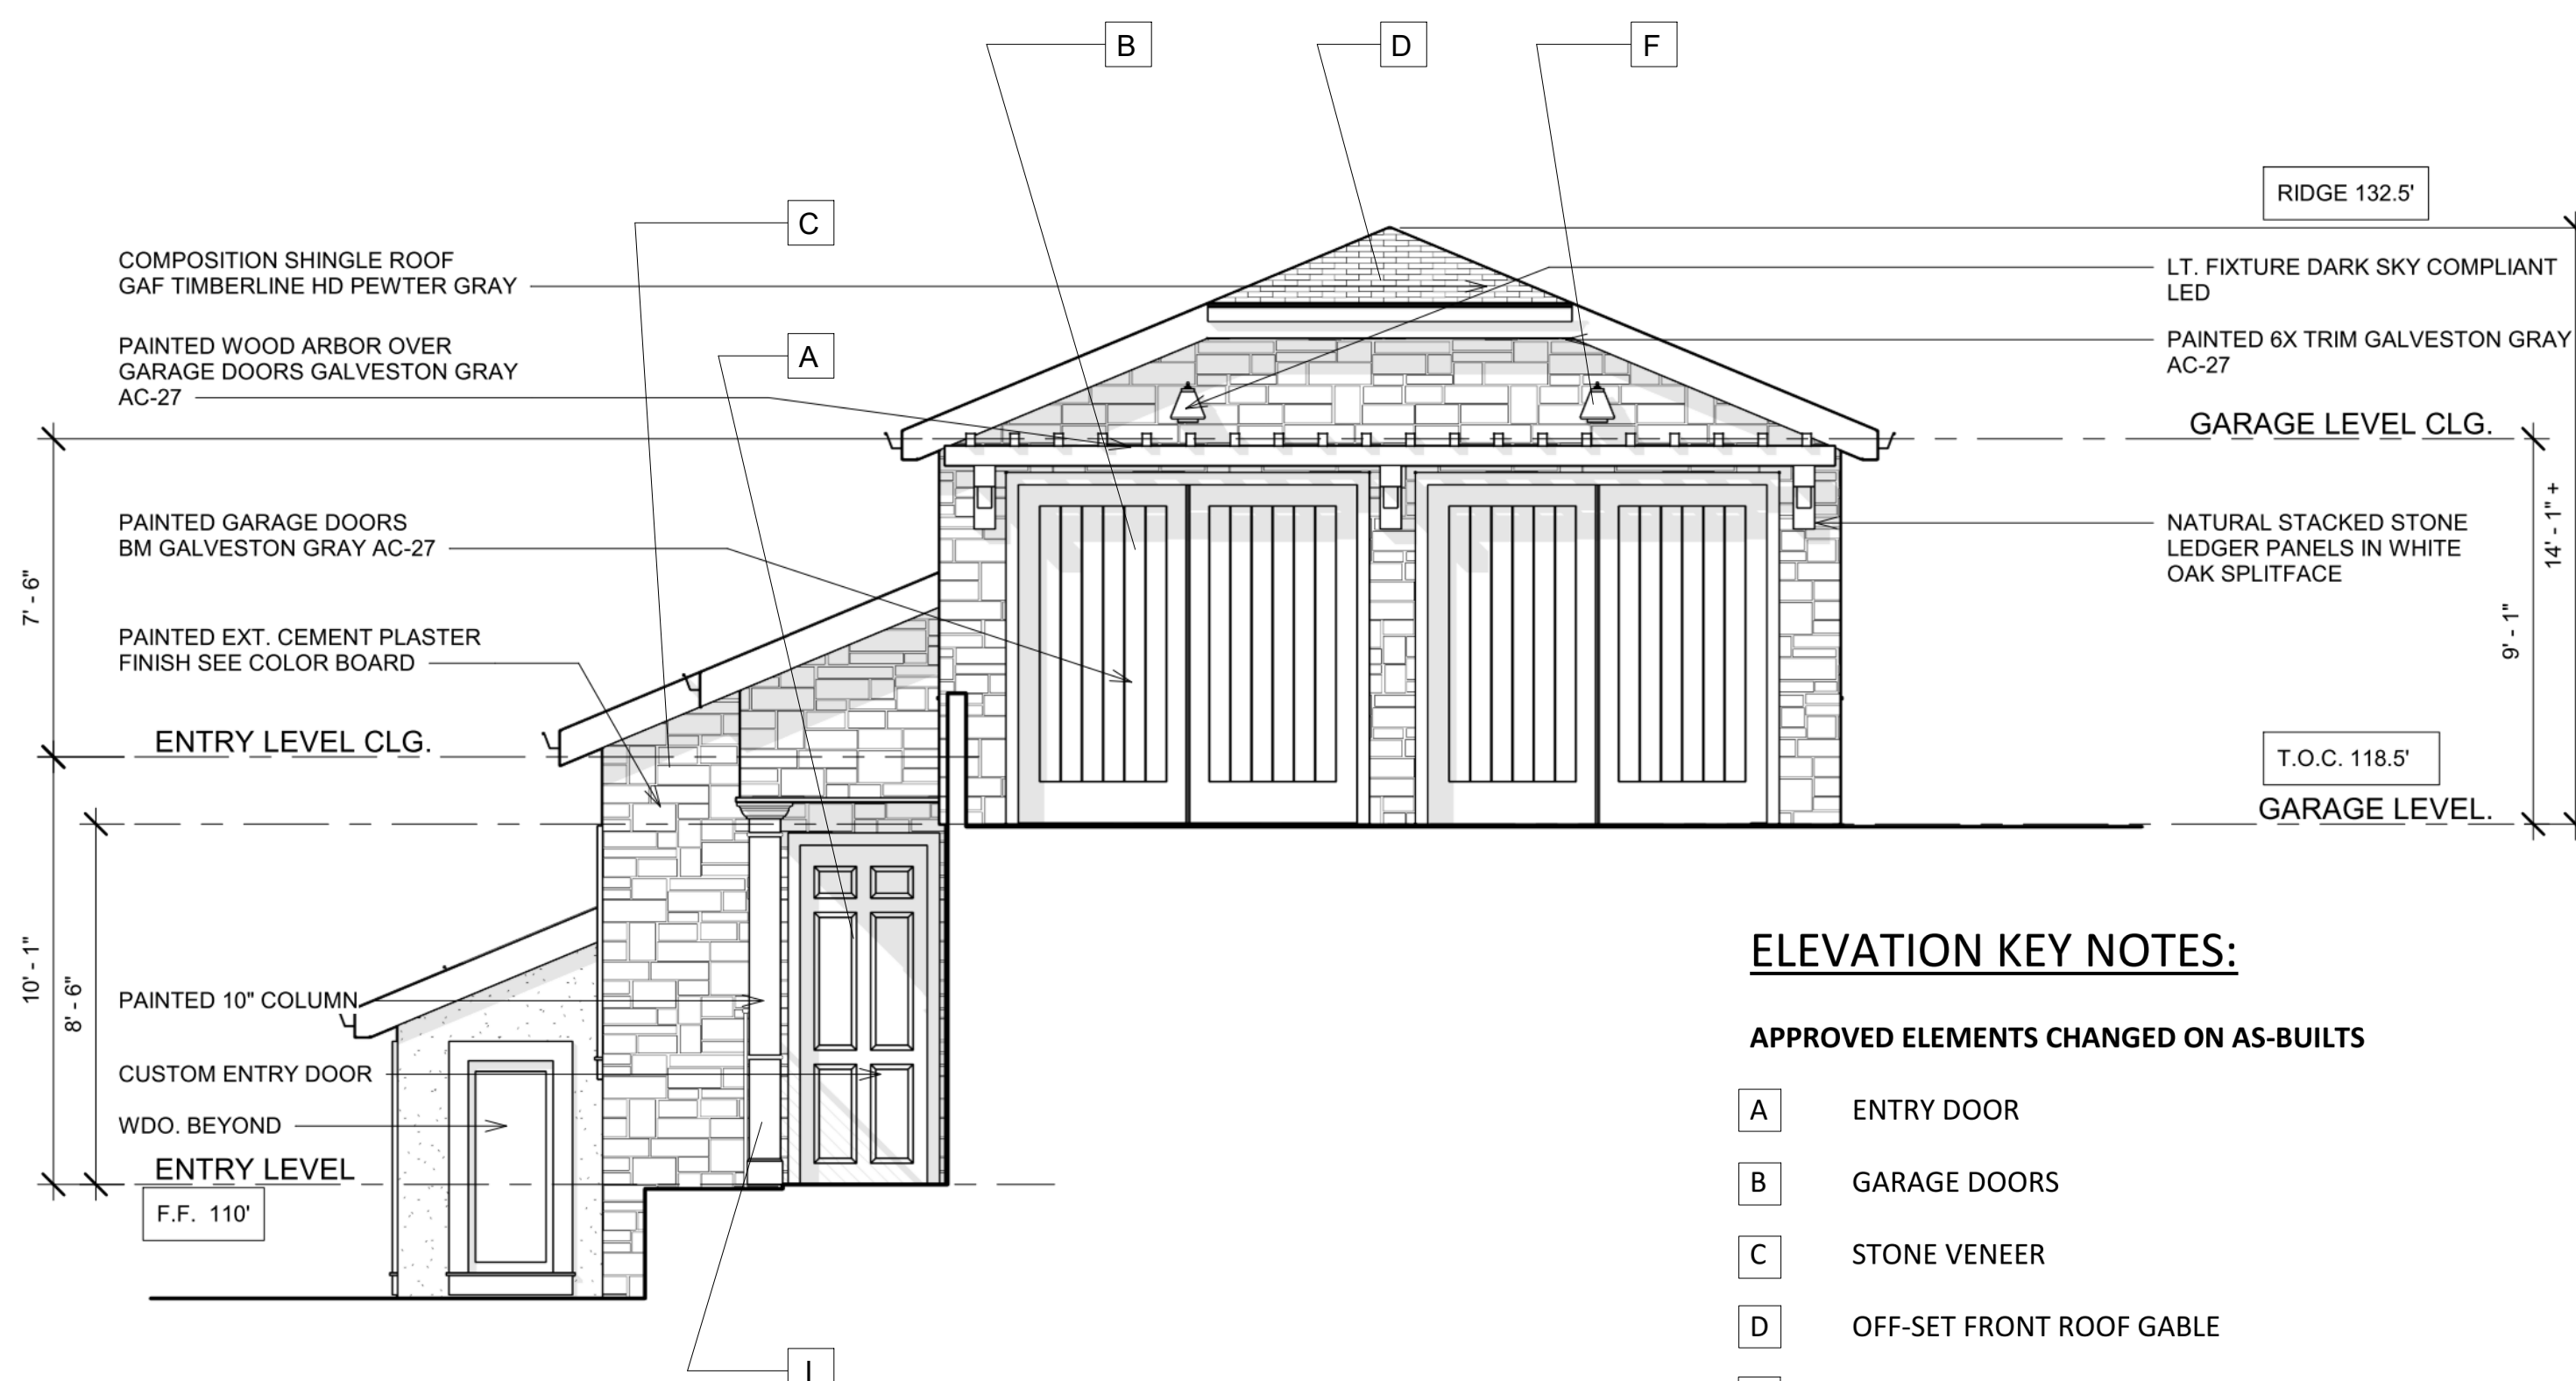

### ELEVATION KEY NOTES:

#### APPROVED ELEMENTS CHANGED ON AS-BUILTS

- A ENTRY DOOR
- B GARAGE DOORS
- C STONE VENEER
- D OFF-SET FRONT ROOF GABLE
- E ABOVE DOOR ARBOR
- F EXTERIOR LIGHT FIXTURES
- G PAINTED BELLY BAND/ACCENT
- H EXTERIOR BALCONY METAL RAILING
- I FRONT ENTRY COLUMN

NEW RESIDENCE  
1120 COLUMBUS ST.  
EL GRANADA, CA.  
APN.047-275-050

-DESIGN REVIEW  
RESUBMITTAL-V1

REVISIONS	DESCRIPTION	DATE	BY
1	PLANNING RESUBMITTAL	3-2-2021	CR
2			
3			
4			
5			

#### DRAWING STATUS

PRELIMINARY DESIGN

#### PLANNING

PC1

PC2

PERMIT

DATE

3/5/2021


Scale

As indicated

Project Number  
AB03

Drawing Number

A5.0

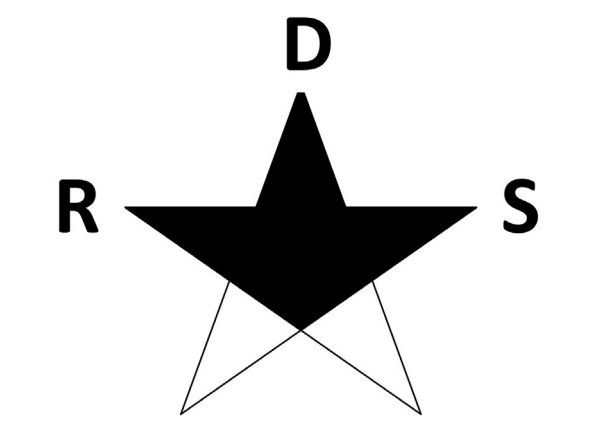

**RESIDENTIAL  
DESIGN SOLUTIONS**

406 LA JOLLA AVENUE  
SAN MATEO, CA 94403  
(650) 218-8161  
EMAIL RDS@CHRISTIANRUFFAT.COM  
WEB CHRISTIANRUFFAT.COM




**NEW  
RESIDENCE**  
1120 COLUMBUS ST.  
EL GRANADA, CA.  
APN.047-275-050

**-DESIGN REVIEW  
RESUBMITTAL-V1**

REVISIONS	DESCRIPTION	DATE	BY
1	PLANNING RESUBMITTAL	3-2-2021	CR
2			
3			
4			
5			

DRAWING STATUS
PRELIMINARY DESIGN
PLANNING
PC1
PC2
PERMIT

DATE 3/5/2021 Drawing Number  
Scale As indicated **A5.1**  
Project Number AB03

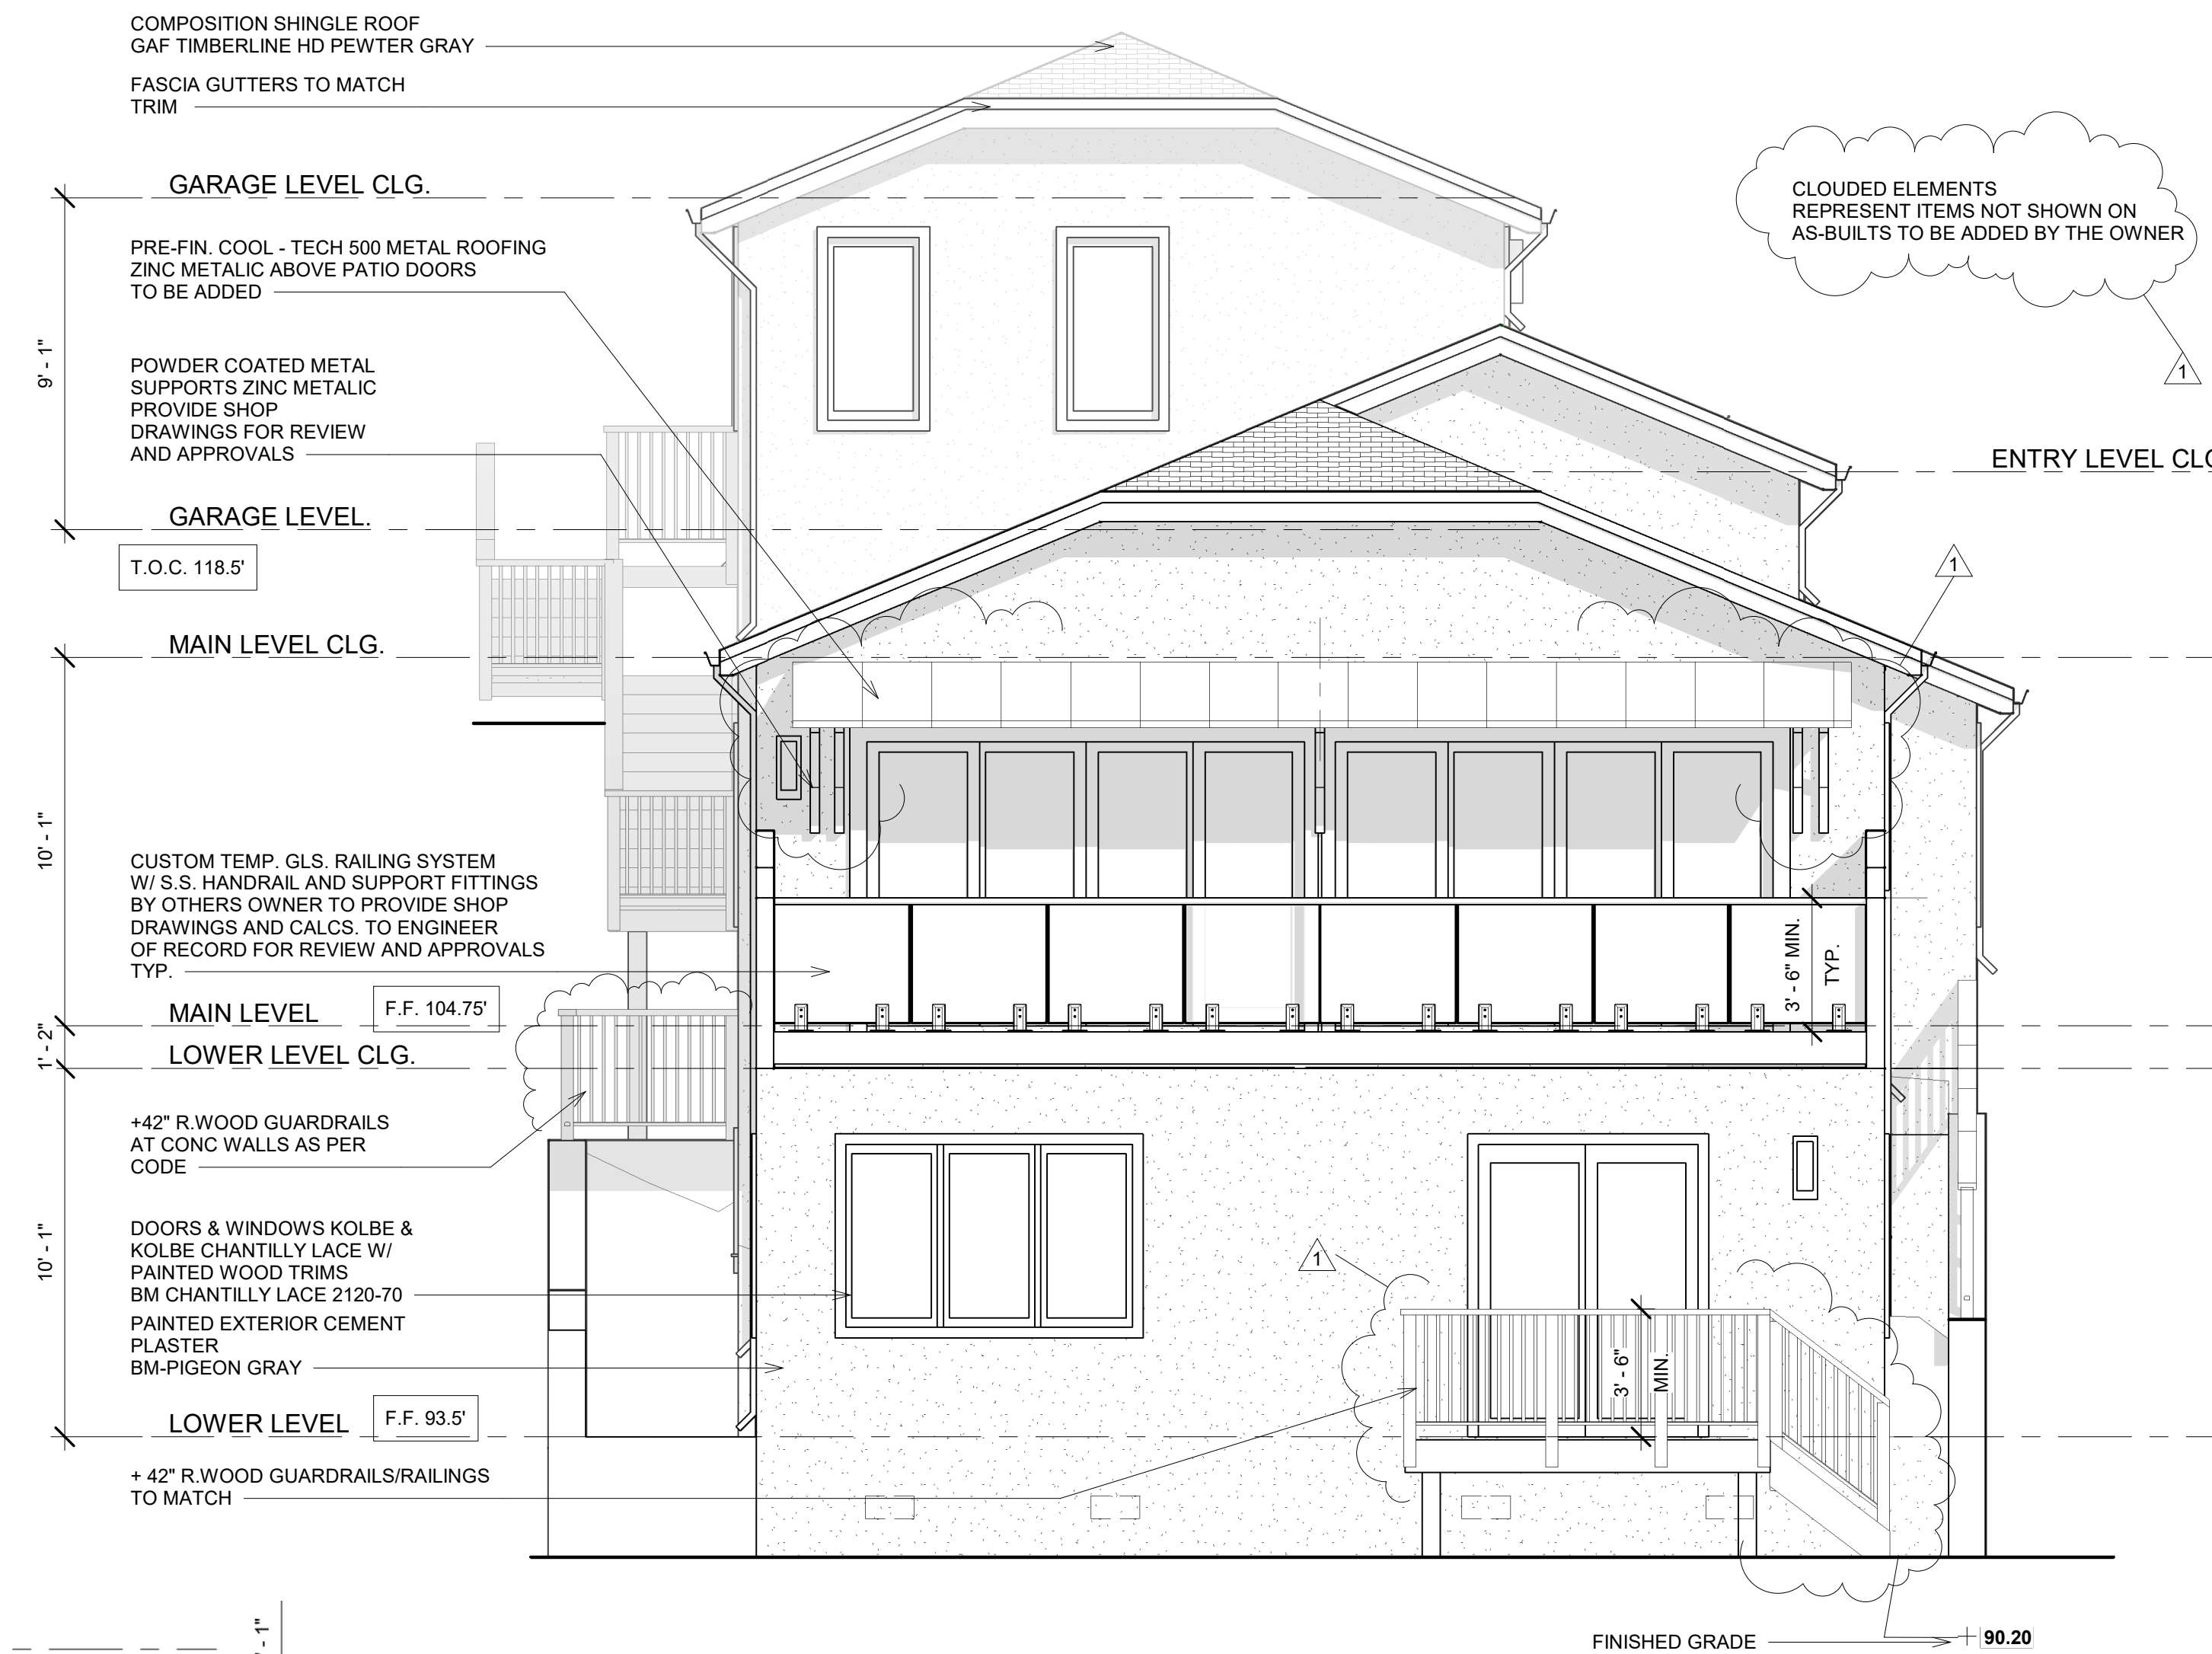


**1 REAR ELEVATION- AS BUILT**  
SCALE: 1/4" = 1'-0"


**ELEVATION KEY NOTES:**

**APPROVED ELEMENTS CHANGED ON AS-BUILTS**


- A ENTRY DOOR
- B GARAGE DOORS
- C STONE VENEER
- D OFF-SET FRONT ROOF GABLE
- E ABOVE DOOR ARBOR
- F EXTERIOR LIGHT FIXTURES
- G PAINTED BELLY BAND/ACCENT
- H EXTERIOR BALCONY METAL RAILING
- I FRONT ENTRY COLUMN

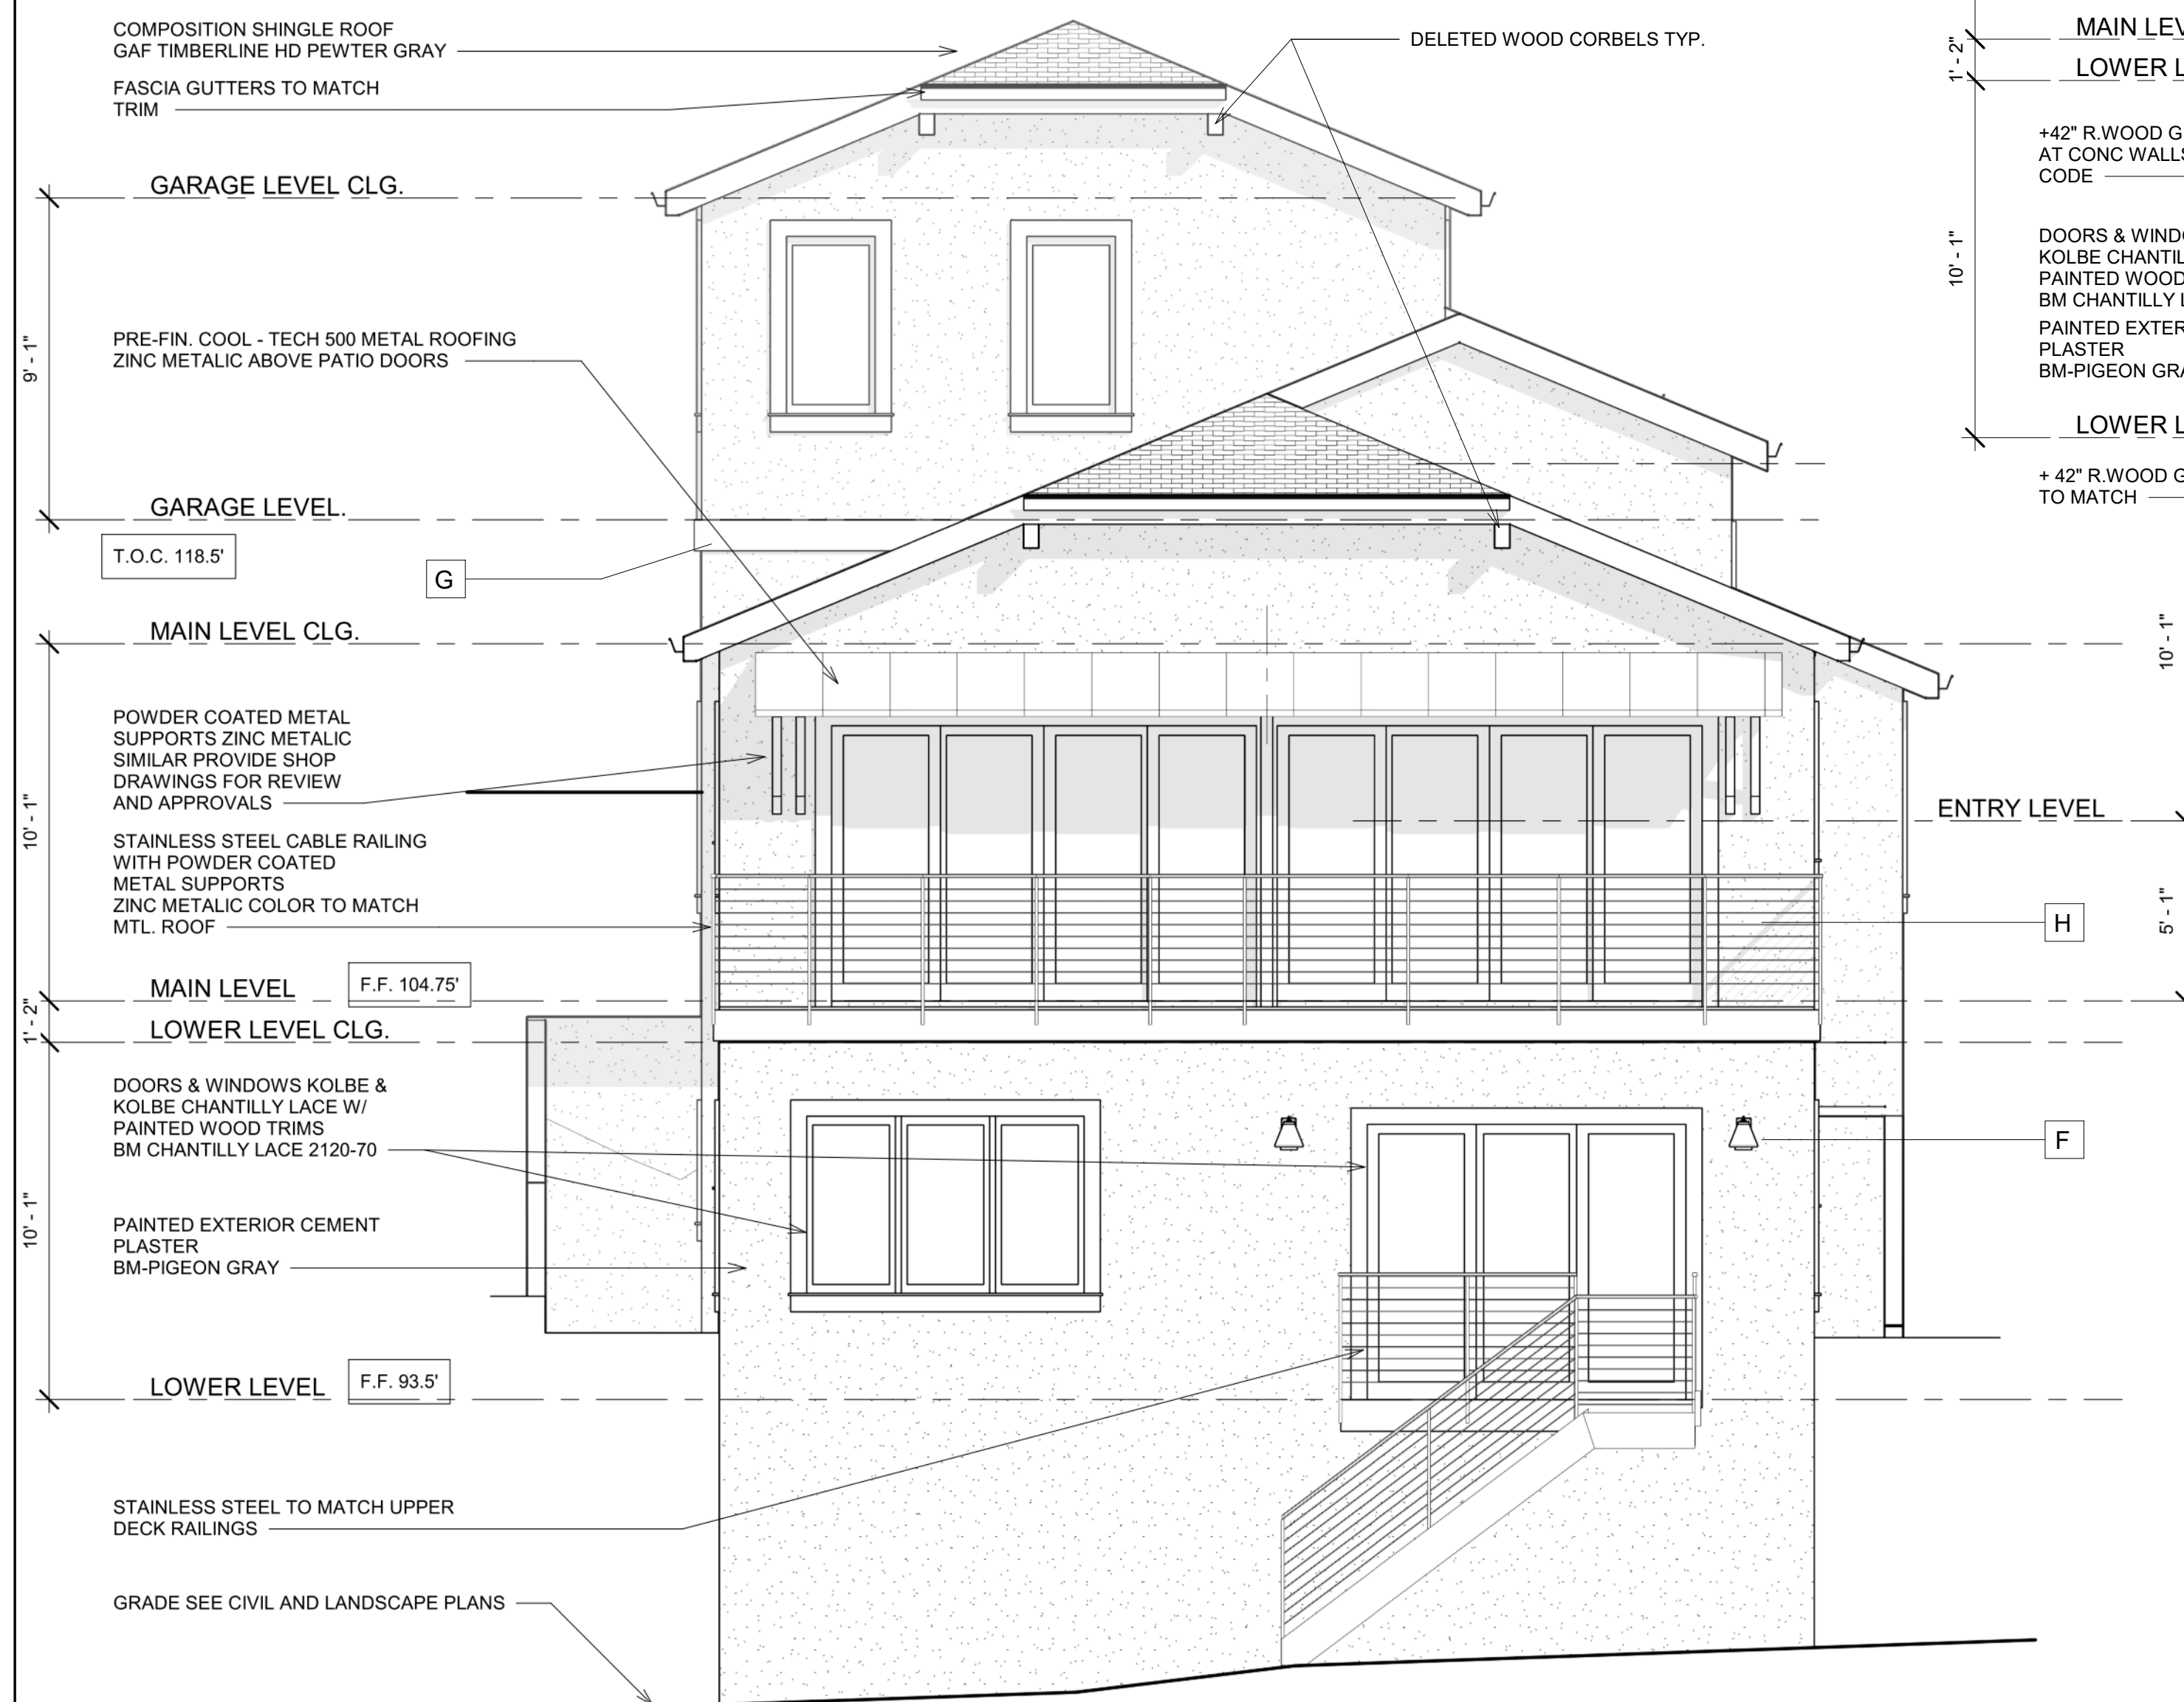

**2 REAR ELEVATION-APPROVED**  
SCALE: 1/2" = 1'-0"

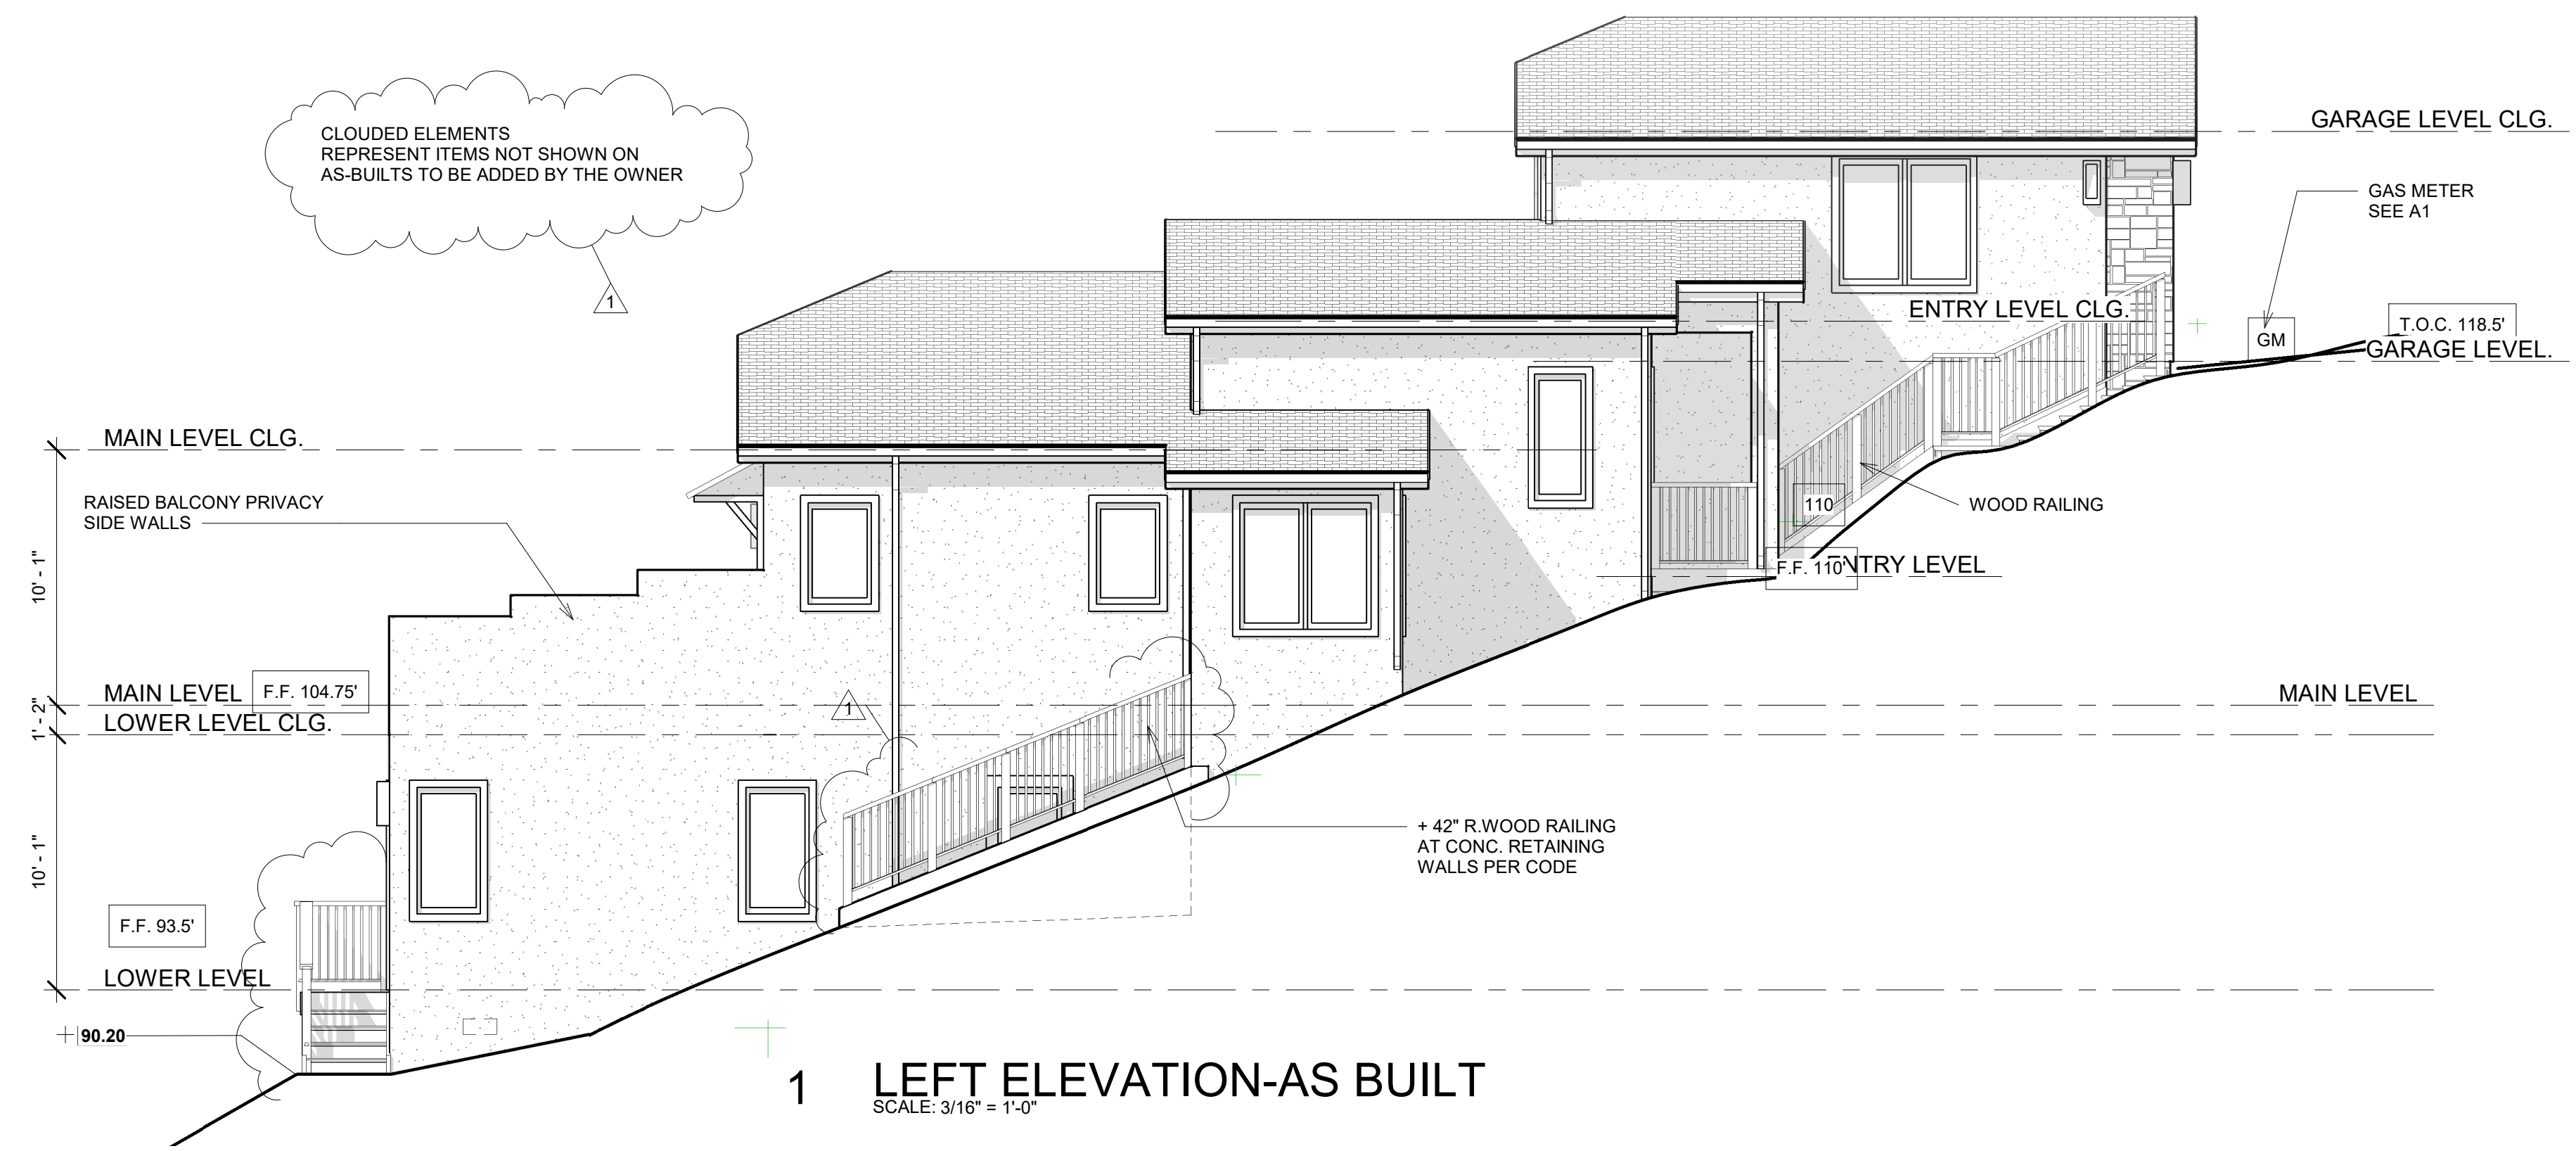

**1 LEFT ELEVATION-AS BUILT**  
SCALE: 3/16" = 1'-0"

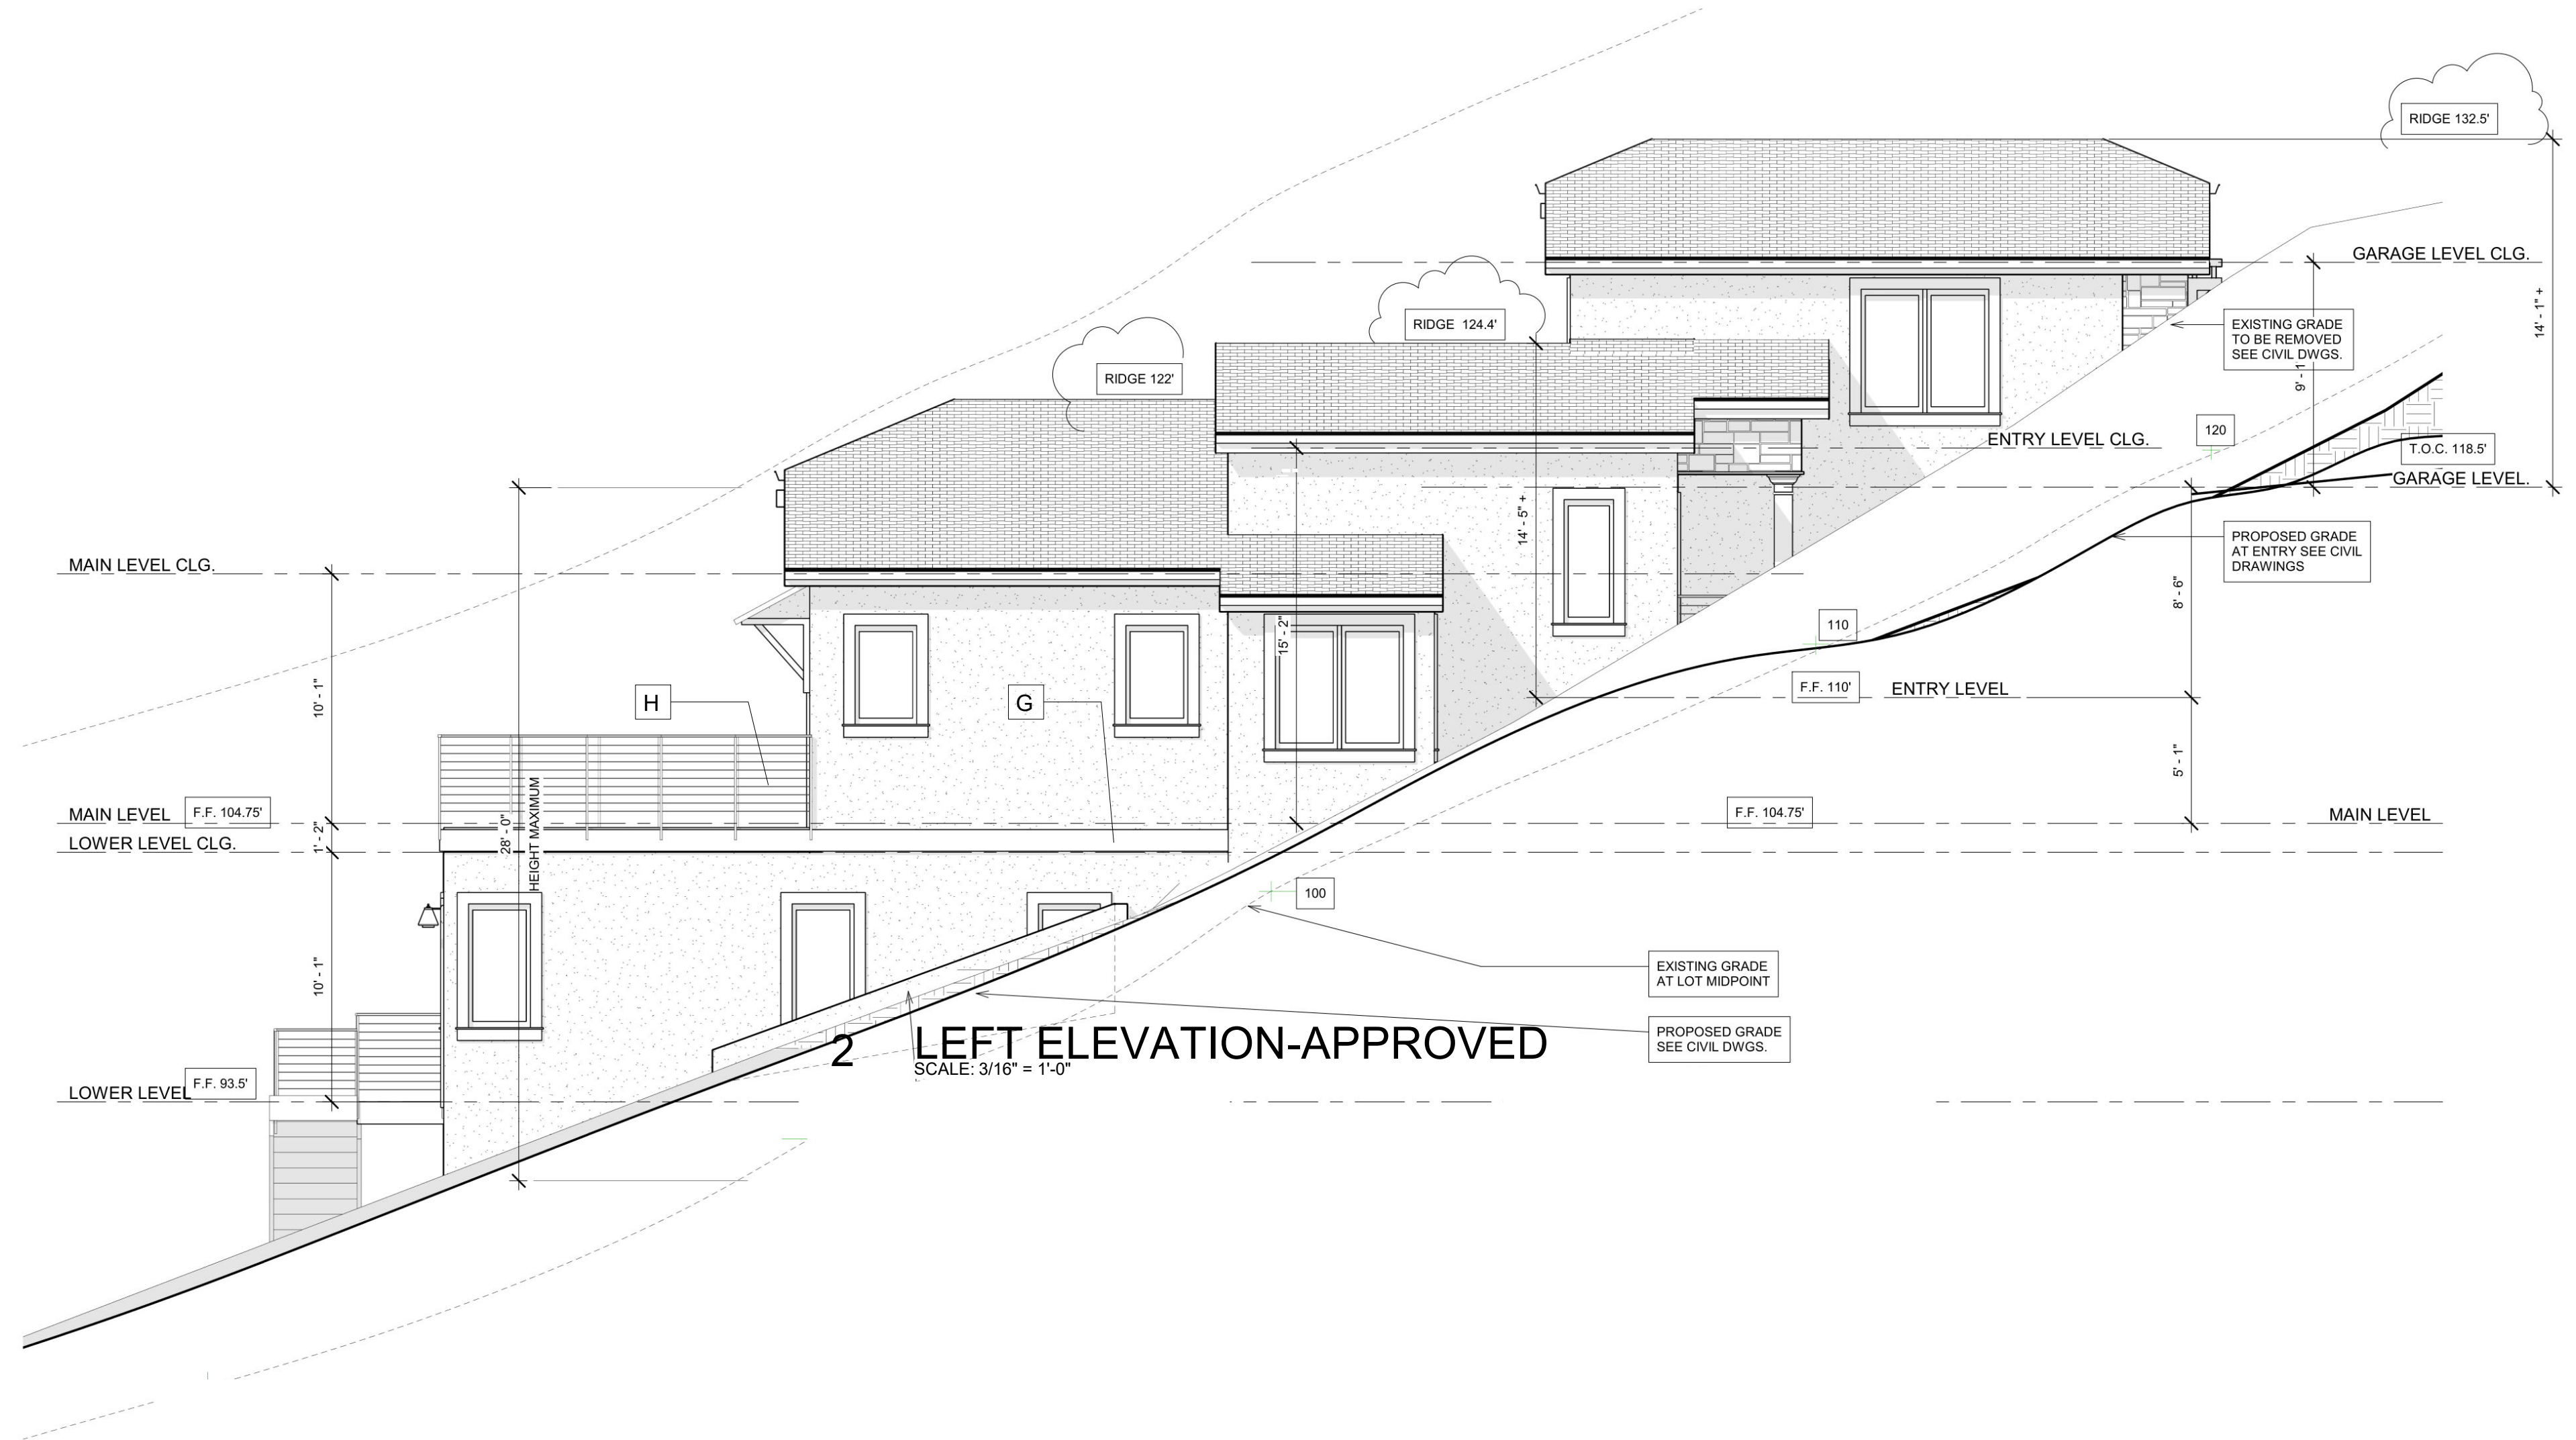

**2 LEFT ELEVATION-APPROVED**  
SCALE: 3/16" = 1'-0"

**ELEVATION KEY NOTES:**


**APPROVED ELEMENTS CHANGED ON AS-BUILTS**

- A ENTRY DOOR
- B GARAGE DOORS
- C STONE VENEER
- D OFF-SET FRONT ROOF GABLE
- E ABOVE DOOR ARBOR
- F EXTERIOR LIGHT FIXTURES
- G PAINTED BELLY BAND/ACCENT
- H EXTERIOR BALCONY METAL RAILING
- I FRONT ENTRY COLUMN

D  
R      S

**RESIDENTIAL  
DESIGN SOLUTIONS**

406 LA JOLLA AVENUE  
SAN MATEO, CA 94403  
(650) 218-8161  
EMAIL RDS@CHRISTIANRUFFAT.COM  
WEB CHRISTIANRUFFAT.COM

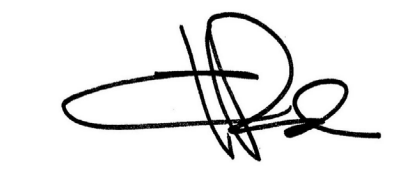

**NEW  
RESIDENCE**  
1120 COLUMBUS ST.  
EL GRANADA, CA.  
APN.047-275-050


**-DESIGN REVIEW  
RESUBMITTAL-V1**

	DESCRIPTION	DATE	BY
REVISIONS	1	PLANNING RESUBMITTAL	3-2-2021 CR
	2		
	3		
	4		
	5		


DRAWING STATUS
PRELIMINARY DESIGN
PLANNING
PC1
PC2
PERMIT

DATE 3/5/2021 Drawing Number  
**A6.0**  
Scale 3/16" = 1'-0"  
Project Number AB03



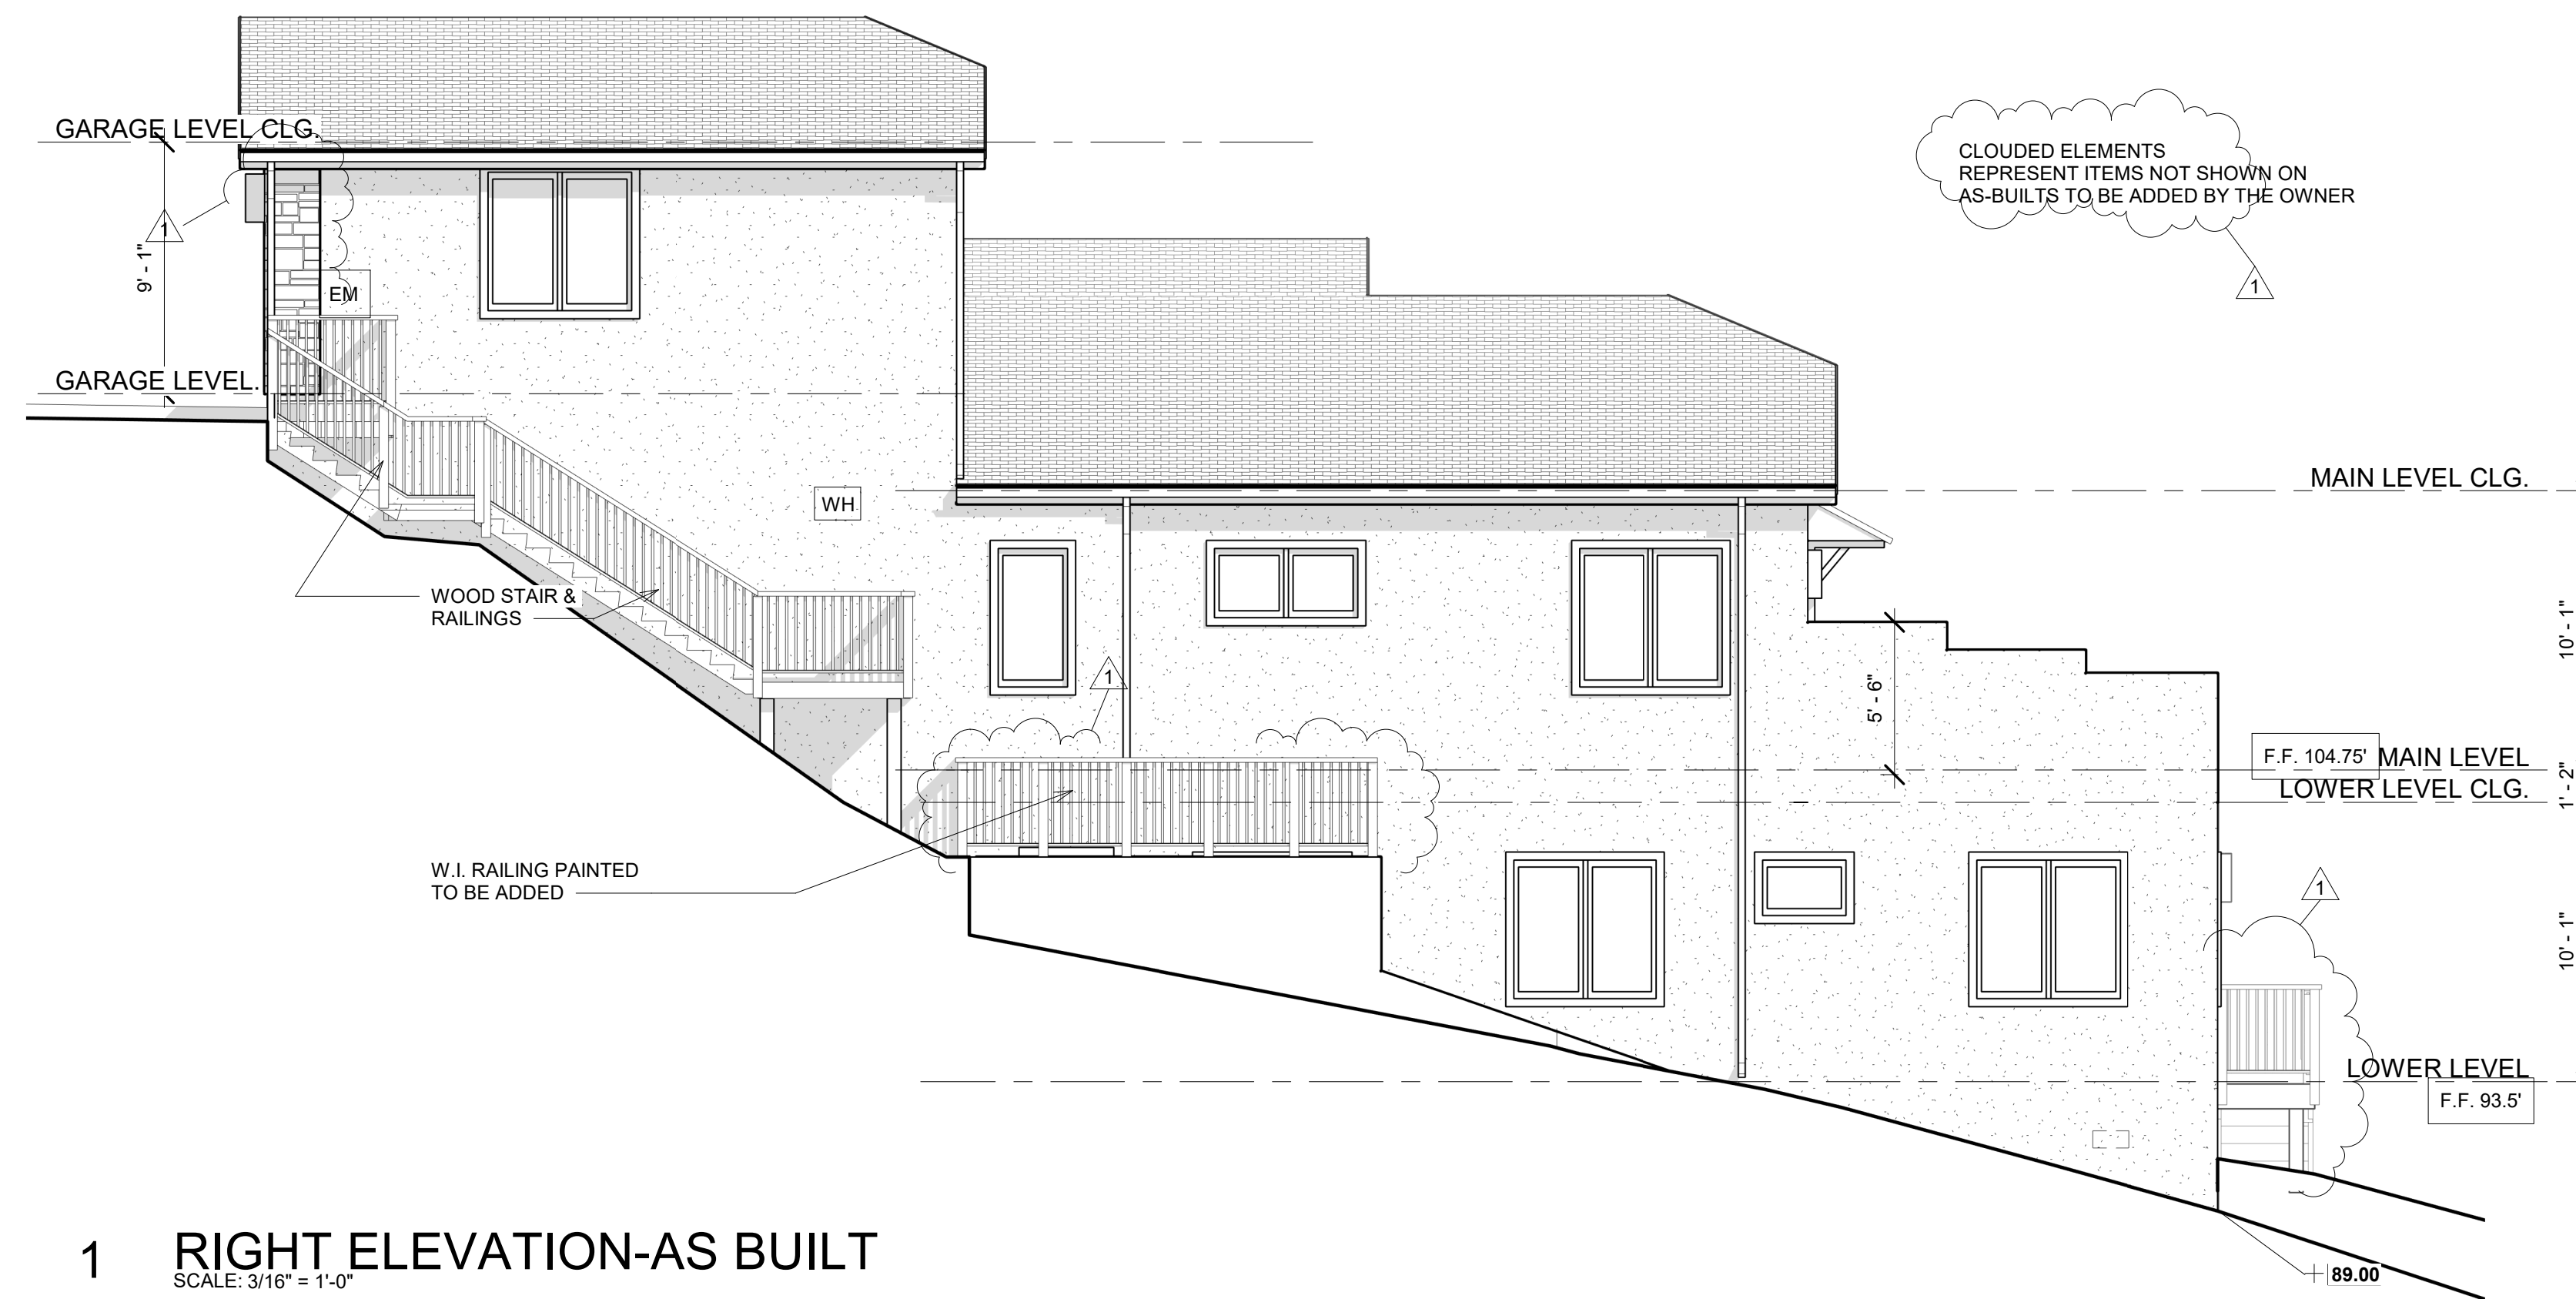

1 RIGHT ELEVATION-AS BUILT  
SCALE: 3/16" = 1'-0"

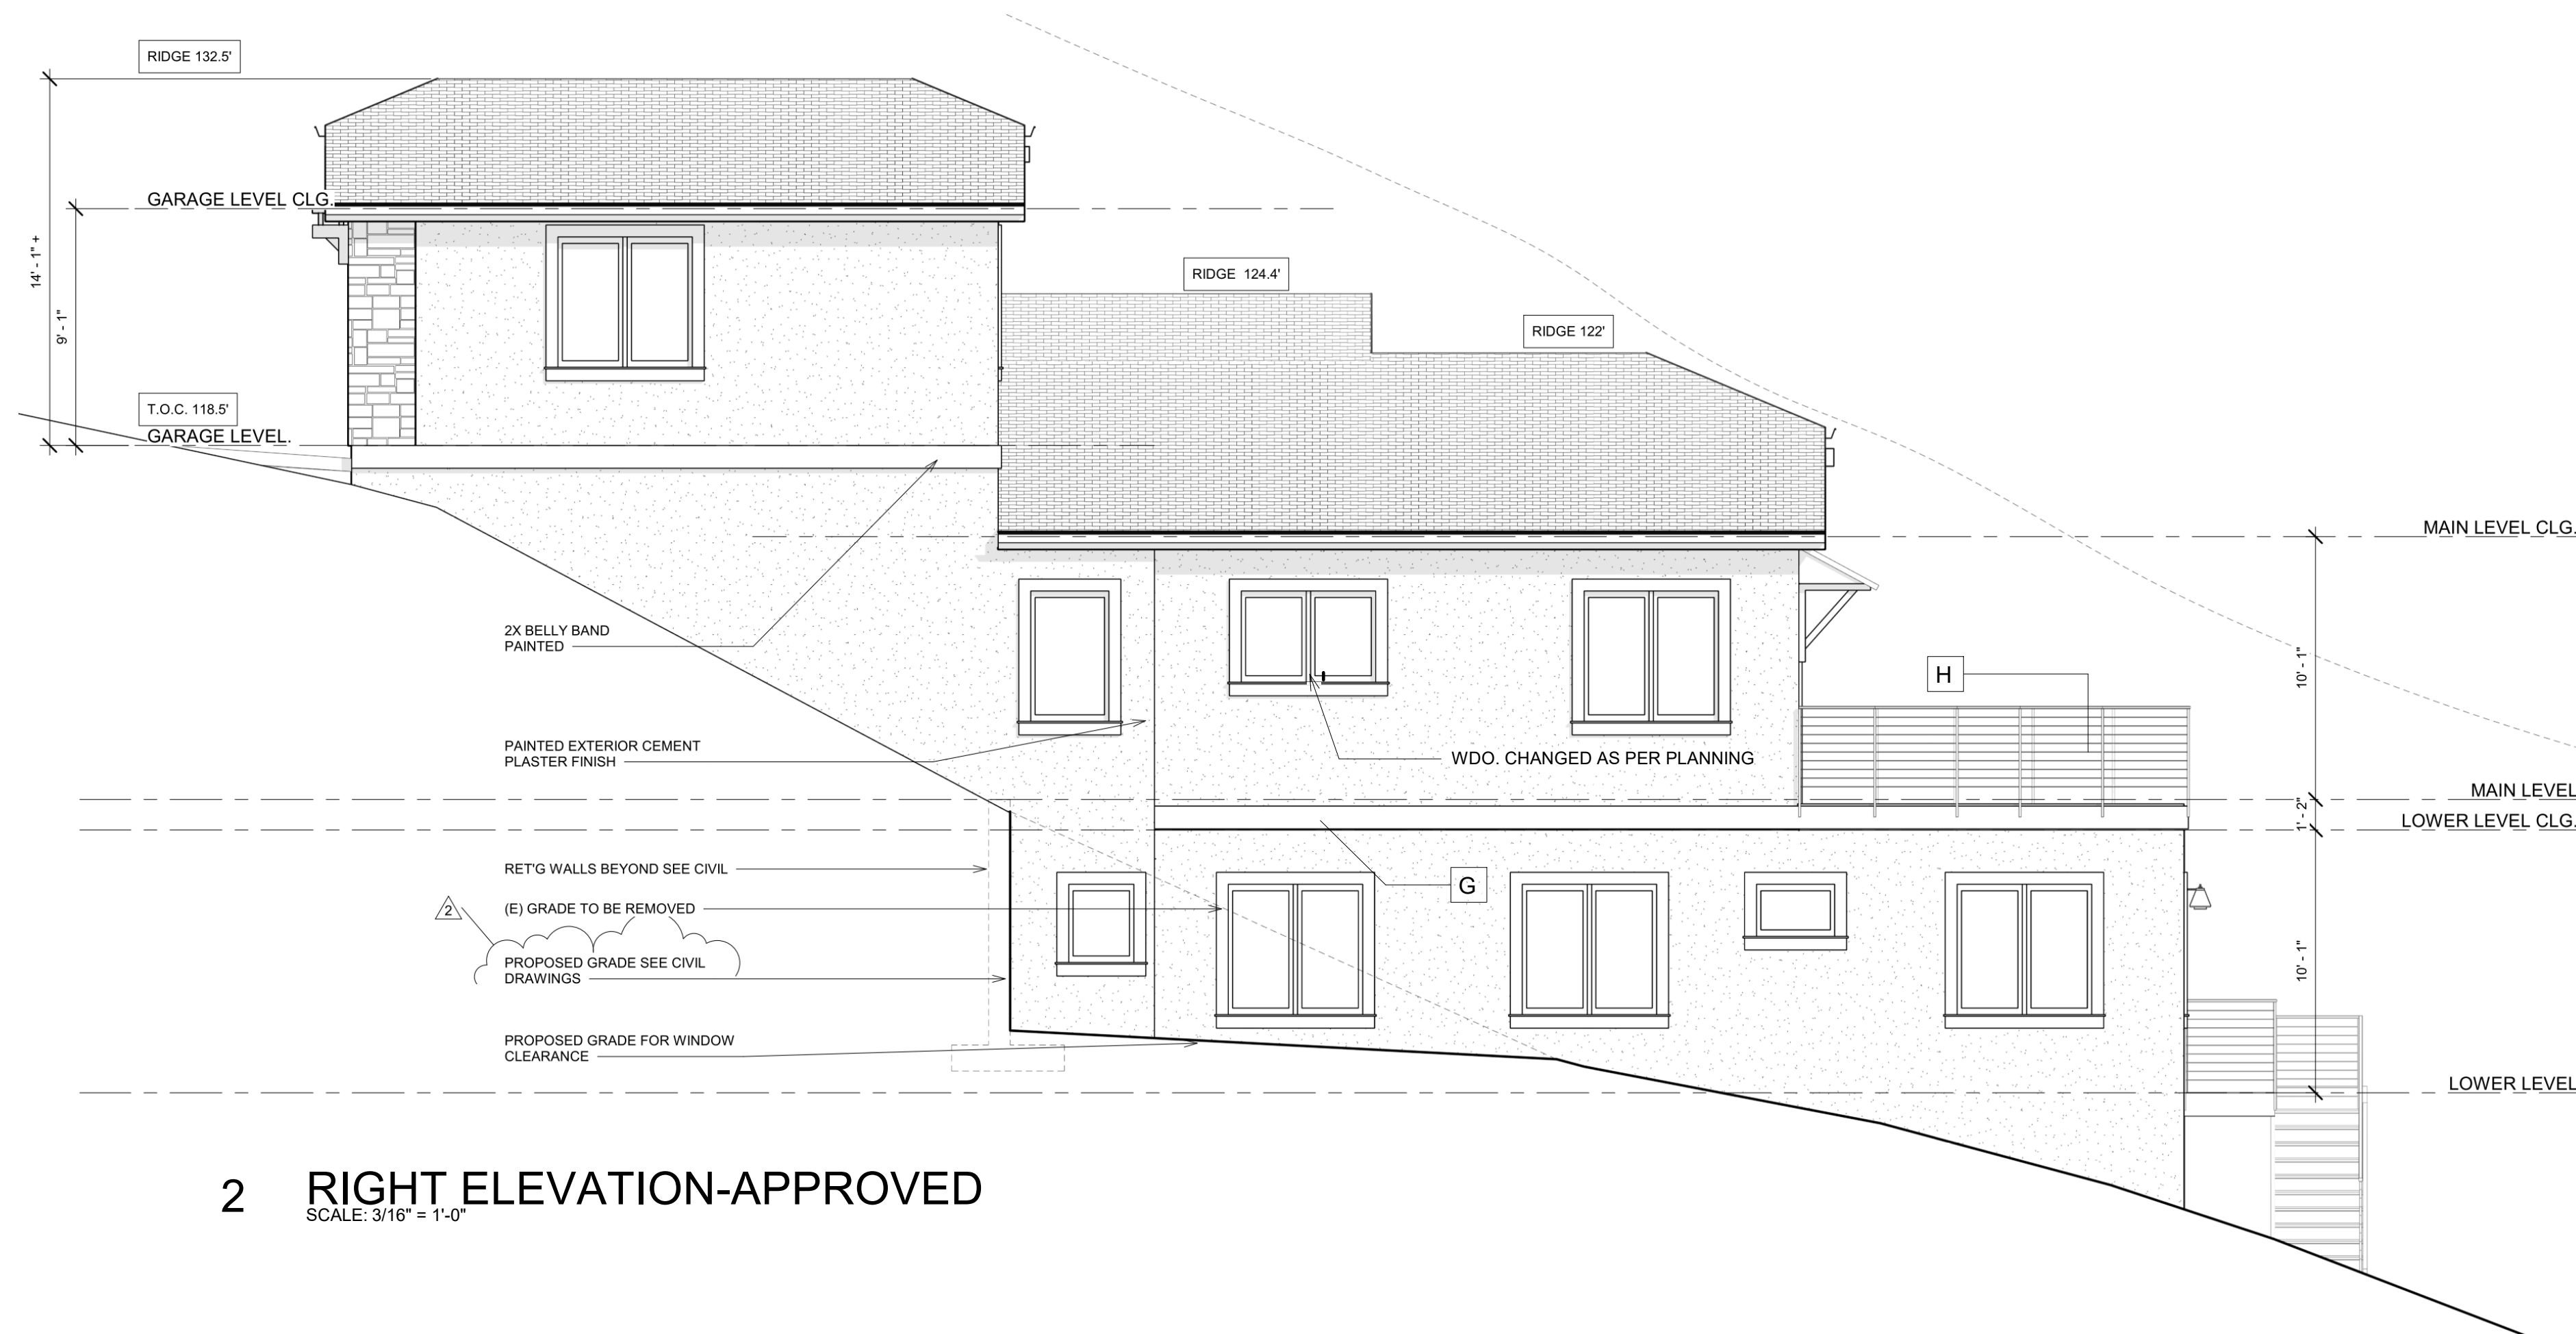


2 RIGHT ELEVATION-APPROVED  
SCALE: 3/16" = 1'-0"

**ELEVATION KEY NOTES:**

**APPROVED ELEMENTS CHANGED ON AS-BUILTS**

- A ENTRY DOOR
- B GARAGE DOORS
- C STONE VENEER
- D OFF-SET FRONT ROOF GABLE
- E ABOVE DOOR ARBOR
- F EXTERIOR LIGHT FIXTURES
- G PAINTED BELLY BAND/ACCENT
- H EXTERIOR BALCONY METAL RAILING
- I FRONT ENTRY COLUMN

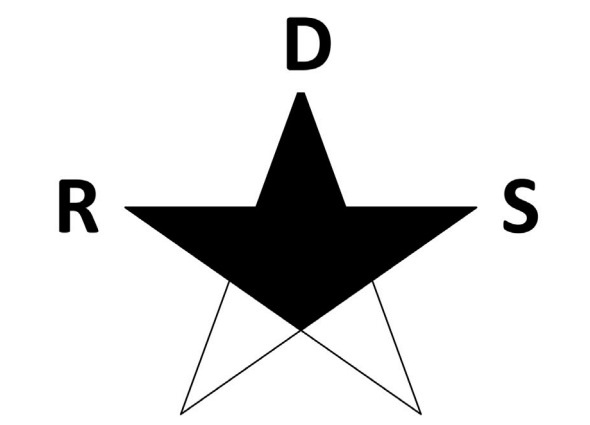

**RESIDENTIAL  
DESIGN SOLUTIONS**

406 LA JOLLA AVENUE  
SAN MATEO, CA 94403  
(650) 218-8161  
EMAIL RDS@CHRISTIANRUFFAT.COM  
WEB CHRISTIANRUFFAT.COM



**NEW  
RESIDENCE**  
1120 COLUMBUS ST.  
EL GRANADA, CA.  
APN.047-275-050

**-DESIGN REVIEW  
RESUBMITTAL-V1**

REVISIONS	DESCRIPTION	DATE	BY
1	PLANNING RESUBMITTAL	3-2-2021	CR
2			
3			
4			
5			

DRAWING STATUS
PRELIMINARY DESIGN
PLANNING
PC1
PC2
PERMIT

DATE 3/5/2021 Drawing Number

Scale 3/16" = 1'-0"

**A7**

Project Number AB03

**BOUNDARY NOTE:**

MONUMENTS HAVE BEEN SET AT THE PROPERTY CORNERS, AS SHOWN HEREON, AND A RECORD OF SURVEY HAS BEEN FILED WITH THE COUNTY OF SAN MATEO IN VOL. 43 OF LLS MAPS AT PAGE 73.

**BASIS OF ELEVATIONS:**

ELEVATIONS ARE BASED UPON AN ASSUMED DATUM.

◆ TBM: SET MAG NAIL AND SHINER ALONG COLUMBUS STREET, AS SHOWN. ELEVATION = 132.15'

**BASIS OF BEARINGS:**


THE BEARING S43°47'30"W BETWEEN TWO FOUND BRASS DISK MONUMENTS, AS SHOWN ON THAT CERTAIN RECORD OF SURVEY FILED IN VOLUME 8 OF L.L.S. MAPS AT PAGES 108-111, WAS USED AS THE BASIS OF BEARINGS FOR THIS SURVEY.

**LEGEND:**

- SET 3/4" IP WITH PLASTIC PLUG "LS 7701" AND TACK PER 43 LLS 73
- A/C ASPHALTIC CONCRETE
- BW BACK OF WALK
- CB CATCH BASIN
- CIP CAST IRON PIPE
- OMP CORRUGATED METAL PIPE
- CONC CONCRETE
- CO CLEAN-OUT
- DI DROP INLET
- EM ELECTRIC METER
- FD FOUND
- FF FINISHED FLOOR
- FL FLOW LINE
- FH FIRE HYDRANT
- GA GUY ANCHOR
- GM GAS METER
- GRD GROUND
- HCR HANDICAP RAMP
- INV INVERT
- IP IRON PIPE
- JP JOINT POLE
- LAT. LATERAL
- LC LIP OF GUTTER
- O/H OVERHEAD
- P.U.E. PUBLIC UTILITIES EASEMENT
- RCP REINFORCED CONCRETE PIPE
- RET. WALL RETAINING WALL
- R/W RIGHT OF WAY
- SSCO SANITARY SEWER CLEAN-OUT
- SSMH SANITARY SEWER MANHOLE
- SDM STORM DRAIN MANHOLE
- TBC TOP BACK OF CURB
- T/W TOP OF WALL
- U/G UNDERGROUND
- VCP VITRIFIED CLAY PIPE
- WV WATER VALVE
- WM WATER METER BOX
- CTV- CABLE TELEVISION LINE
- E- ELECTRICAL LINE
- G- GAS LINE
- SS- SANITARY SEWER LINE
- SD- STORM DRAIN LINE
- T- TELEPHONE LINE
- W- WATER LINE


**UTILITY NOTE:**

THE UTILITIES EXISTING ON THE SURFACE AND SHOWN ON THIS DRAWING HAVE BEEN LOCATED BY FIELD SURVEY. ALL UNDERGROUND UTILITIES SHOWN ON THIS DRAWING ARE FROM RECORDS OF THE VARIOUS UTILITY COMPANIES AND THE SURVEYOR DOES NOT ASSUME RESPONSIBILITY FOR THEIR COMPLETENESS, INDICATED LOCATION, OR SIZE. RECORD UTILITY LOCATION SHOULD BE CONFIRMED BY EXPOSING THE UTILITY.

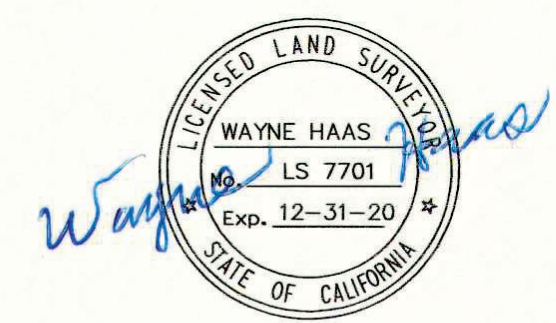

12/23/19  
**AS BUILT SURVEY**  
 LANDS OF ABOLMOLUKI  
 DOCUMENT # 2016-058252 O.R.  
 LOTS 33 AND 34, BLOCK 20  
 "PLAT OF SUBDIVISION NO. 1 OF GRANADA"  
 VOLUME 5 OF MAPS AT PAGE 43  
 ASSESSOR'S PARCEL NUMBER: 047-275-050  
 (1120 COLUMBUS STREET, EL GRANADA)  
 UNINCORPORATED SAN MATEO COUNTY CALIFORNIA  
 SCALE: 1" = 10' DECEMBER, 2019

**B & H SURVEYING, INC.**  
 PROFESSIONAL LAND SURVEYING  
 901 WALTERMIRE ST.  
 BELMONT, CA 94002  
 OFFICE (650) 637-1590

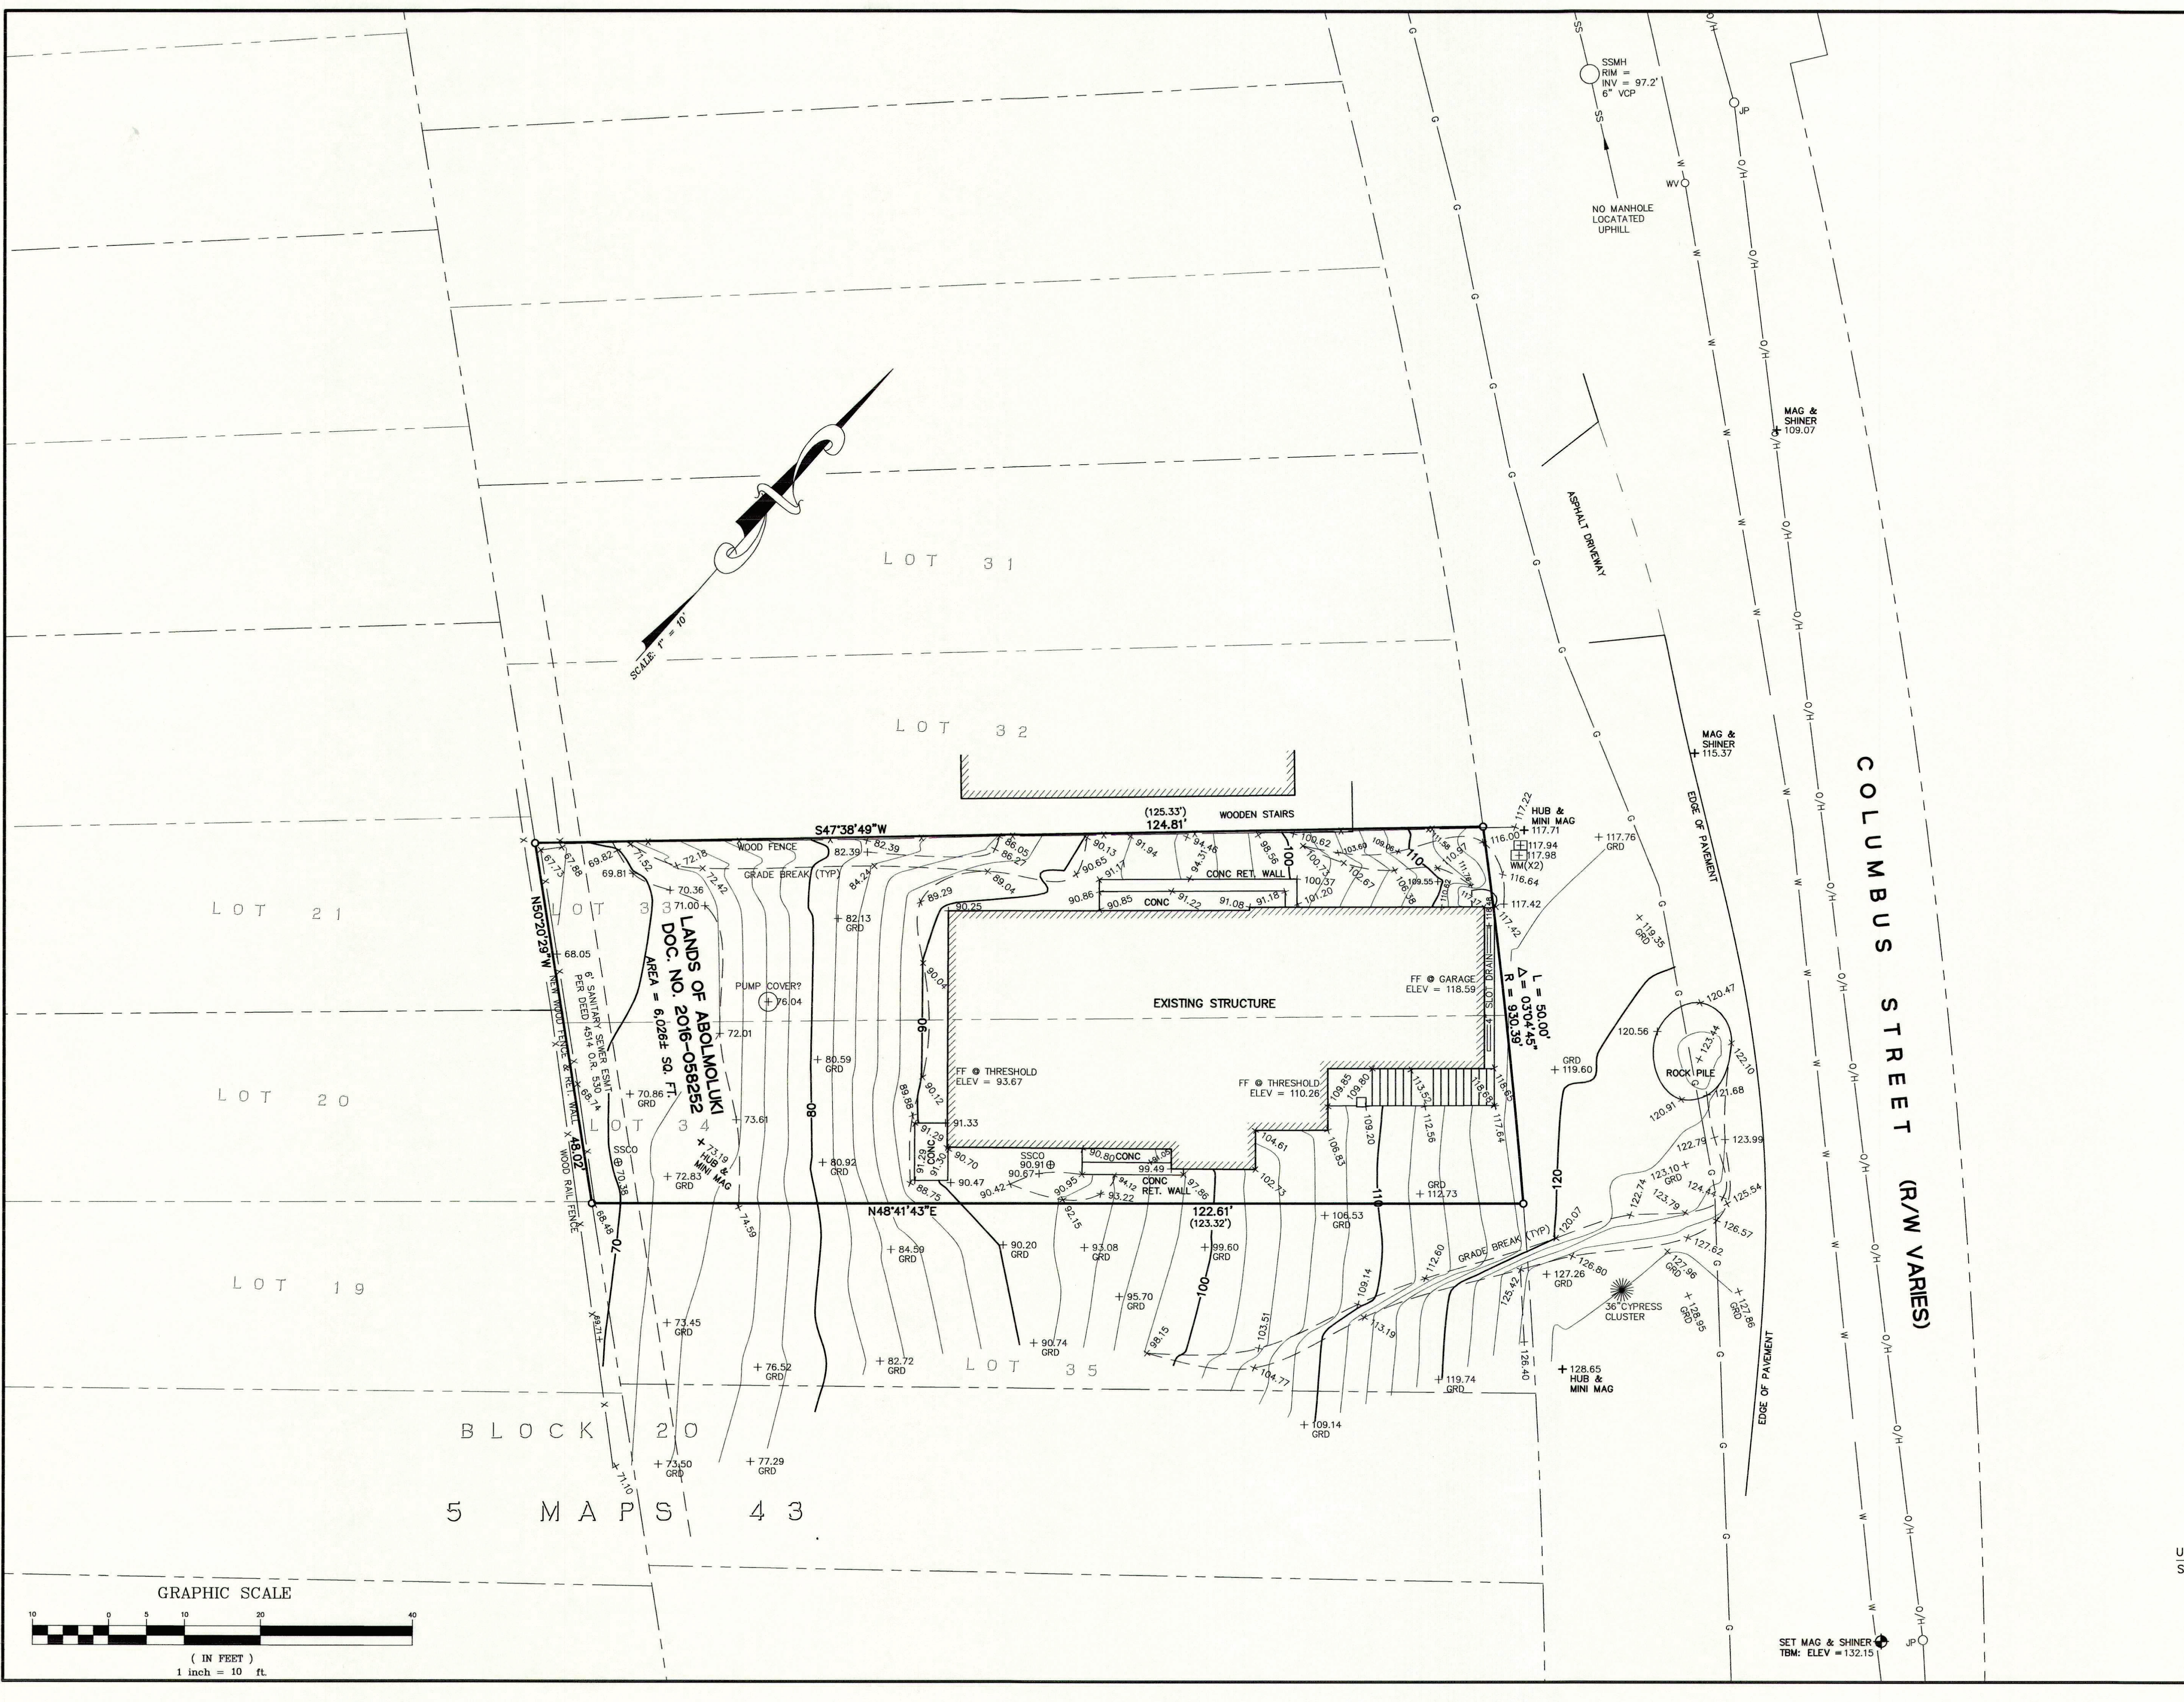

SET MAG & SHINER  
 TBM: ELEV = 132.15'

**BOUNDARY NOTE:**

MONUMENTS HAVE BEEN SET AT THE PROPERTY CORNERS, AS SHOWN HEREON, AND A RECORD OF SURVEY HAS BEEN FILED WITH THE COUNTY OF SAN MATEO IN VOL. 43 OF LLS MAPS AT PAGE 73.

**BASIS OF ELEVATIONS:**

ELEVATIONS ARE BASED UPON AN ASSUMED DATUM.

◆ TBM: SET MAG NAIL AND SHINER ALONG COLUMBUS STREET, AS SHOWN. ELEVATION = 132.15'

**BASIS OF BEARINGS:**


THE BEARING S43°47'30"W BETWEEN TWO FOUND BRASS DISK MONUMENTS, AS SHOWN ON THAT CERTAIN RECORD OF SURVEY FILED IN VOLUME 8 OF L.L.S. MAPS AT PAGES 108-111, WAS USED AS THE BASIS OF BEARINGS FOR THIS SURVEY.

**LEGEND:**

- SET 3/4" IP WITH PLASTIC PLUG "LS 7701" AND TACK PER 43 LLS 73
- A/C ASPHALTIC CONCRETE
- BW BACK OF WALK
- CB CATCH BASIN
- CIP CAST IRON PIPE
- OMP CORRUGATED METAL PIPE
- CONC CONCRETE
- CO CLEAN-OUT
- DI DROP INLET
- EM ELECTRIC METER
- FD FOUND
- FF FINISHED FLOOR
- FL FLOW LINE
- FH FIRE HYDRANT
- GA GUY ANCHOR
- GM GAS METER
- GRD GROUND
- HCR HANDICAP RAMP
- INV INVERT
- IP IRON PIPE
- JP JOINT POLE
- LAT. LATERAL
- LC LIP OF GUTTER
- O/H OVERHEAD
- P.U.E. PUBLIC UTILITIES EASEMENT
- RCP REINFORCED CONCRETE PIPE
- RET. WALL RETAINING WALL
- R/W RIGHT OF WAY
- SSCO SANITARY SEWER CLEAN-OUT
- SSMH SANITARY SEWER MANHOLE
- SDMH STORM DRAIN MANHOLE
- TBC TOP BACK OF CURB
- T/W TOP OF WALL
- U/G UNDERGROUND
- VCP VITRIFIED CLAY PIPE
- WV WATER VALVE
- WM WATER METER BOX
- CTV- CABLE TELEVISION LINE
- E- ELECTRICAL LINE
- G- GAS LINE
- SS- SANITARY SEWER LINE
- SD- STORM DRAIN LINE
- T- TELEPHONE LINE
- W- WATER LINE



**UTILITY NOTE:**

THE UTILITIES EXISTING ON THE SURFACE AND SHOWN ON THIS DRAWING HAVE BEEN LOCATED BY FIELD SURVEY. ALL UNDERGROUND UTILITIES SHOWN ON THIS DRAWING ARE FROM RECORDS OF THE VARIOUS UTILITY COMPANIES AND THE SURVEYOR DOES NOT ASSUME RESPONSIBILITY FOR THEIR COMPLETENESS, INDICATED LOCATION, OR SIZE. RECORD UTILITY LOCATION SHOULD BE CONFIRMED BY EXPOSING THE UTILITY.

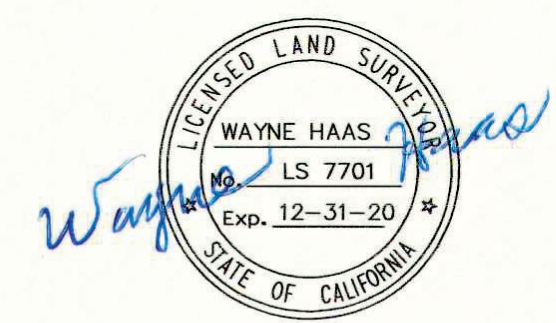

12/23/19  
**AS BUILT SURVEY**  
 LANDS OF ABOLMOLUKI  
 DOCUMENT # 2016-058252 O.R.  
 LOTS 33 AND 34, BLOCK 20  
 "PLAT OF SUBDIVISION NO. 1 OF GRANADA"  
 VOLUME 5 OF MAPS AT PAGE 43  
 ASSESSOR'S PARCEL NUMBER: 047-275-050  
 (1120 COLUMBUS STREET, EL GRANADA)  
 UNINCORPORATED SAN MATEO COUNTY CALIFORNIA  
 SCALE: 1" = 10' DECEMBER, 2019

**B & H SURVEYING, INC.**  
 PROFESSIONAL LAND SURVEYING  
 901 WALTERMIRE ST.  
 BELMONT, CA 94002  
 OFFICE (650) 637-1590

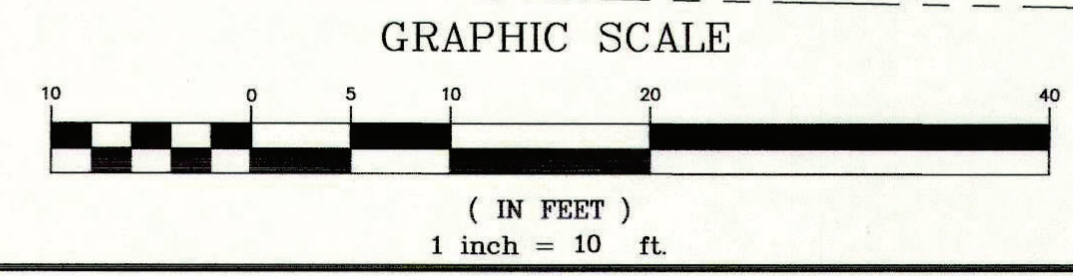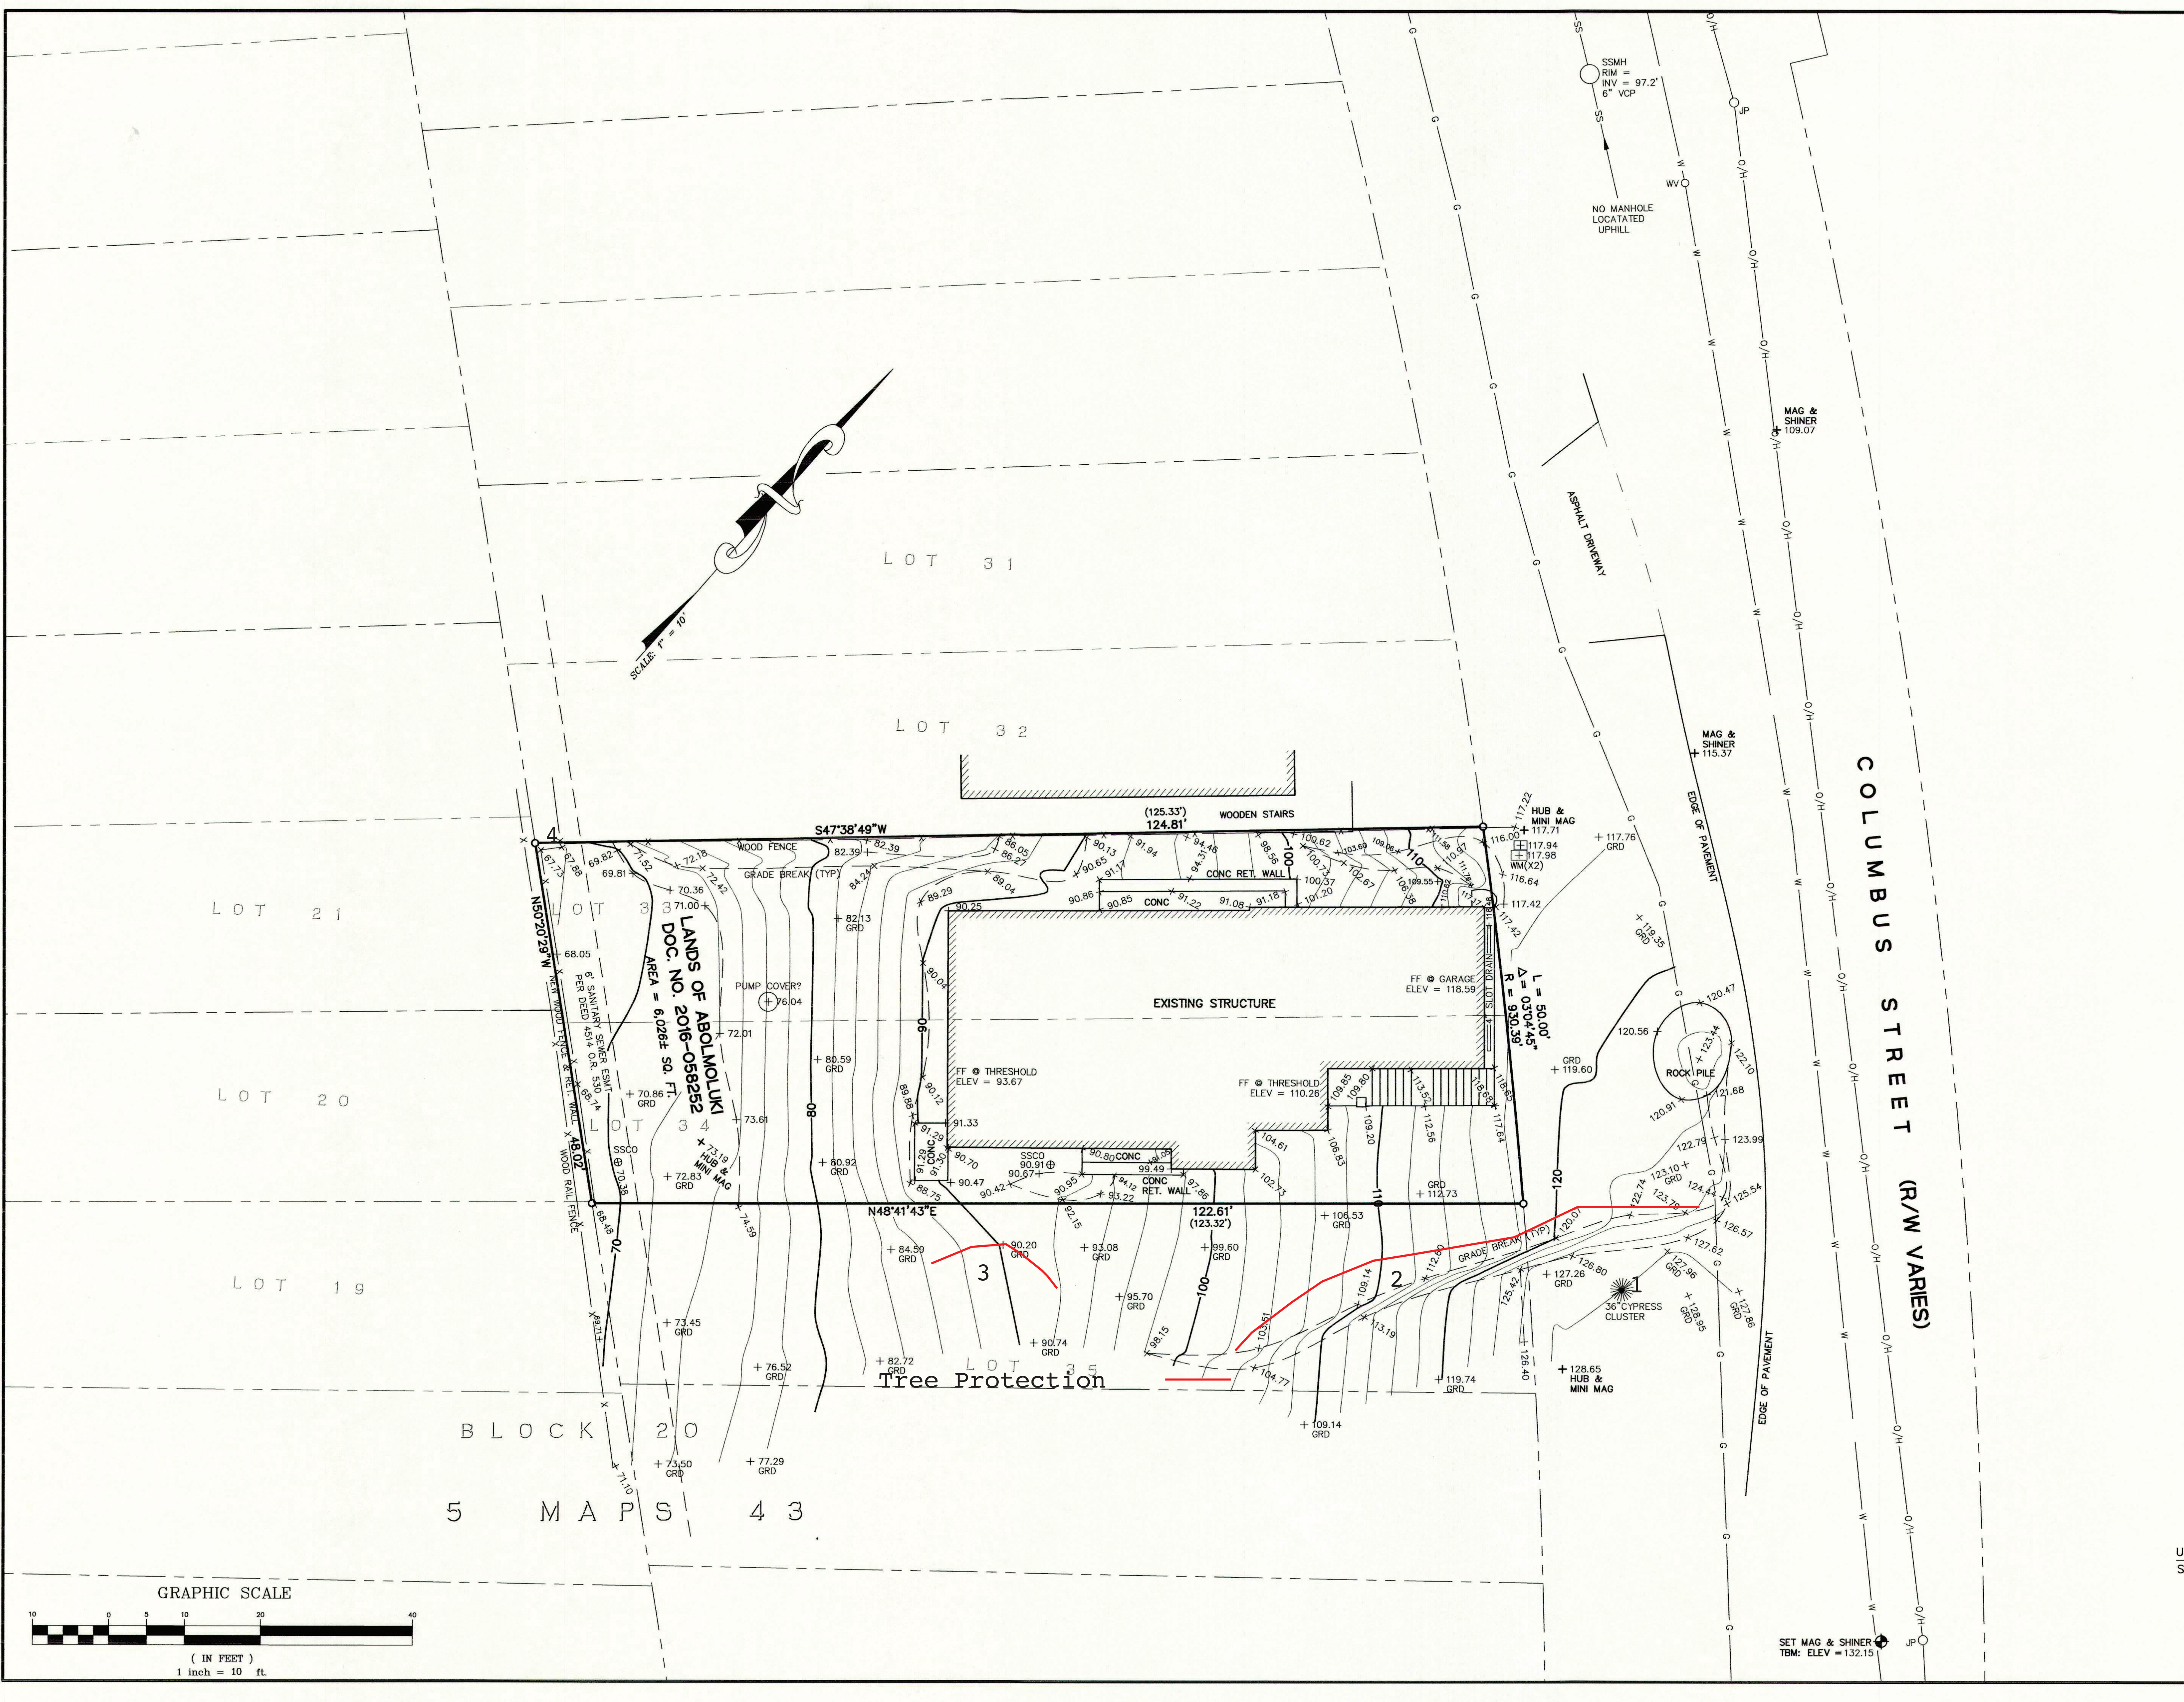

RECEIVED

November 2, 2020

San Mateo County  
Planning Division

BLOCK 20  
5 MAPS 43

**GRADING QUANTITIES:**

	CUT (C.Y. ±)	FILL (C.Y.±)
GARAGE PAD	10 C.Y.	0
BUILDING PAD	220 C.Y.	0
NEW DRIVEWAY	45 C.Y.	0
YARD GRADING	10 C.Y.	0
<b>TOTAL</b>	<b>285 C.Y. ±</b>	<b>0</b>

EXPORT = 285 C.Y. ±

**UTILITY NOTE:**

THE UTILITIES EXISTING ON THE SURFACE AND SHOWN ON THIS DRAWING HAVE BEEN LOCATED BY FIELD SURVEY. ALL UNDERGROUND UTILITIES SHOWN ON THIS DRAWING ARE FROM RECORDS OF THE VARIOUS UTILITY COMPANIES AND THE SURVEYOR/ENGINEER DOES NOT ASSUME RESPONSIBILITY FOR THEIR COMPLETENESS, INDICATED LOCATION, OR SIZE. RECORD UTILITY LOCATION SHOULD BE CONFIRMED BY EXPOSING THE UTILITY.

**SURVEY NOTE:**

THE EXISTING TOPOGRAPHIC INFORMATION SHOWN ON THIS PLAN WAS TAKEN FROM A BOUNDARY & TOPOGRAPHIC SURVEY PLAN PREPARED BY B&H LAND SURVEYING, INC., DATED SEPTEMBER 2016, JOB. NO. 6997-16.

**GENERAL NOTES:**

- ALL MATERIALS SHALL BE FURNISHED BY AND INSTALLED BY THE CONTRACTOR UNLESS OTHERWISE NOTED.
- WHEN APPLICABLE, ALL CONSTRUCTION MATERIALS AND METHODS SHALL COMPLY WITH THE ORDINANCES, SPECIFICATIONS AND STANDARDS OF THE COUNTY OF SAN MATEO, UNLESS OTHERWISE NOTED.
- CONTRACTOR SHALL NOTIFY UNDERGROUND SERVICE ALERT (U.S.A.) PRIOR TO START OF CONSTRUCTION. PHONE (800) 642-2444.
- THE CONTRACTOR SHALL BE RESPONSIBLE FOR DISTRIBUTING ANY EXCESS MATERIAL OR SUPPLYING MATERIAL FOR DEFICIENCIES TO BRING DRIVEWAY AND BUILDING PADS TO REQUIRED GRADE.
- THE CONTRACTOR IS RESPONSIBLE FOR MATCHING EXISTING SURROUNDING LANDSCAPE AND OTHER IMPROVEMENTS WITH A SMOOTH TRANSITION IN PAVING, GRADING, ETC., AND TO AVOID ABRUPT OR APPARENT CHANGES OR CROSS SLOPES, LOW SPOTS OR HAZARDOUS CONDITIONS.
- THE CONTRACTOR SHALL OBTAIN ALL NECESSARY PERMITS FOR ALL WORK SHOWN ON THIS PLAN.
- ALL STORM DRAIN PIPES SHALL BE PVC SDR 35 WITH BELL AND SPIGOT RUBBER GASKET JOINTS PER ASTM D3034 OR BETTER.

**GEOTECHNICAL ENGINEER'S NOTE:**

THE GEOTECHNICAL SITE INVESTIGATION REPORT PREPARED BY J. YANG AND ENGINEERS, PROJECT NO. J16-1625, DATED JANUARY 25, 2017, SHALL BE MADE A PART OF THIS PLAN.

**GRADING PLAN LEGEND:**


BS	BOTTOM OF STEP
COTG	CLEANOUT TO GRADE
DS	DOWNSPOUT
FF	FINISH FLOOR
FG	FINISH GRADE
FL	FLOWLINE
FP	FINISH PAVE
GB	GRADE BREAK
INV	INVERT
TG	TOP OF GRADE
TS	TOP OF STEP
TW	TOP OF WALL
WM	WATER METER
SS	SANITARY SEWER LINE
W	WATER LINE
120	NEW CONTOUR
JT	JOINT TRENCH
G	GAS LINE
---	NEW STORM DRAIN LINE
---	NEW DRAIN INLET
---	SWALE
---	SURFACE RUNOFF FLOW DIRECTION
---	EXIST. TREE TO BE REMOVED
---	EXIST. GRADE

**SURVEY LEGEND:**



●	FOUND IRON PIPE OR REBAR, AS NOTED
○	FOUND 2" BRASS DISK WITH PUNCH, IN CASING
A/C	SET PER 8 LLS 108 - 111
BW	ASPHALTIC CONCRETE
CB	BACK OF WALK
CP	CATCH BASIN
CMP	CAST IRON PIPE
CONC	CORRUGATED METAL PIPE
CO	CONCRETE
DI	CLEAN-OUT
EM	DROP INLET
FD	ELECTRIC METER
FF	FOUND
FL	FINISHED FLOOR
FL	FLOW LINE
GH	FIRE HYDRANT
GA	GUY ANCHOR
GM	GAS METER
GRD	GROUND
HCR	HANDICAP RAMP
INV	INVERT
IP	IRON PIPE
JP	JOINT POLE
LAT.	LATERAL
LG	LIP OF GUTTER
O/H	OVERHEAD
P.U.E.	PUBLIC UTILITIES EASEMENT
RP	REINFORCED CONCRETE PIPE
RET. WALL	RETAINING WALL
R/W	RIGHT OF WAY
SSCO	SANITARY SEWER CLEAN-OUT
SSMH	SANITARY SEWER MANHOLE
SDMH	STORM DRAIN MANHOLE
TBC	TOP BACK OF CURB
T/W	TOP OF WALL
U/G	UNDERGROUND
VCP	VITRIFIED CLAY PIPE
WM	WATER METER
WM	WATER METER BOX
-E-	CABLE TELEVISION LINE
-E-	ELECTRICAL LINE
-G-	GAS LINE
-SS-	SANITARY SEWER LINE
-SD-	STORM DRAIN LINE
-T-	TELEPHONE LINE
-W-	WATER LINE

**CONSTRUCTION NOTES:**

- INSTALL 6" WIDE TRENCH DRAIN WITH TRAFFIC RATED GRATE COVER BY "NDS" OR APPROVED EQUAL.
- DAYLIGHT END OF 4" DIA. PERFORATED PVC PIPE AND INSTALL 2' X 3' ROCK RIPRAP DISSIPATER.
- INSTALL 4" DIA. PERF. PVC SUBDRAIN PIPE AT 1% MIN. SLOPE.
- CONNECT DOWNSPOUT TO NEW STORM DRAIN PIPE WITH 4" PVC AT 1% MIN. SLOPE (TYPICAL).

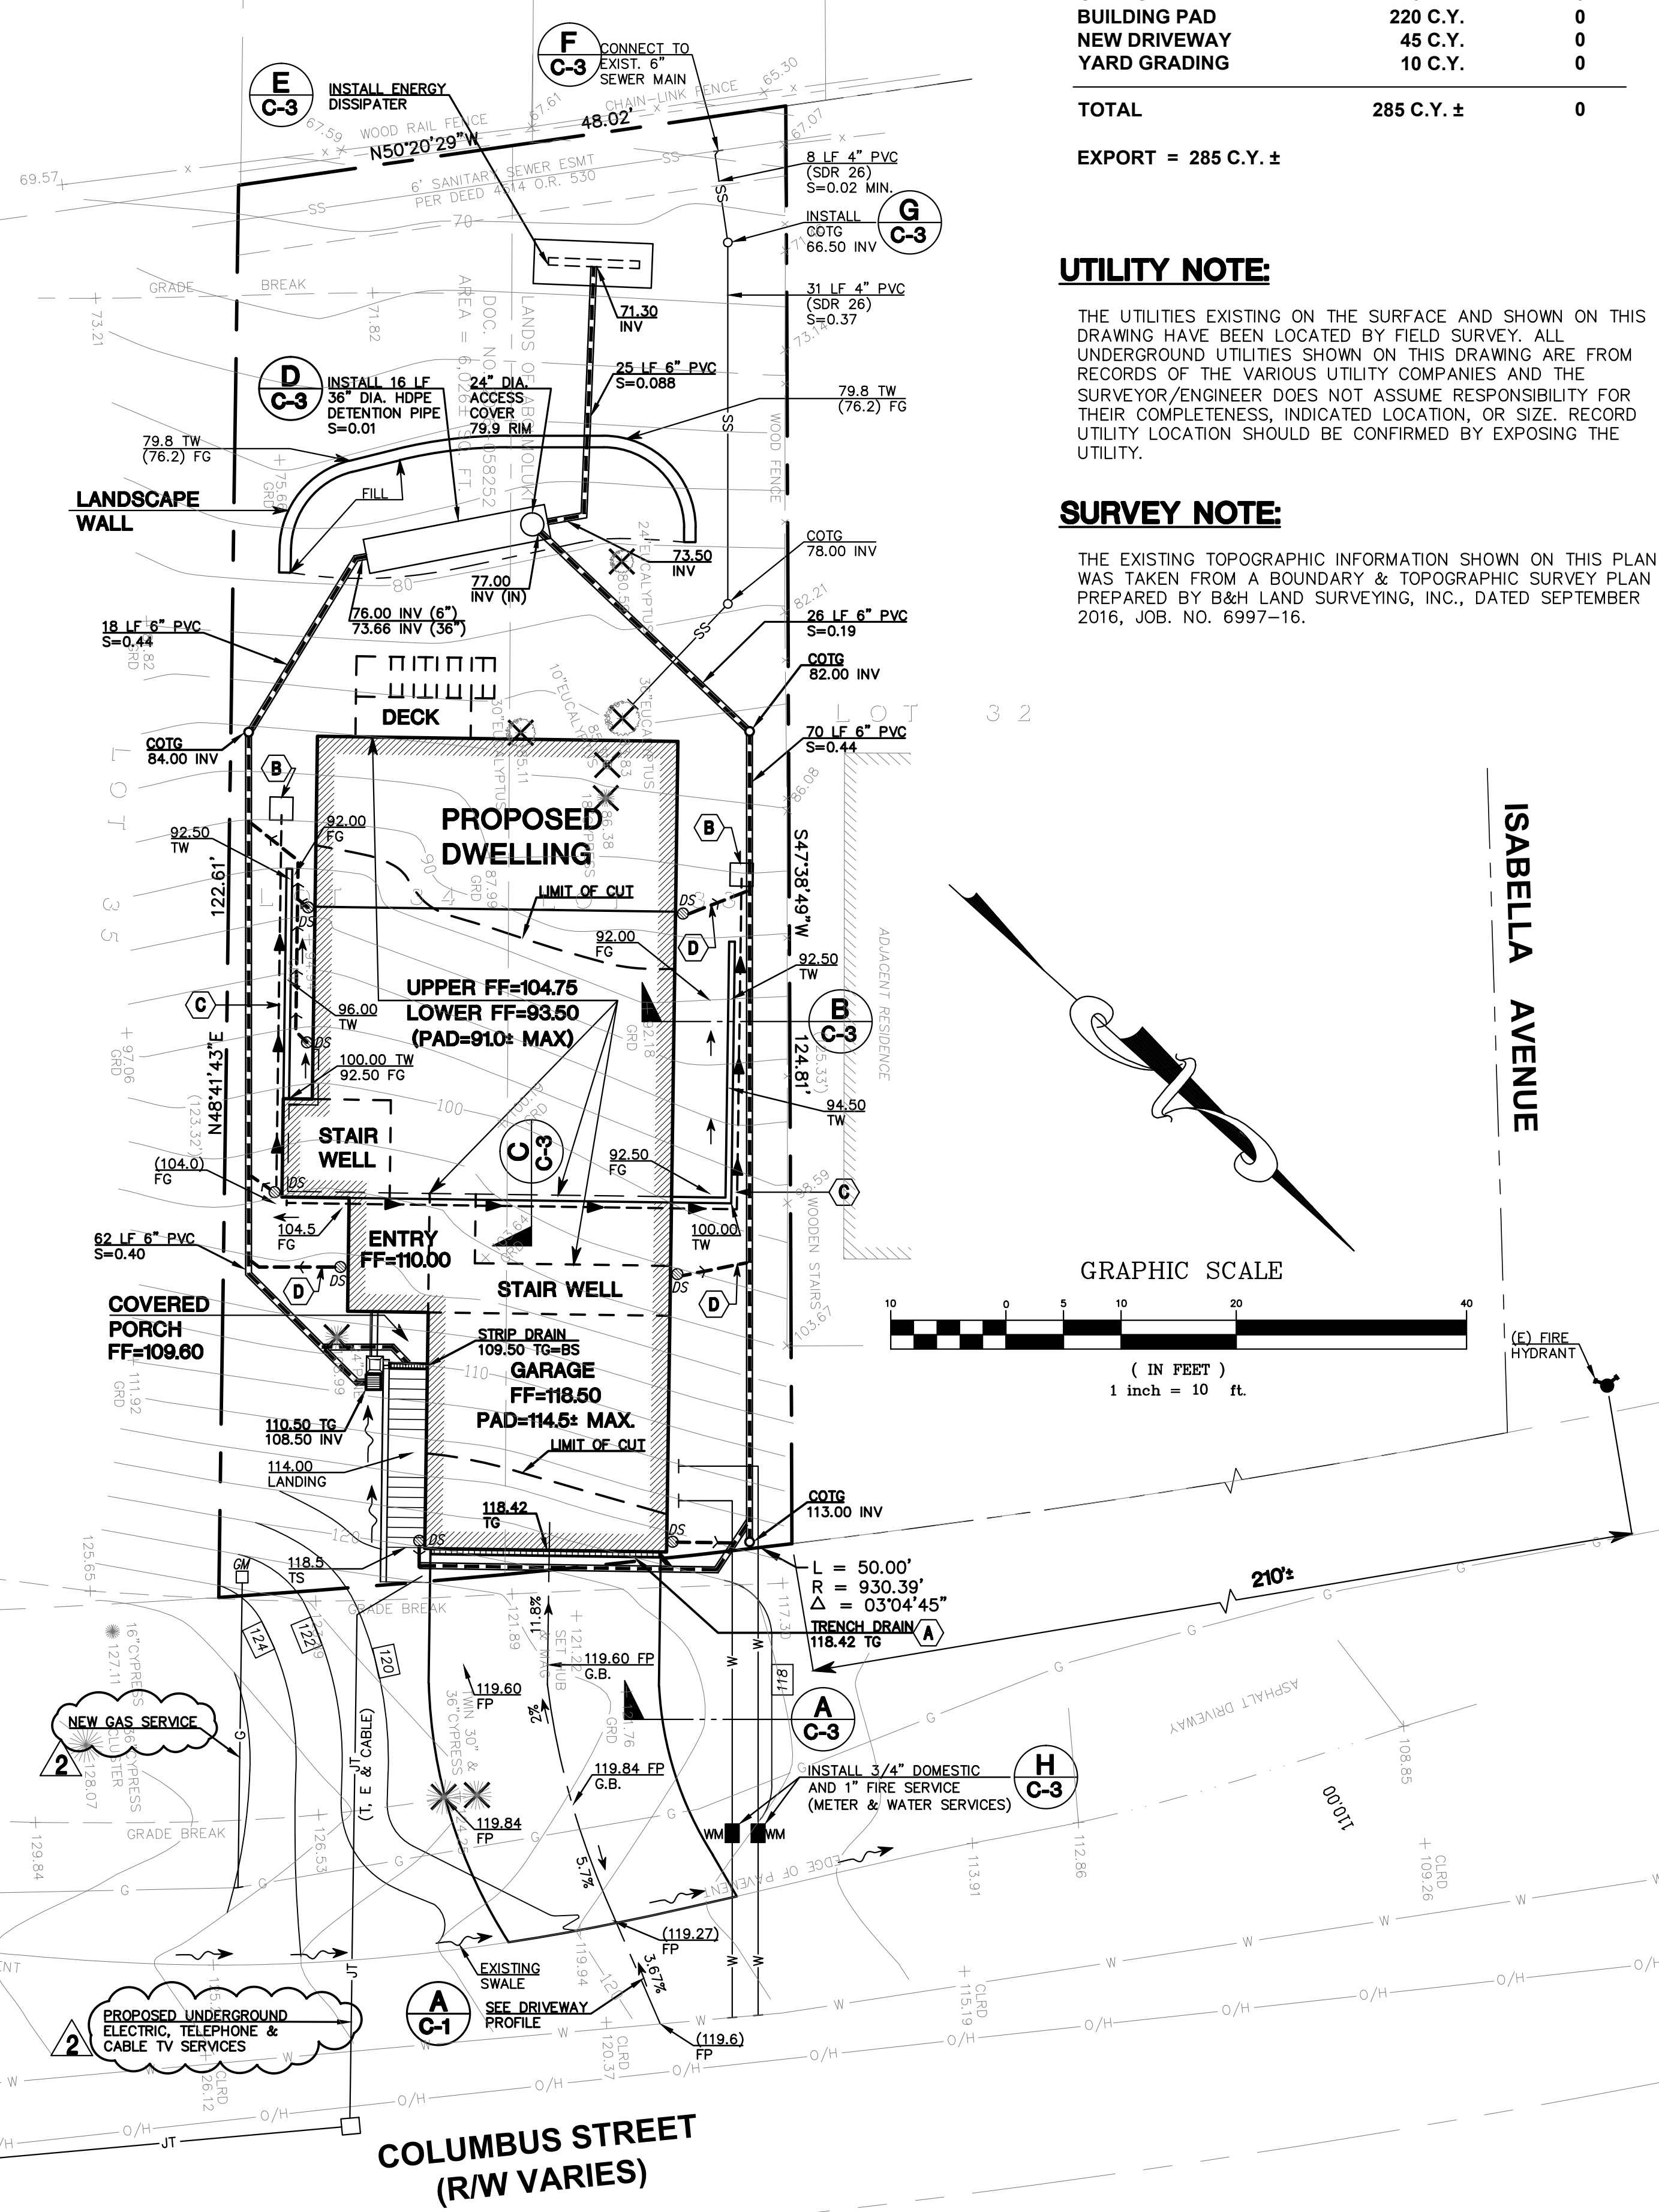

**GRAPHIC SCALE**

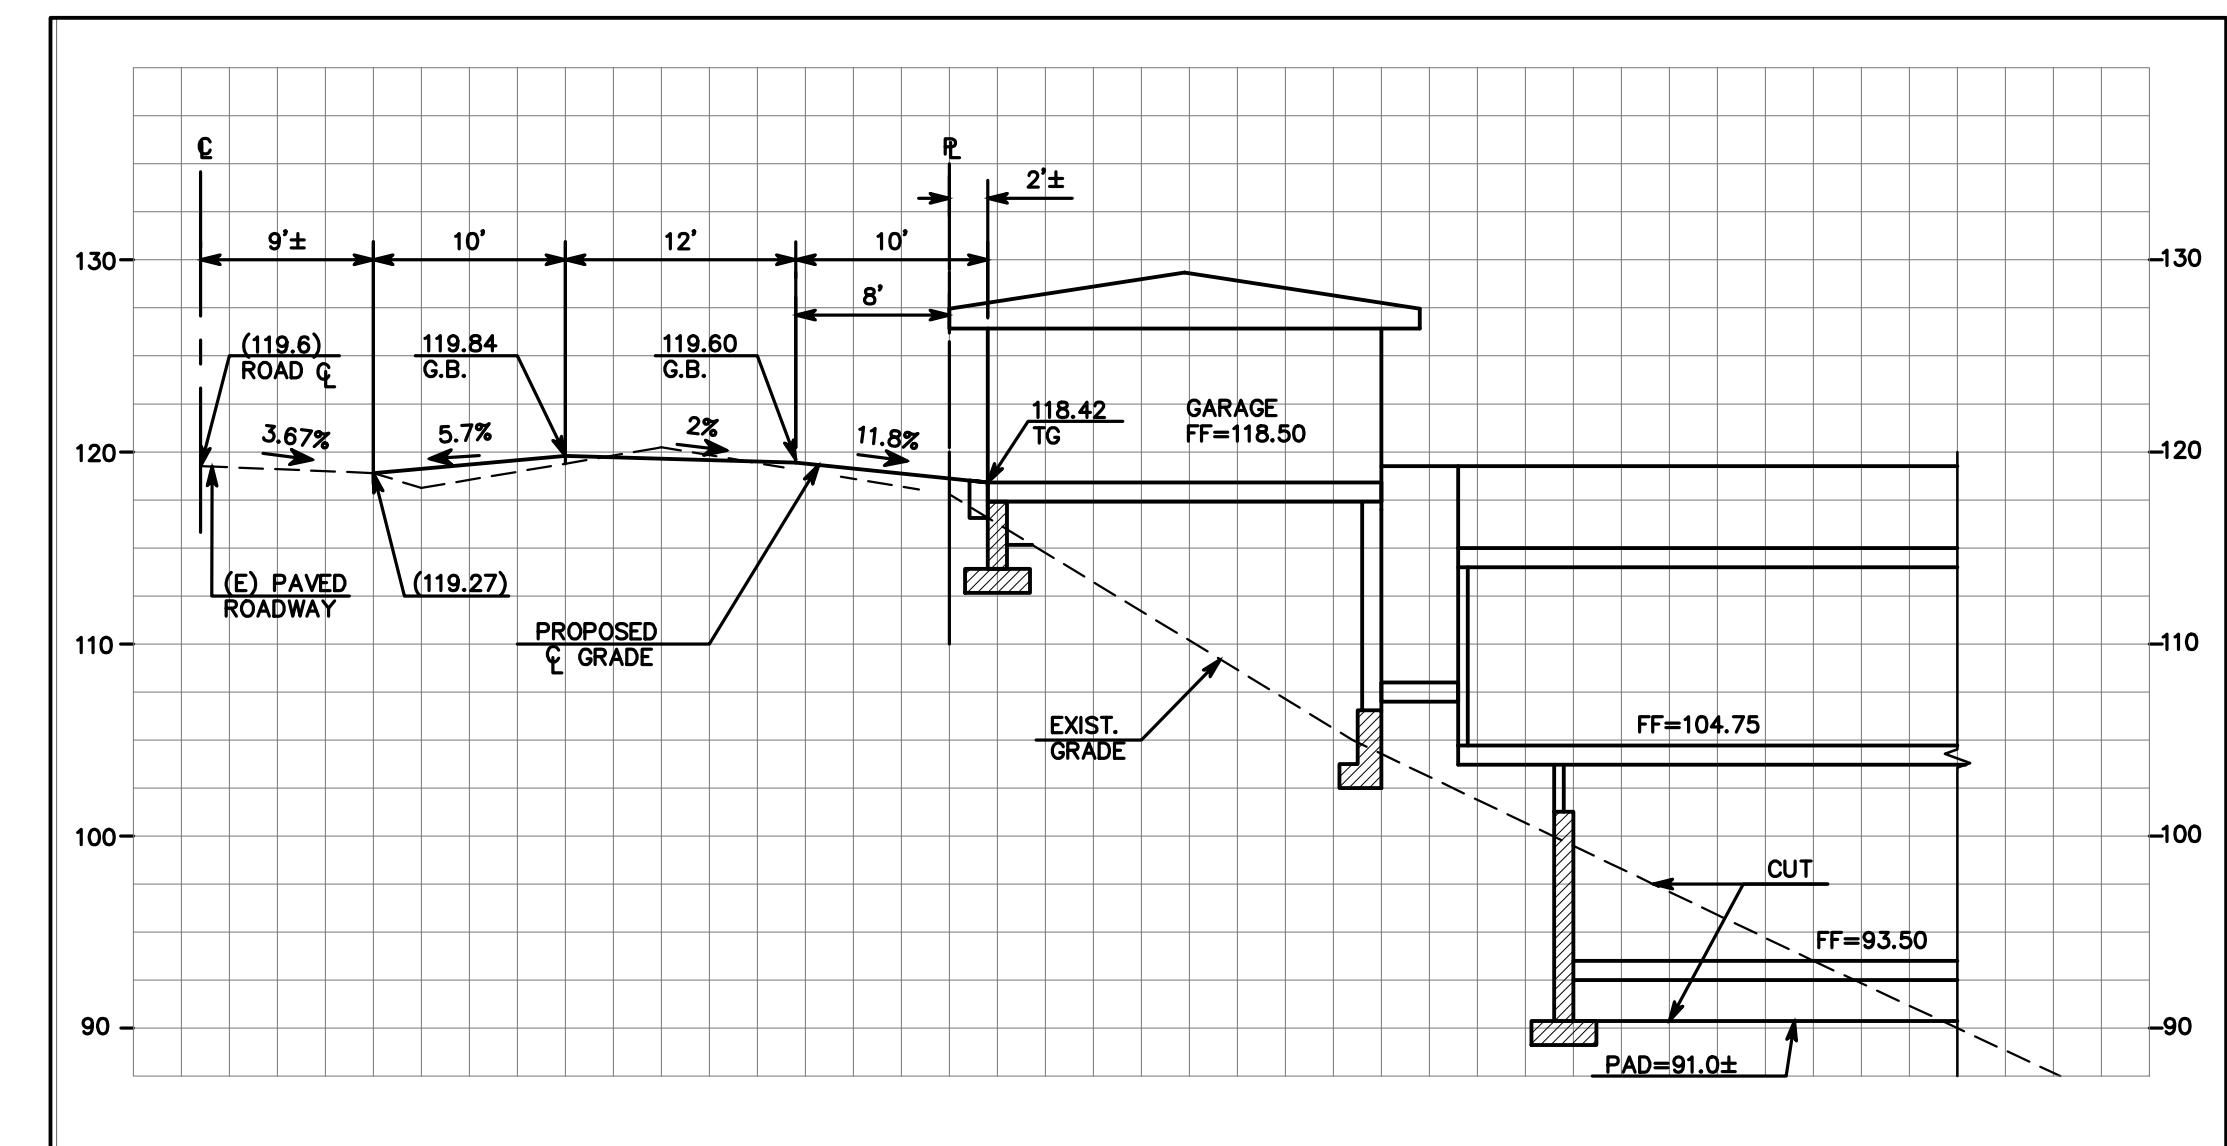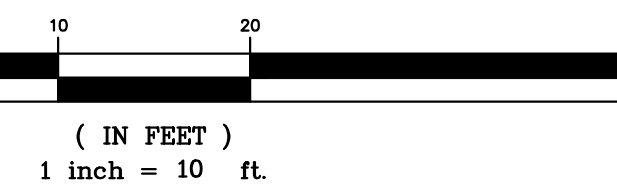

**A DRIVEWAY PROFILE**  
SCALE (VERTICAL & HORIZONTAL): 1"=10'

Originally Approved Grading Plans (PLN2017-00296)

C-1

DATE: 10/29/18  
BY: VPG  
DESCRIPTION: NEW GAS & JOINT TRENCH LOCATIONS

REGISTERED PROFESSIONAL ENGINEER  
No. 35048  
CIVIL  
STATE OF CALIFORNIA


**MACLEOD AND ASSOCIATES**  
CIVIL ENGINEERING • LAND SURVEYING  
965 CENTER STREET • SAN CARLOS, CA 94070 • (650) 593-8560

PREPARED FOR:  
BAHRAM ABOLMOLUKI

**GRADING, DRAINAGE AND UTILITY PLAN**

COLUMBUS STREET  
A.P.N. 047-275-050  
UNINCORPORATED SAN MATEO COUNTY CALIFORNIA

DRAWN BY: DJK/AAP  
DESIGNED BY: VPG  
CHECKED BY: DGM  
SCALE: 1"=10'  
DATE: 08/24/18  
DRAWING NO. 4452-GRAD  
SHEET 1 OF 4

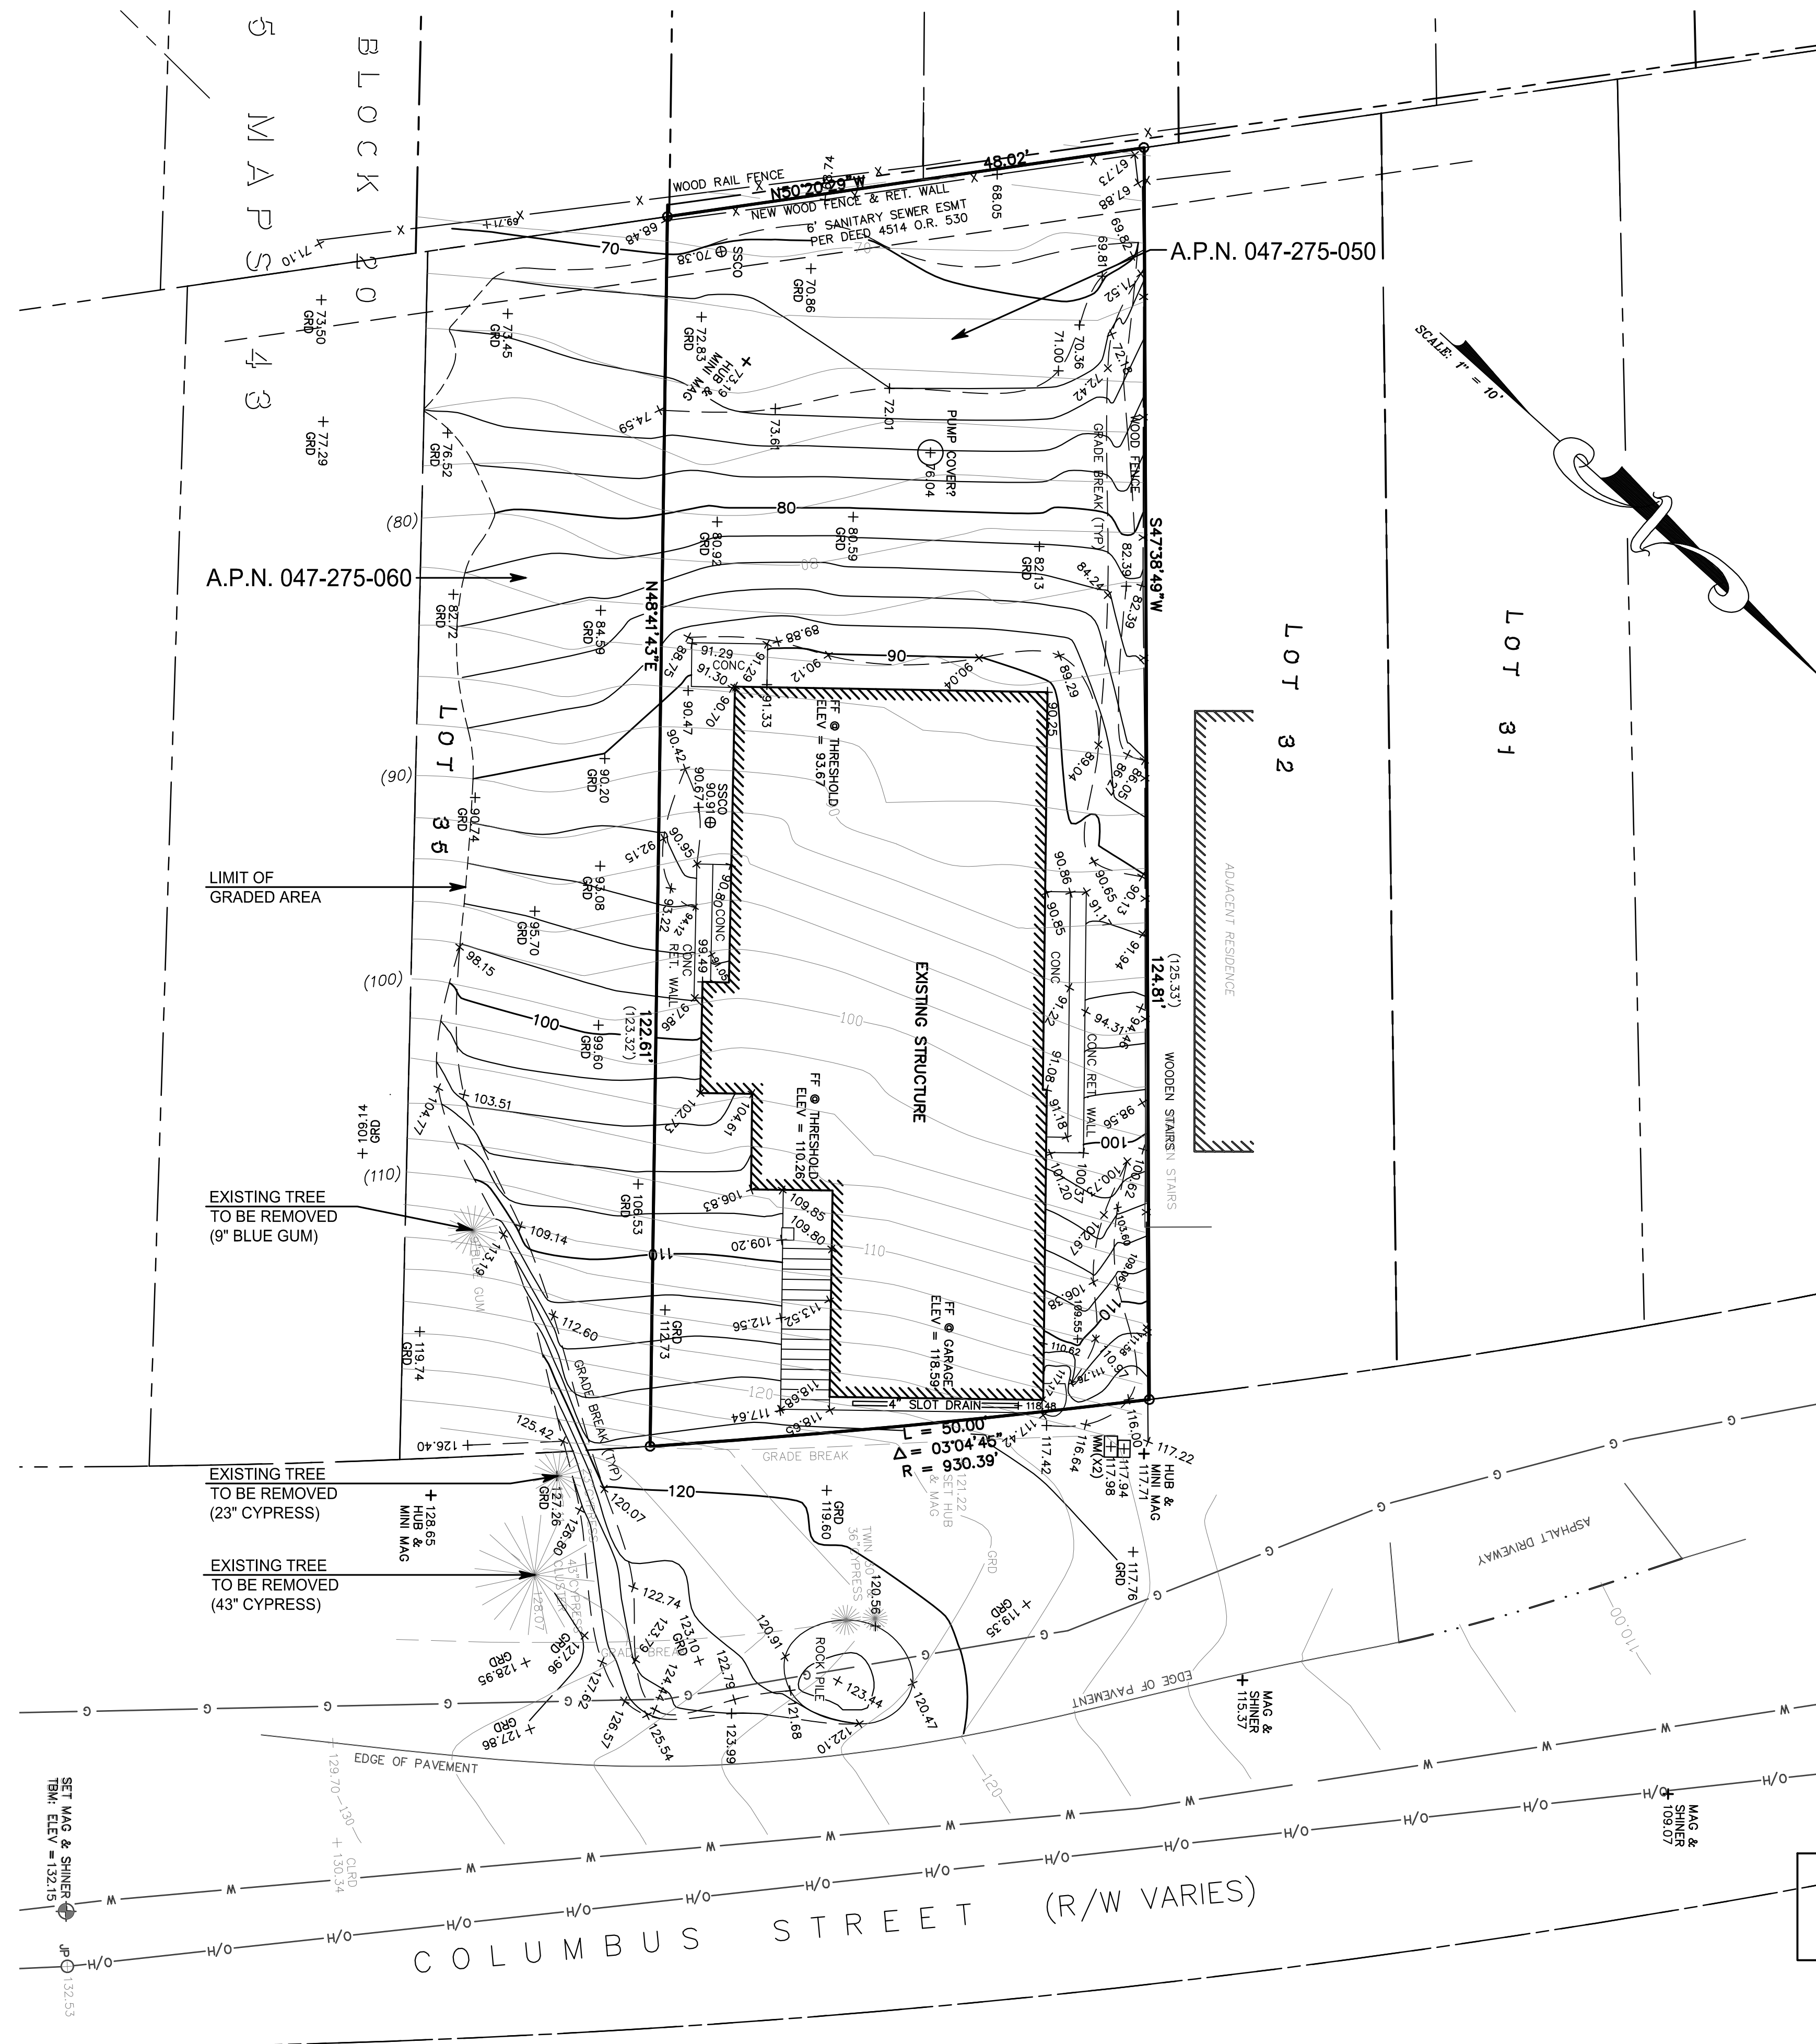

**GRADING QUANTITIES:**

APN 047-275-060

MAIN LOT	CUT	FILL
70	25	
STREET FRONTAGE	25	0
TOTAL	95 C.Y. ±	25 C.Y. ±

EXPORT = 95 - 25  
= 70 C.Y. ±


**GRADING QUANTITIES:**

APN 047-275-050

MAIN LOT	CUT	FILL
0	100	
FRONT YARD	30	0
STREET FRONTAGE	20	0
TOTAL	50 C.Y. ±	100 C.Y. ±

IMPORT = 100 - 50  
= 50 C.Y. ±

REV.	DESCRIPTION	BY:	DATE:

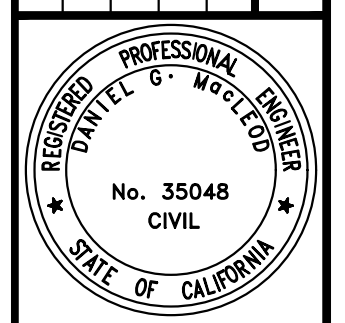

**MACLEOD AND ASSOCIATES**  
CIVIL ENGINEERING • LAND SURVEYING  
965 CENTER STREET • SAN CARLOS, CA 94070 • (650) 593-8580


PREPARED FOR:  
BAHRAM ABOLMOLUKI

**GRADING PLAN**  
COLUMBUS STREET  
A.P.N. 047-275-050  
UNINCORPORATED SAN MATEO COUNTY CALIFORNIA

DRAWN BY: DJK/AAP  
DESIGNED BY: VPG  
CHECKED BY: DGM  
SCALE: 1"=10'  
DATE: 11/02/20  
DRAWING NO. 4452-GRAD  
SHEET 1 OF 1

**UNPERMITTED GRADING EXHIBIT**

**C-1**

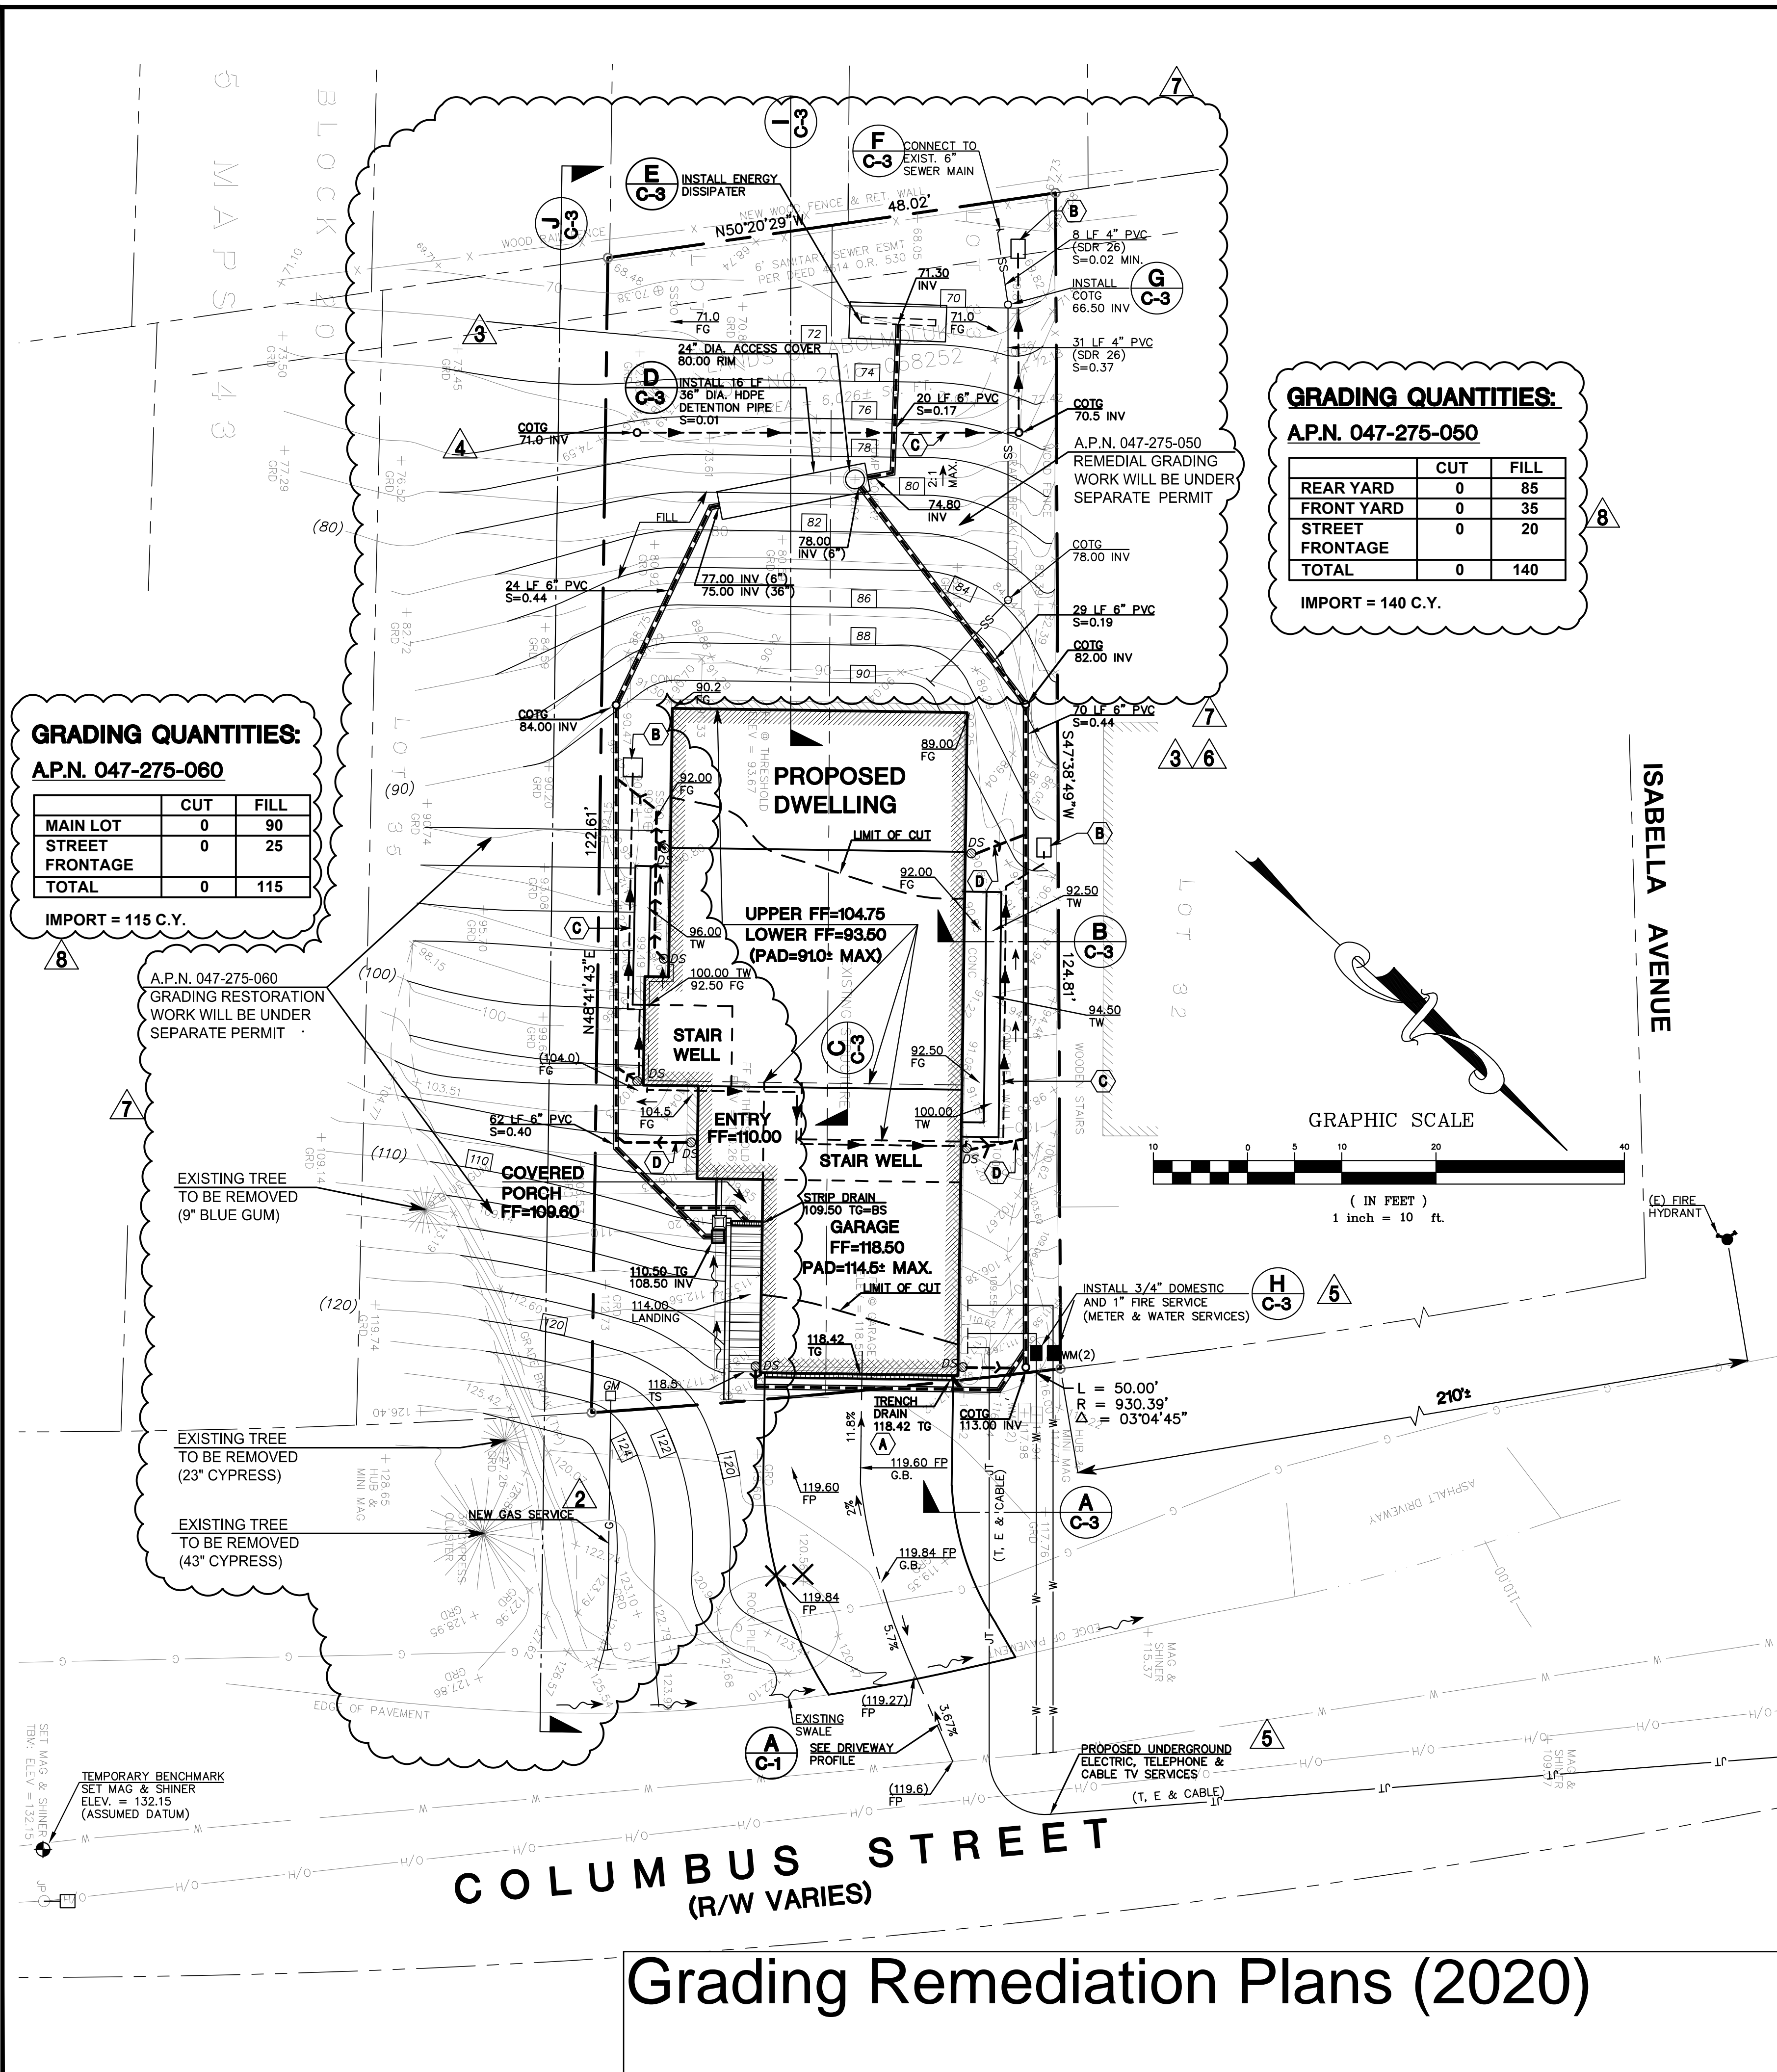

**GRADING QUANTITIES:**  
A.P.N. 047-275-050

	CUT	FILL
REAR YARD	0	85
FRONT YARD	0	35
STREET FRONTAGE	0	20
<b>TOTAL</b>	<b>0</b>	<b>140</b>

IMPORT = 140 C.Y.

**GRADING QUANTITIES:**  
A.P.N. 047-275-060

	CUT	FILL
MAIN LOT	0	90
STREET FRONTAGE	0	25
<b>TOTAL</b>	<b>0</b>	<b>115</b>

IMPORT = 115 C.Y.

**GENERAL NOTES:**

- ALL MATERIALS SHALL BE FURNISHED BY AND INSTALLED BY THE CONTRACTOR UNLESS OTHERWISE NOTED.
- WHEN APPLICABLE, ALL CONSTRUCTION MATERIALS AND METHODS SHALL COMPLY WITH THE ORDINANCES, SPECIFICATIONS AND STANDARDS OF THE COUNTY OF SAN MATEO, UNLESS OTHERWISE NOTED.
- CONTRACTOR SHALL NOTIFY UNDERGROUND SERVICE ALERT (U.S.A.) PRIOR TO START OF CONSTRUCTION. PHONE (800) 642-2444.
- THE CONTRACTOR SHALL BE RESPONSIBLE FOR DISTRIBUTING ANY EXCESS MATERIAL OR SUPPLYING MATERIAL FOR DEFICIENCIES TO BRING DRIVEWAY AND BUILDING PADS TO REQUIRED GRADE.
- THE CONTRACTOR IS RESPONSIBLE FOR MATCHING EXISTING SURROUNDING LANDSCAPE AND OTHER IMPROVEMENTS WITH A SMOOTH TRANSITION IN PAVING, GRADING, ETC., AND TO AVOID ABRUPT OR APPARENT CHANGES OR CROSS SLOPES, LOW SPOTS OR HAZARDOUS CONDITIONS.
- THE CONTRACTOR SHALL OBTAIN ALL NECESSARY PERMITS FOR ALL WORK SHOWN ON THIS PLAN.
- ALL STORM DRAIN PIPES SHALL BE PVC SDR 35 WITH BELL AND SPIGOT RUBBER GASKET JOINTS PER ASTM D3034 OR BETTER.

**UTILITY NOTE:**

THE UTILITIES EXISTING ON THE SURFACE AND SHOWN ON THIS DRAWING HAVE BEEN LOCATED BY FIELD SURVEY. ALL UNDERGROUND UTILITIES SHOWN ON THIS DRAWING ARE FROM RECORDS OF THE VARIOUS UTILITY COMPANIES AND THE SURVEYOR/ENGINEER DOES NOT ASSUME RESPONSIBILITY FOR THEIR COMPLETENESS, INDICATED LOCATION, OR SIZE. RECORD UTILITY LOCATION SHOULD BE CONFIRMED BY EXPOSING THE UTILITY.

**SURVEY NOTE:**

THE EXISTING TOPOGRAPHIC INFORMATION SHOWN ON THIS PLAN WAS TAKEN FROM A BOUNDARY & TOPOGRAPHIC SURVEY PLAN PREPARED BY B&H LAND SURVEYING, INC., DATED SEPTEMBER 2016, JOB. NO. 6997-16.

**GEOTECHNICAL ENGINEER'S NOTE:**

THE GEOTECHNICAL SITE INVESTIGATION REPORT PREPARED BY J. YANG AND ENGINEERS, PROJECT NO. J16-1625, DATED JANUARY 25, 2017, SHALL BE MADE A PART OF THIS PLAN.

**CONSTRUCTION NOTES:**



- (A) INSTALL 6" WIDE TRENCH DRAIN WITH TRAFFIC RATED GRATE COVER BY "NDS" OR APPROVED EQUAL.
- (B) DAYLIGHT END OF 4" DIA. PERFORATED PVC PIPE AND INSTALL 2' X 3' ROCK RIPRAP DISSIPATER.
- (C) INSTALL 4" DIA. PERF. PVC SUBDRAIN PIPE AT 1% MIN. SLOPE.
- (D) CONNECT DOWNSPOUT TO NEW STORM DRAIN PIPE WITH 4" PVC AT 1% MIN. SLOPE (TYPICAL).

**GRADING PLAN LEGEND:**

- BS BOTTOM OF STEP
- COTG CLEANOUT TO GRADE
- DS DOWNSPOUT
- FF FINISH FLOOR
- FG FINISH GRADE
- FL FLOWLINE
- FP FINISH PAVE
- GB GRADE BREAK
- INV INVERT
- TG TOP OF GRADE
- TS TOP OF STEP
- TW TOP OF WALL
- WM WATER METER
- SS SANITARY SEWER LINE
- W WATER LINE
- 120 NEW CONTOUR
- JT JOINT TRENCH
- G GAS LINE
- NEW STORM DRAIN LINE
- NEW DRAIN INLET
- SW SWALE
- ▲ SURFACE RUNOFF FLOW DIRECTION
- EXIST. TREE TO BE REMOVED
- EXIST. GRADE

**SURVEY LEGEND:**

- FOUND IRON PIPE OR REBAR, AS NOTED
- FOUND 2" BRASS DISK WITH PUNCH, IN CASING SET PER § 115.108
- A/C ASPHALTIC CONCRETE
- BW BACK OF WALK
- CB CATCH BASIN
- CIP CAST IRON PIPE
- CMP CORRUGATED METAL PIPE
- CONC CONCRETE
- CO CLEAN-OUT
- DI DROP INLET
- EM ELECTRIC METER
- FD FOUND
- FF FINISHED FLOOR
- FL FLOW LINE
- FH FIRE HYDRANT
- GA GUY ANCHOR
- GM GAS METER
- GRD GROUND
- HCR HANDICAP RAMP
- INV INVERT
- IP IRON PIPE
- JP JOINT POLE
- LAT. LATERAL
- LG LIP OF GUTTER
- O/H OVERHEAD
- P.U.E. PUBLIC UTILITIES EASEMENT
- RCF REINFORCED CONCRETE PIPE
- RET. WALL RETAINING WALL
- R/W RIGHT OF WAY
- SSCO SANITARY SEWER CLEAN-OUT
- SSMH SANITARY SEWER MANHOLE
- SDMH STORM DRAIN MANHOLE
- TBC TOP BACK OF CURB
- T/W TOP OF WALL
- U/G UNDERGROUND
- VCP VITRIFIED CLAY PIPE
- WV WATER VALVE
- WM WATER METER BOX
- CTV CABLE TELEVISION LINE
- E ELECTRICAL LINE
- GT GAS LINE
- SSS SANITARY SEWER LINE
- SDS STORM DRAIN LINE
- T TELEPHONE LINE
- W WATER LINE

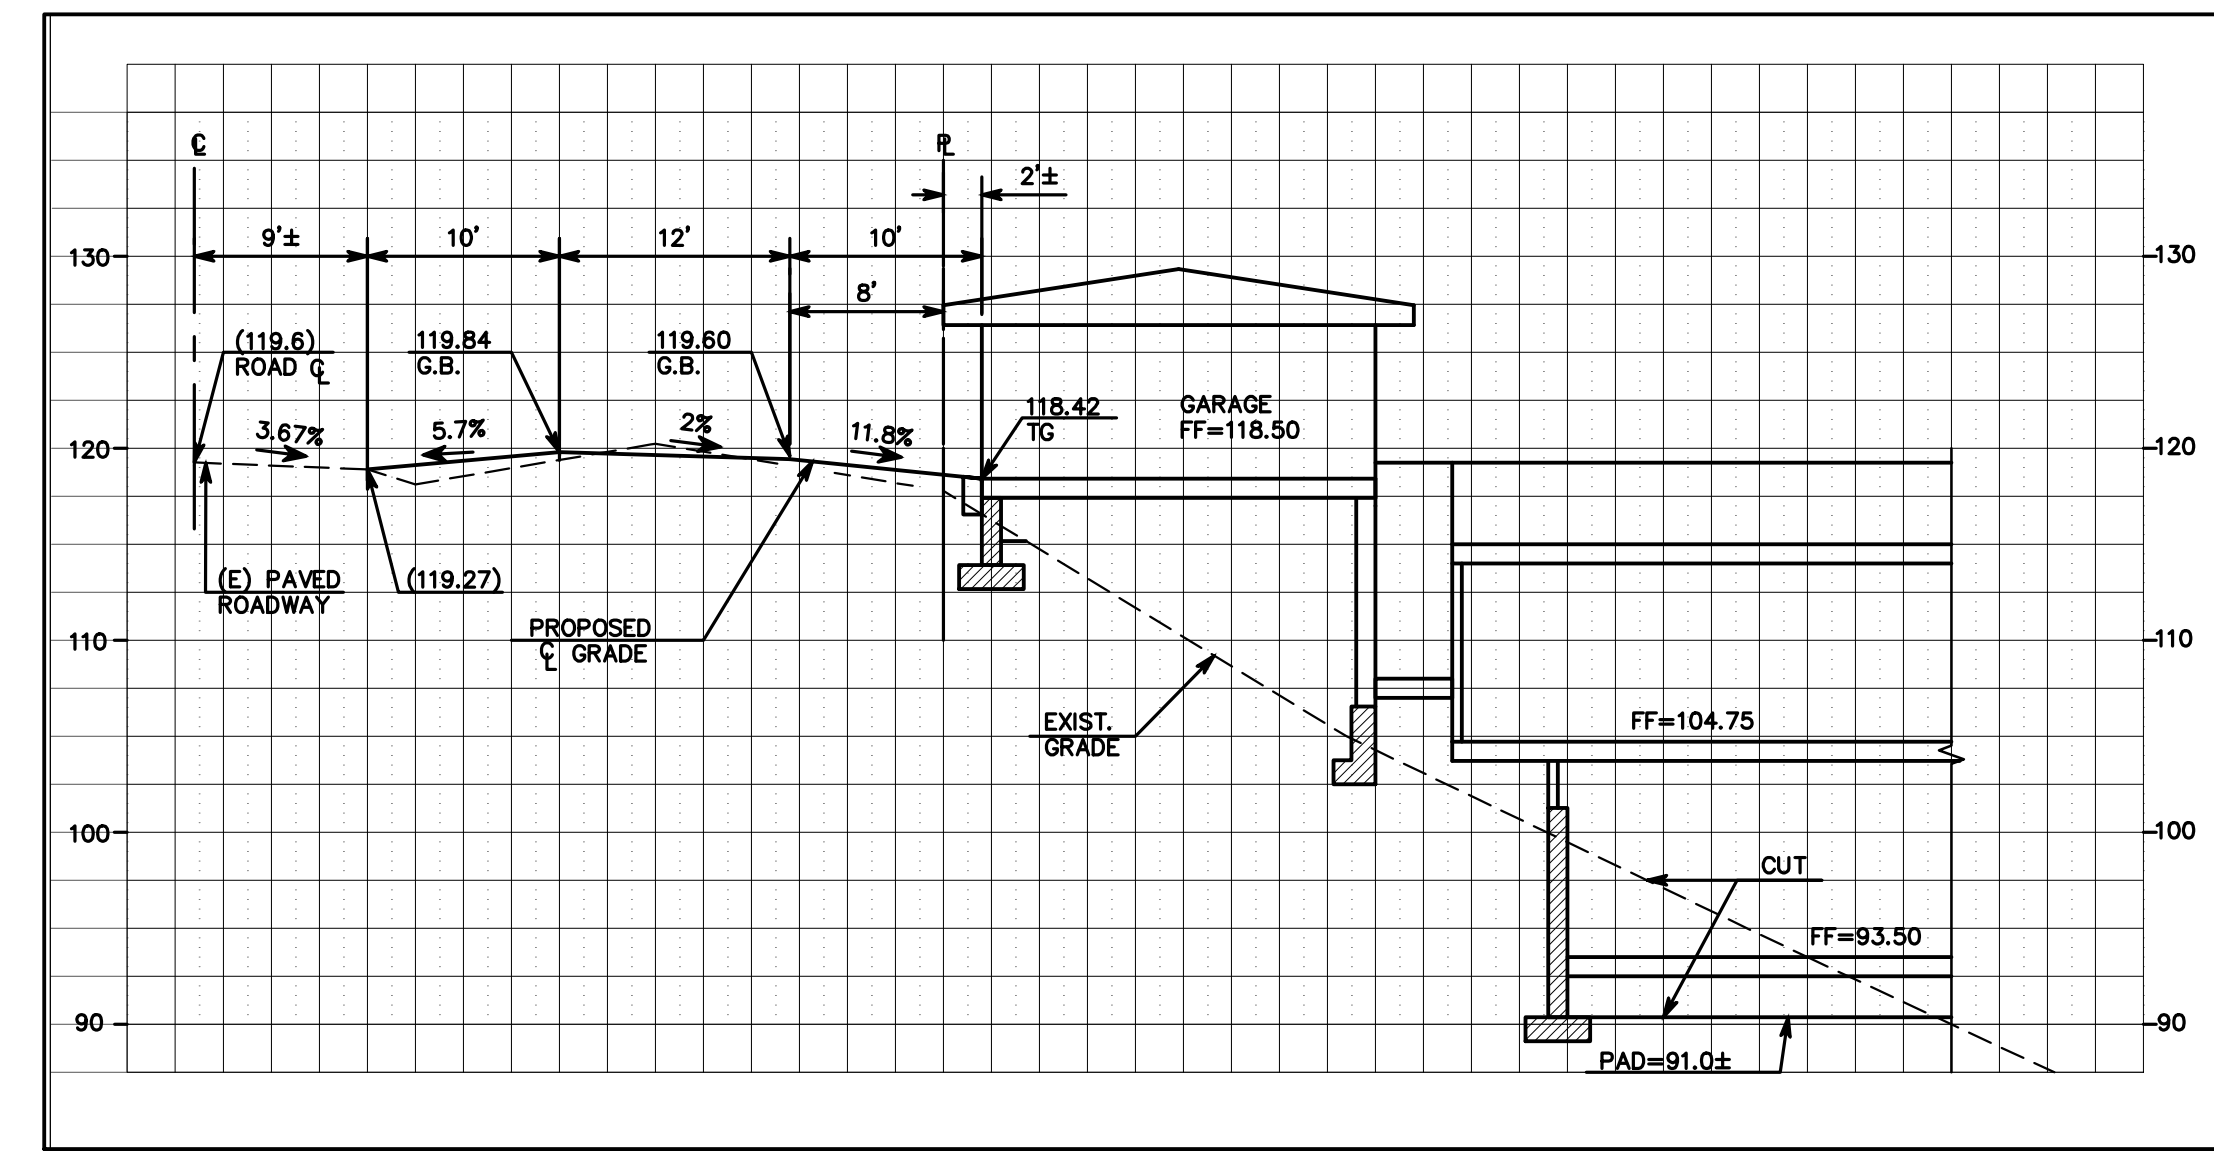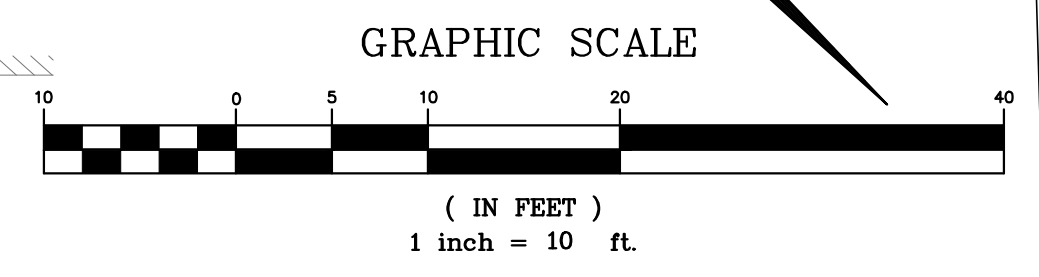

**(A) DRIVEWAY PROFILE**  
SCALE (VERTICAL & HORIZONTAL): 1"=10'

NO.	DATE	BY	DESCRIPTION
1	11/02/20	VPG	GRADING QUANTITIES
2	10/05/20	VPG	GRADING FOR APN 047-275-060 & 060
3	02/03/20	VPG	SITE REGRADING
4	10/22/19	VPG	NEW WATER & ELECTRICAL SERVICES
5	09/14/19	VPG	PER COUNTY COMMENTS
6	07/25/19	VPG	GRADING REVISION
7	07/25/19	VPG	NEW GAS & JOINT TRENCH LOCATIONS
8	10/09/18	VPG	REV.



**MACLEOD AND ASSOCIATES**  
CIVIL ENGINEERING • LAND SURVEYING  
965 CENTER STREET • SAN CARLOS, CA 94070 • (650) 593-8560

PREPARED FOR:  
BAHRAM ABOLMOLUKI

**GRADING, DRAINAGE AND UTILITY PLAN**  
COLUMBUS STREET  
A.P.N. 047-275-050  
UNINCORPORATED SAN MATEO COUNTY CALIFORNIA

DRAWN BY: DJK/AAP  
DESIGNED BY: VPG  
CHECKED BY: DGM  
SCALE: 1"=10'  
DATE: 08/24/18  
DRAWING NO. 4452-GRAD  
SHEET 1 OF 4

**C-1**

**Grading Remediation Plans (2020)**

**LEGEND:**

EXISTING TREES TO BE REMOVED

**DUST CONTROL NOTES:**



1. WATER ALL CONSTRUCTION AND GRADING AREAS AT LEAST TWICE DAILY.
2. COVER ALL TRUCKS HAULING SOIL, SAND, AND OTHER LOOSE MATERIAL, OR REQUIRE ALL TRUCKS TO MAINTAIN AT LEAST 2 FEET OF FREEBOARD.
3. ENCLOSE, COVER, WATER TWICE DAILY, OR APPLY (NON-TOXIC) BINDERS TO EXPOSED STOCKPILE (DIRT, SAND, ETC.).

**EROSION CONTROL NOTES:**

1. THE INTENT OF THE EROSION CONTROL PLAN IS TO MINIMIZE ANY WATER QUALITY IMPACTS IN THE FORM OF SEDIMENT POLLUTION TO MAIN CREEK & TRIBUTARIES.
2. A CONSTRUCTION ENTRANCE WILL BE INSTALLED PRIOR TO GRADING. LOCATION OF THE ENTRANCE MAY BE ADJUSTED BY THE CONTRACTOR TO FACILITATE GRADING OPERATIONS. ALL CONSTRUCTION TRAFFIC ENTERING THE PAVED ROAD MUST CROSS THE CONSTRUCTION ENTRANCE. THE ENTRANCE SHALL BE MAINTAINED IN A CONDITION THAT WILL PREVENT TRACKING OR FLOWING OF SEDIMENT ONTO PUBLIC RIGHTS- OF-WAY. THIS MAY REQUIRE PERIODIC TOP DRESSING WITH ADDITIONAL STONE AS CONDITION DEMAND, AND REPAIR OF ANY MEASURES USED TO TRAP SEDIMENTS.
3. WHEN NECESSARY, WHEELS SHALL BE CLEANED TO REMOVE SEDIMENT PRIOR TO ENTRANCE ONTO PUBLIC RIGHT-OF-WAY. WHEN WASHING IS REQUIRED, IT SHALL BE DONE ON AN AREA STABILIZED WITH CRUSHED STONE WHICH DRAINS INTO AN APPROVED SEDIMENT BASIN. ALL SEDIMENT SHALL BE PREVENTED FROM ENTERING ANY STORM DRAIN, DITCH, OR WATERCOURSE THROUGH THE USE OF SAND BAGS, GRAVEL, BOARDS OR OTHER APPROVED METHODS.
4. THE EROSION AND SEDIMENT CONTROL MEASURES WILL BE OPERABLE DURING THE RAINY SEASON, OCTOBER 1 TO APRIL 15. BY OCTOBER 1, GRADING AND INSTALLATION OF STORM DRAINAGE AND EROSION AND SEDIMENT CONTROL FACILITIES WILL BE COMPLETED. NO GRADING WILL OCCUR BETWEEN OCTOBER 1 AND APRIL 15 UNLESS AUTHORIZED BY THE CITY REPRESENTATIVE.
5. DURING THE RAINY SEASON, ALL PAVED AREAS WILL BE KEPT CLEAR OF EARTH MATERIAL AND DEBRIS. THE SITE WILL BE MAINTAINED SO THAT A MINIMUM OF SEDIMENT-LADEN RUNOFF ENTERS THE STORM DRAINAGE SYSTEM.
6. ALL EROSION AND SEDIMENTATION CONTROL MEASURES SHALL BE IN ACCORDANCE WITH THE EROSION AND SEDIMENT CONTROL FIELD MANUAL OF THE CALIFORNIA REGIONAL WATER QUALITY CONTROL BOARD, 4TH EDITION, DATED AUGUST 2002 OR LATER EDITION.

**SAN MATEO COUNTY STANDARD NOTES:**


1. EROSION CONTROL POINT OF CONTACT: PROJECT MANAGER: JEN JACINTO  
EMAIL: jen.babuilders@gmail.com  
OFFICE: (650) 804-8850
2. PERFORM CLEARING AND EARTH-MOVING ACTIVITIES ONLY DURING DRY WEATHER. MEASURES TO ENSURE ADEQUATE EROSION AND SEDIMENT CONTROL SHALL BE INSTALLED PRIOR TO EARTH-MOVING ACTIVITIES AND CONSTRUCTION
3. STABILIZE ALL DENUDED AREAS AND MAINTAIN EROSION CONTROL MEASURES CONTINUOUSLY BETWEEN OCTOBER 1 AND APRIL 30.
4. STORE, HANDLE, AND DISPOSE OF CONSTRUCTION MATERIALS AND WASTES PROPERLY, SO AS TO PREVENT THEIR CONTACT WITH STORMWATER.
5. CONTROL AND PREVENT THE DISCHARGE OF ALL POTENTIAL POLLUTANTS, INCLUDING PAVEMENT CUTTING WASTES, PAINTS, CONCRETE, PETROLEUM PRODUCTS, CHEMICAL, WASH WATER OR SEDIMENTS AND NON-STORMWATER DISCHARGES TO STORM DRAINS AND WATERCOURSES.
6. AVOID CLEANING, FUELING, OR MAINTAINING VEHICLES ON-SITE, EXCEPT IN A DESIGNATED AREA WHERE WASH WATER IS CONTAINED AND TREATED.
7. LIMIT AND TIME APPLICATIONS OF PESTICIDES AND FERTILIZERS TO PREVENT POLLUTED RUNOFF.
8. LIMIT CONSTRUCTION ACCESS ROUTES TO STABILIZED, DESIGNATED ACCESS POINTS.
9. AVOID CLEANING, FUELING, OR MAINTAINING VEHICLES OFF-SITE; CLEAN OFF-SITE PAVED AREAS AND SIDEWALKS USING DRY SWEEPING METHODS.
10. TRAIN AND PROVIDE INSTRUCTION TO ALL EMPLOYEES AND SUBCONTRACTORS REGARDING THE WATERSHED PROTECTION MAINTENANCE STANDARDS AND CONSTRUCTION BEST MANAGEMENT PRACTICES.
11. THE AREAS DELINEATED ON THE PLANS FOR PARKING, GRUBBING, STORAGE ETC., SHALL NOT BE ENLARGED OR "RUN OVER".
12. CONSTRUCTION SITES ARE REQUIRED TO HAVE EROSION CONTROL MATERIALS ON-SITE DURING THE "OFF-SEASON".
13. DUST CONTROL IS REQUIRED YEAR-ROUND.
14. EROSION CONTROL MATERIALS SHALL BE STORED ON-SITE.
15. USE OF PLASTIC SHEETING BETWEEN OCTOBER 1st. AND APRIL 30th IS NOT ACCEPTABLE, UNLESS FOR USE ON STOCKPILES WHERE THE STOCKPILE IS ALSO PROTECTED WITH FIBER ROLLS CONTAINING THE BASE OF THE STOCKPILE.
16. THE TREE PROTECTION SHALL BE IN PLACE BEFORE ANY GRADING, EXCAVATING OR GRUBBING IS STARTED.

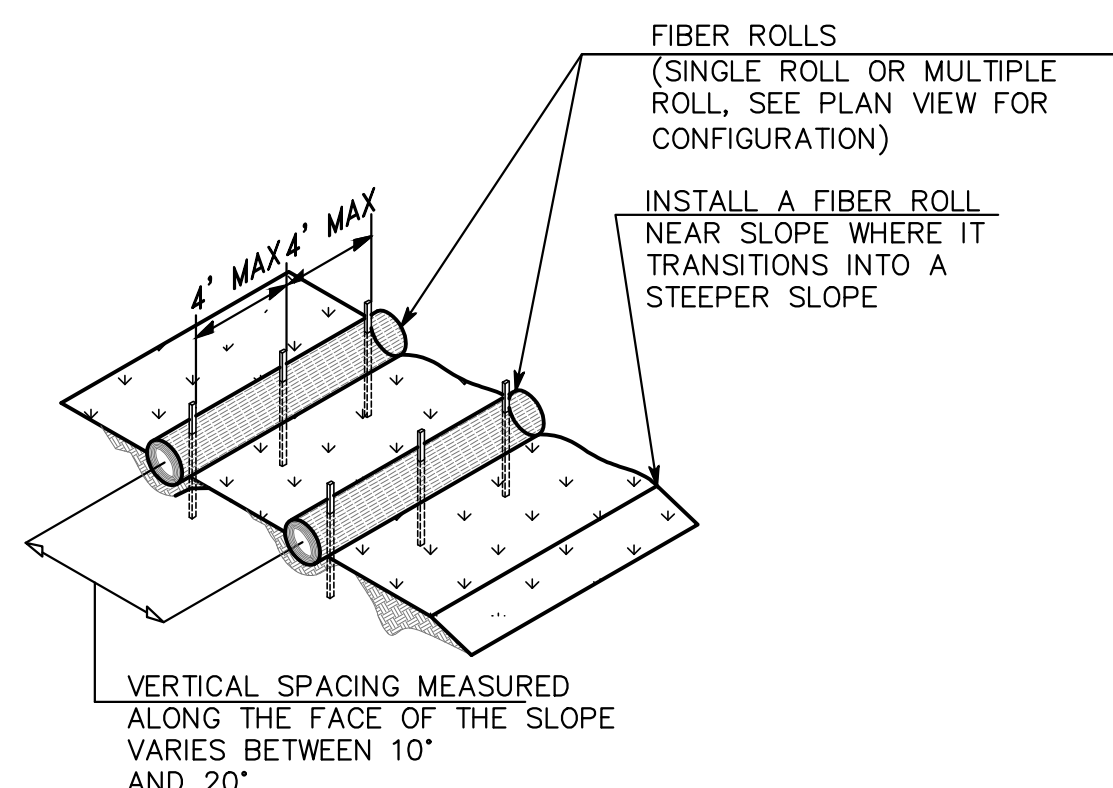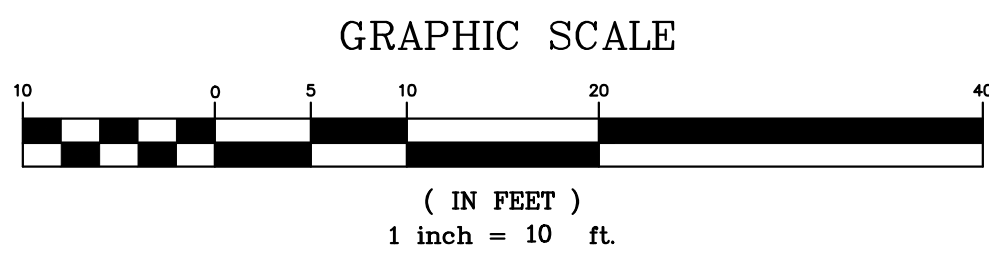

**TYPICAL FIBER ROLL INSTALLATION**  
N.T.S.


**A FIBER ROLL DETAIL**

SCALE: NOT TO SCALE

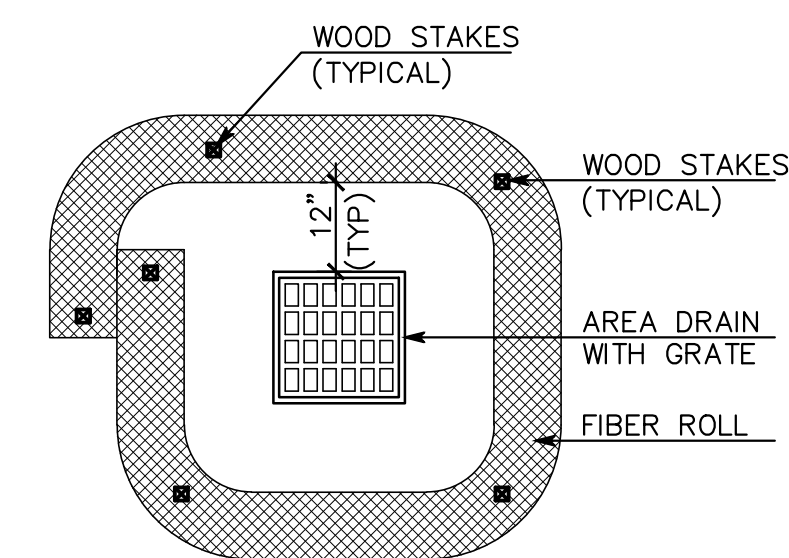

**B DRAIN INLET PROTECTION DETAIL**


SCALE: NOT TO SCALE

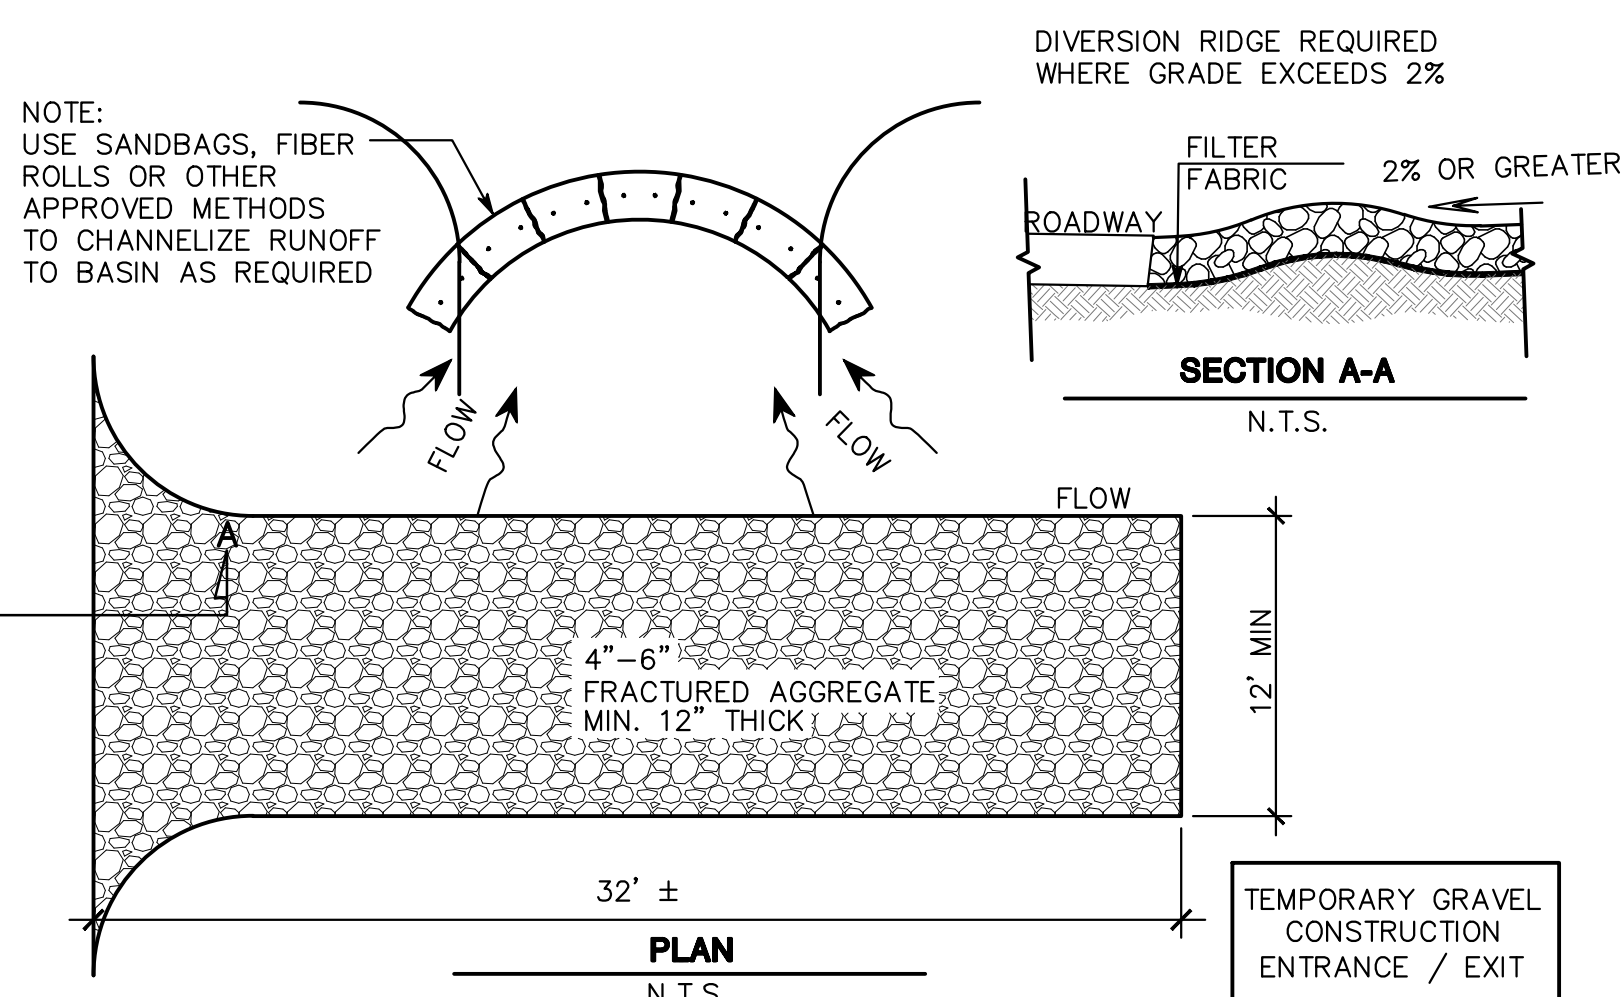


**C CONSTRUCTION ENTRANCE DETAIL**

SCALE: NOT TO SCALE

NOTE: INSTALL FIBER ROLL ALONG A LEVEL CONTOUR

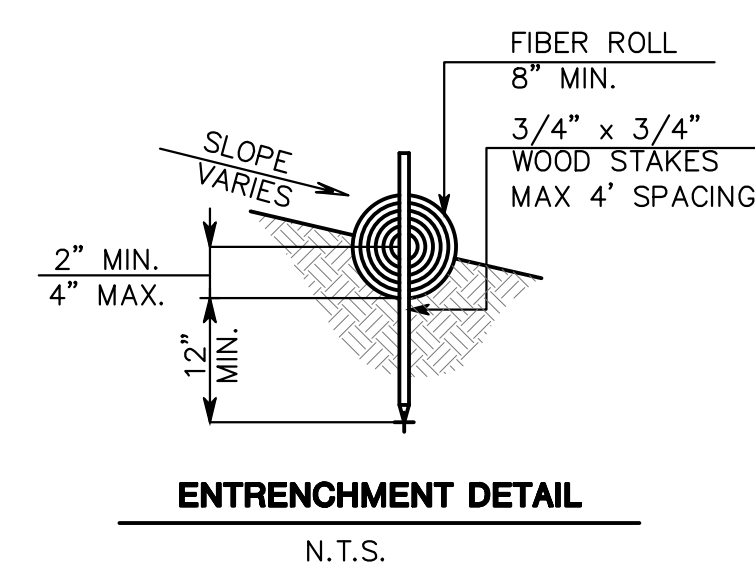


**ENTRENCHMENT DETAIL**  
N.T.S.

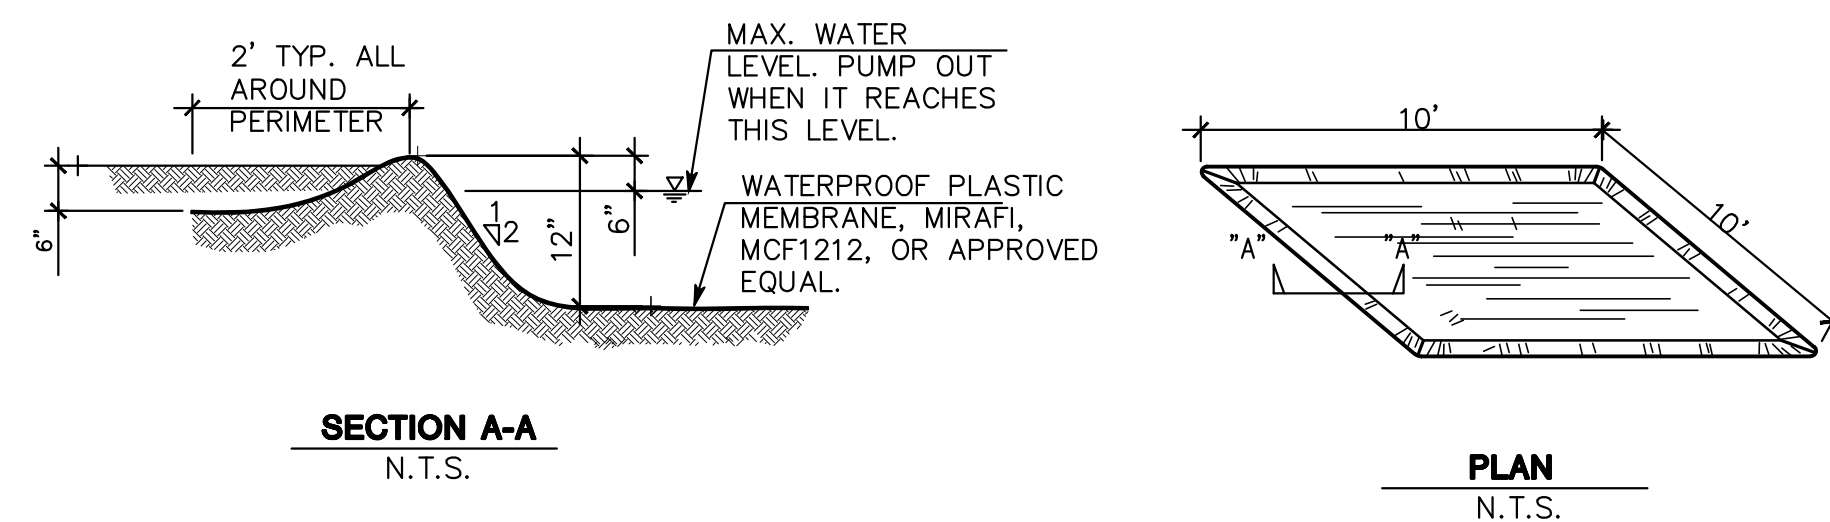


**D TEMPORARY CONCRETE WASHOUT DETAIL**

SCALE: (NOT TO SCALE)

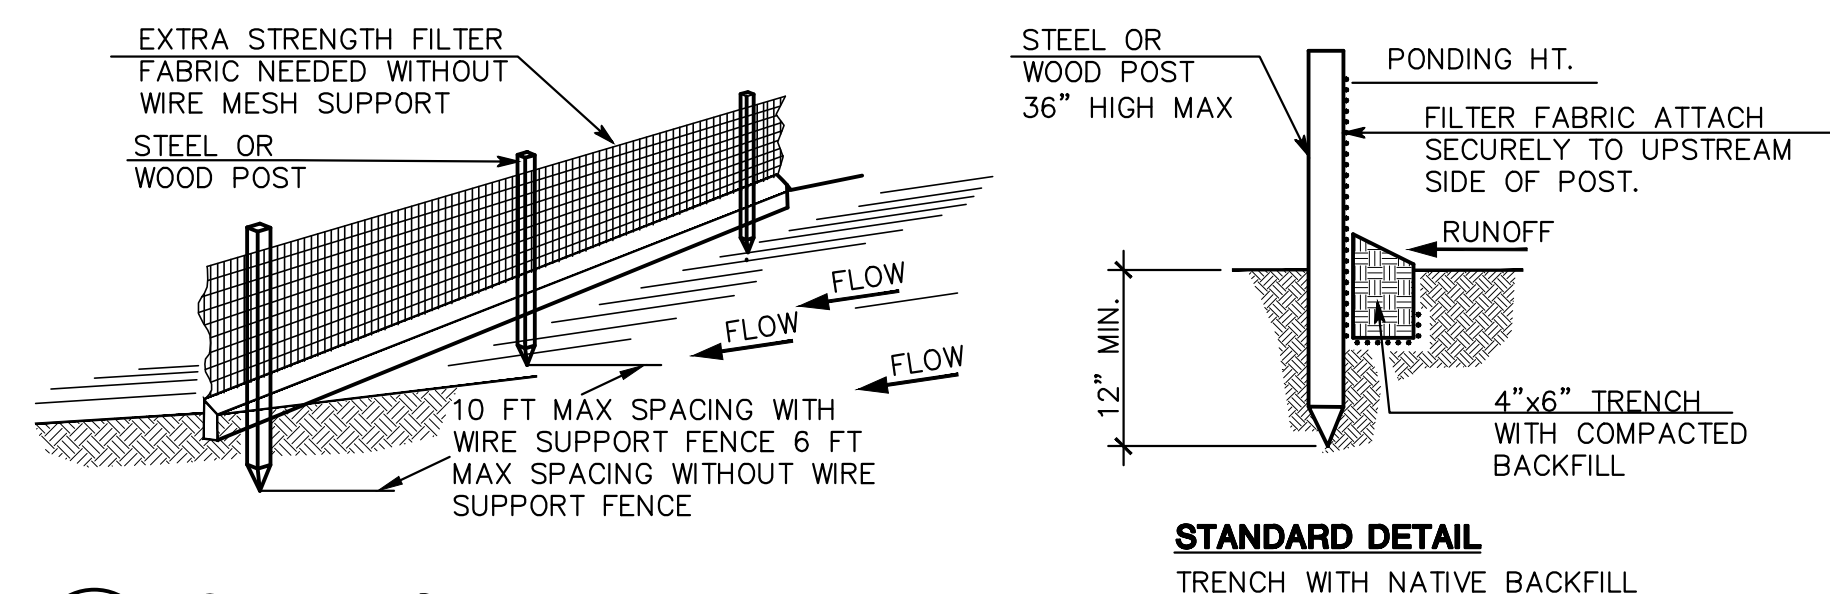

**E SILT FENCE DETAIL**

SCALE: (NOT TO SCALE)

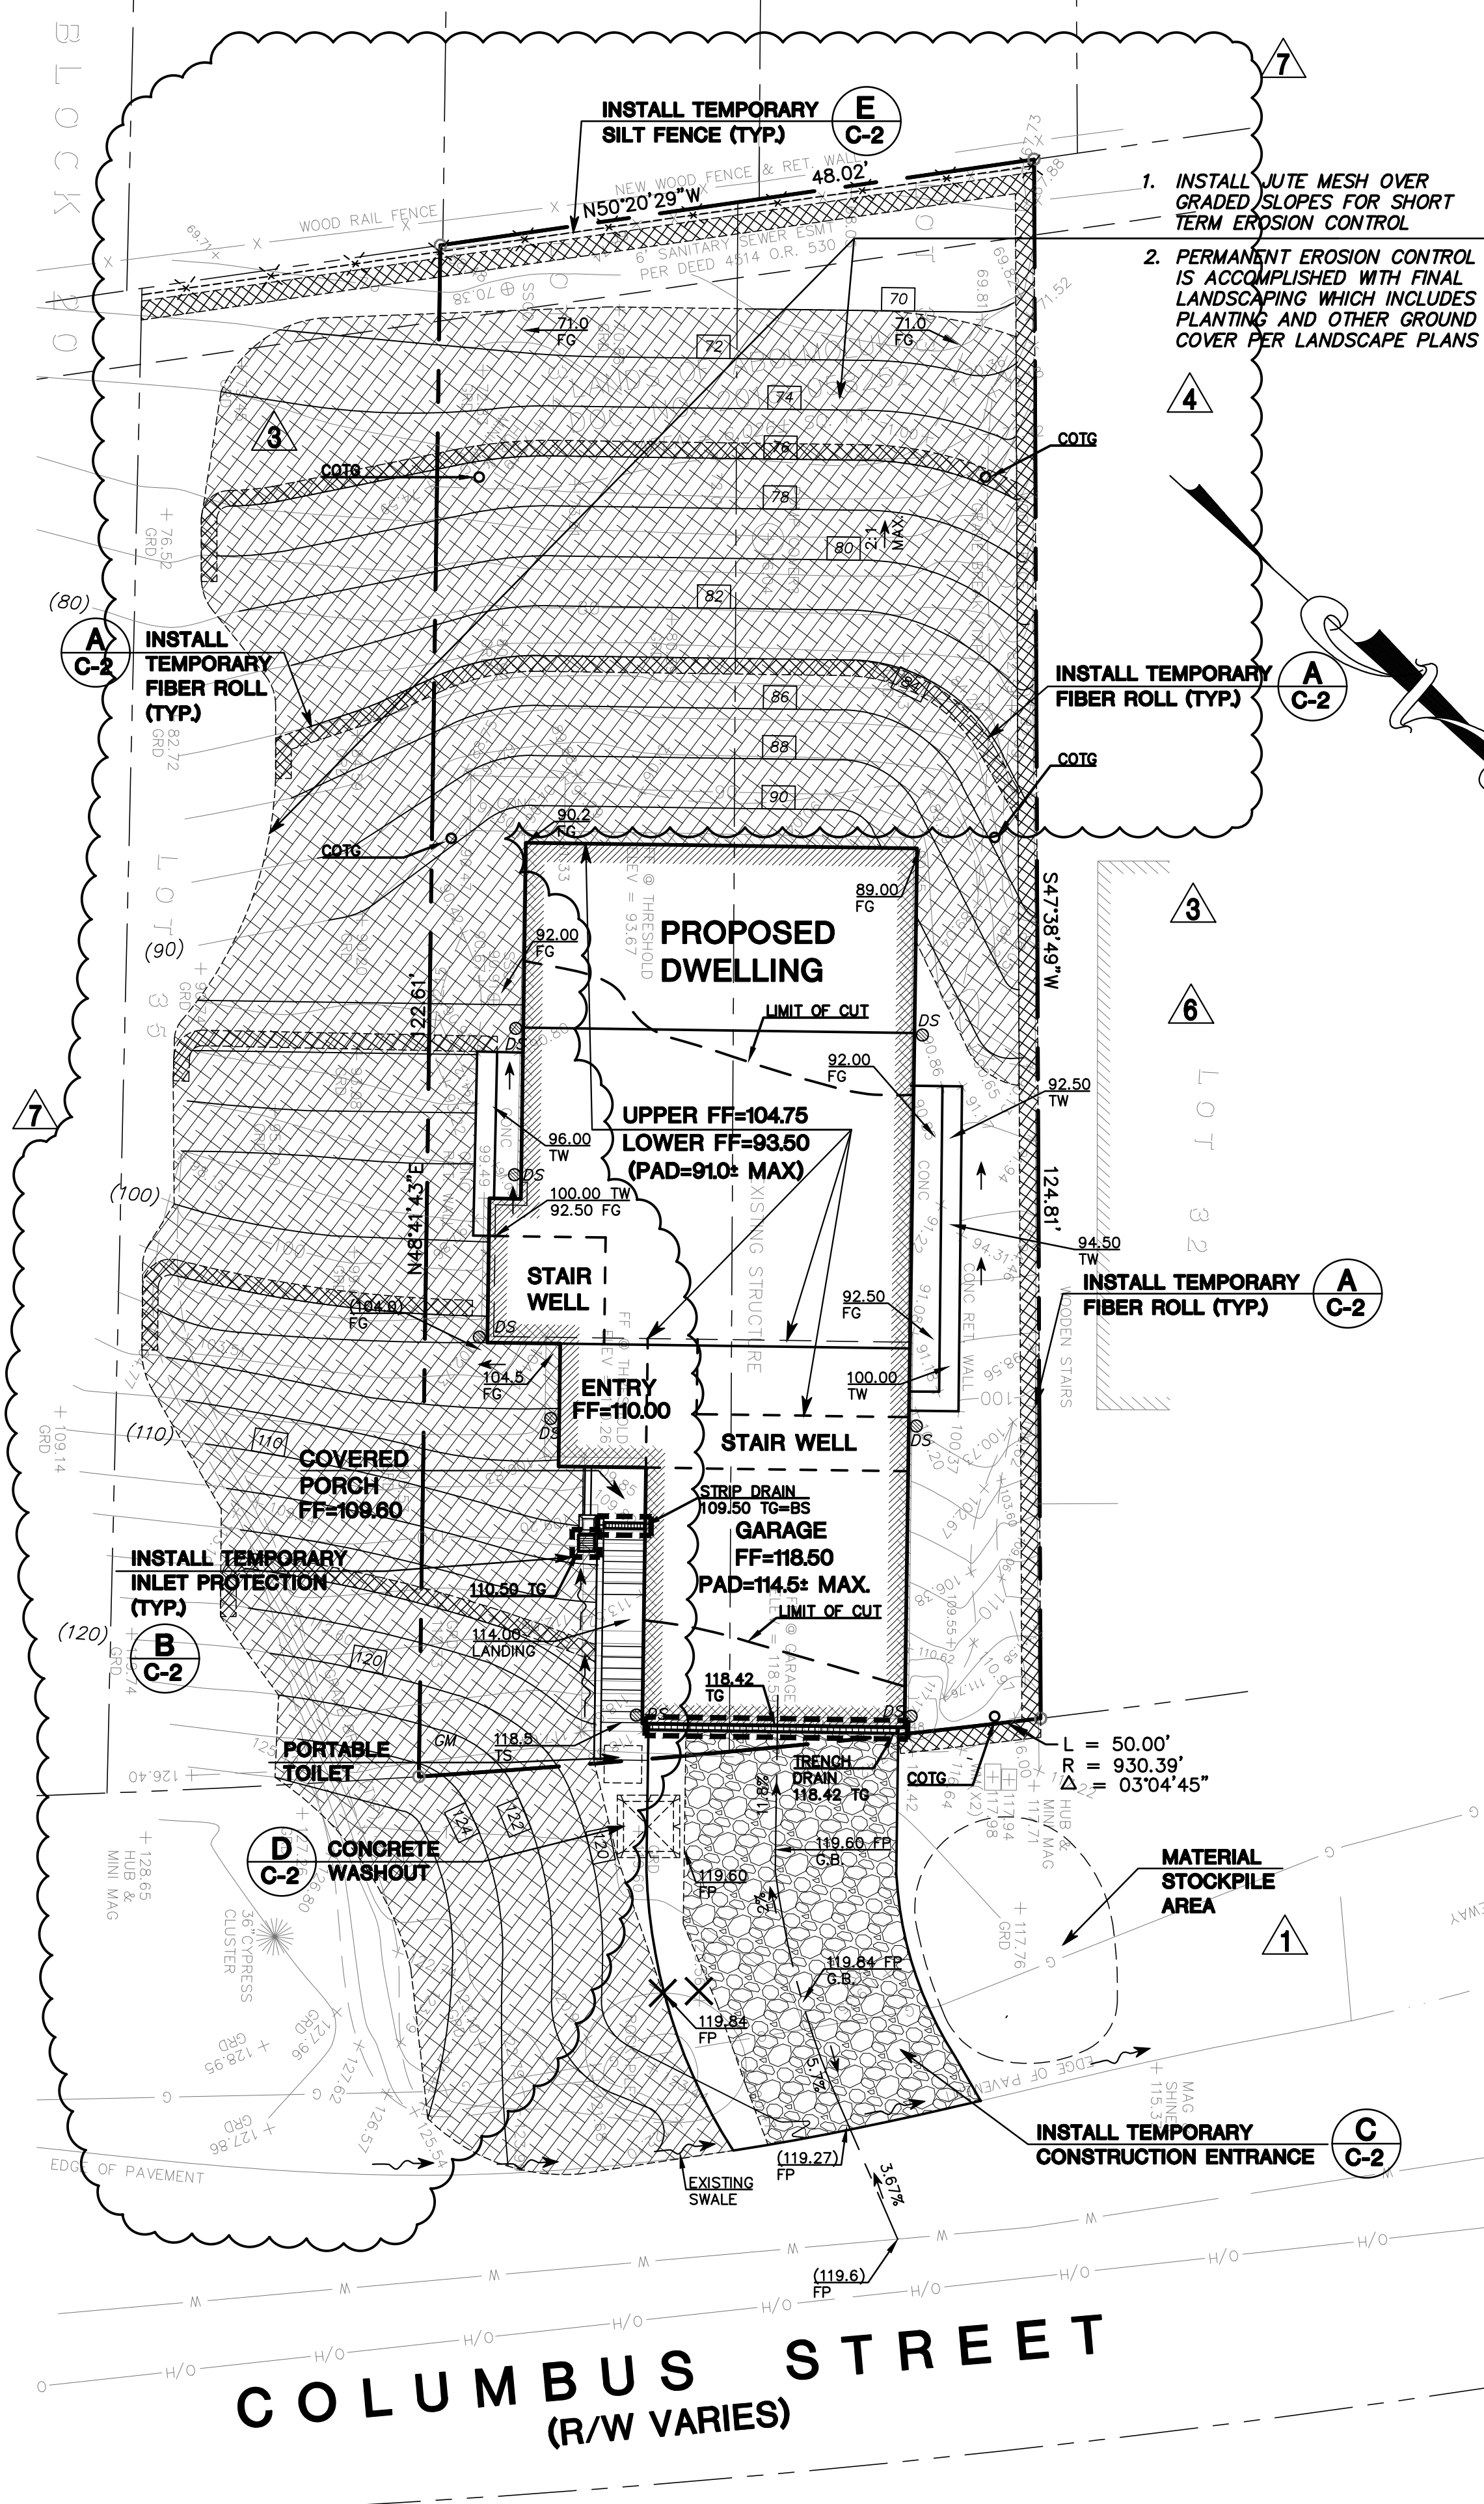


DATE: 08/24/18	BY: VPG
PROJECT: 4452-GRAD	DESCRIPTION: EROSION AND SEDIMENTATION CONTROL PLAN WITH DUST CONTROL NOTES
SCALE: 1"=10'	REVISIONS:
DRAWN BY: DJK/AAP	NO. 1: 07/25/18
DESIGNED BY: VPG	NO. 2: 08/14/19
CHECKED BY: DGM	NO. 3: 07/25/19
DATE: 08/24/18	NO. 4: 07/27/18
DRAWING NO. 4452-GRAD	NO. 5: 07/25/19
SHEET 2 OF 4	NO. 6: 07/25/19




**MACLEOD AND ASSOCIATES**  
CIVIL ENGINEERING • LAND SURVEYING  
965 CENTER STREET • SAN CARLOS, CA 94070 • (650) 593-8580

PREPARED FOR:  
BAHRAM ABOLMOLUKI


EROSION AND SEDIMENTATION CONTROL PLAN WITH DUST CONTROL NOTES  
COLUMBUS STREET  
A.P.N. 047-275-050  
UNINCORPORATED SAN MATEO COUNTY CALIFORNIA

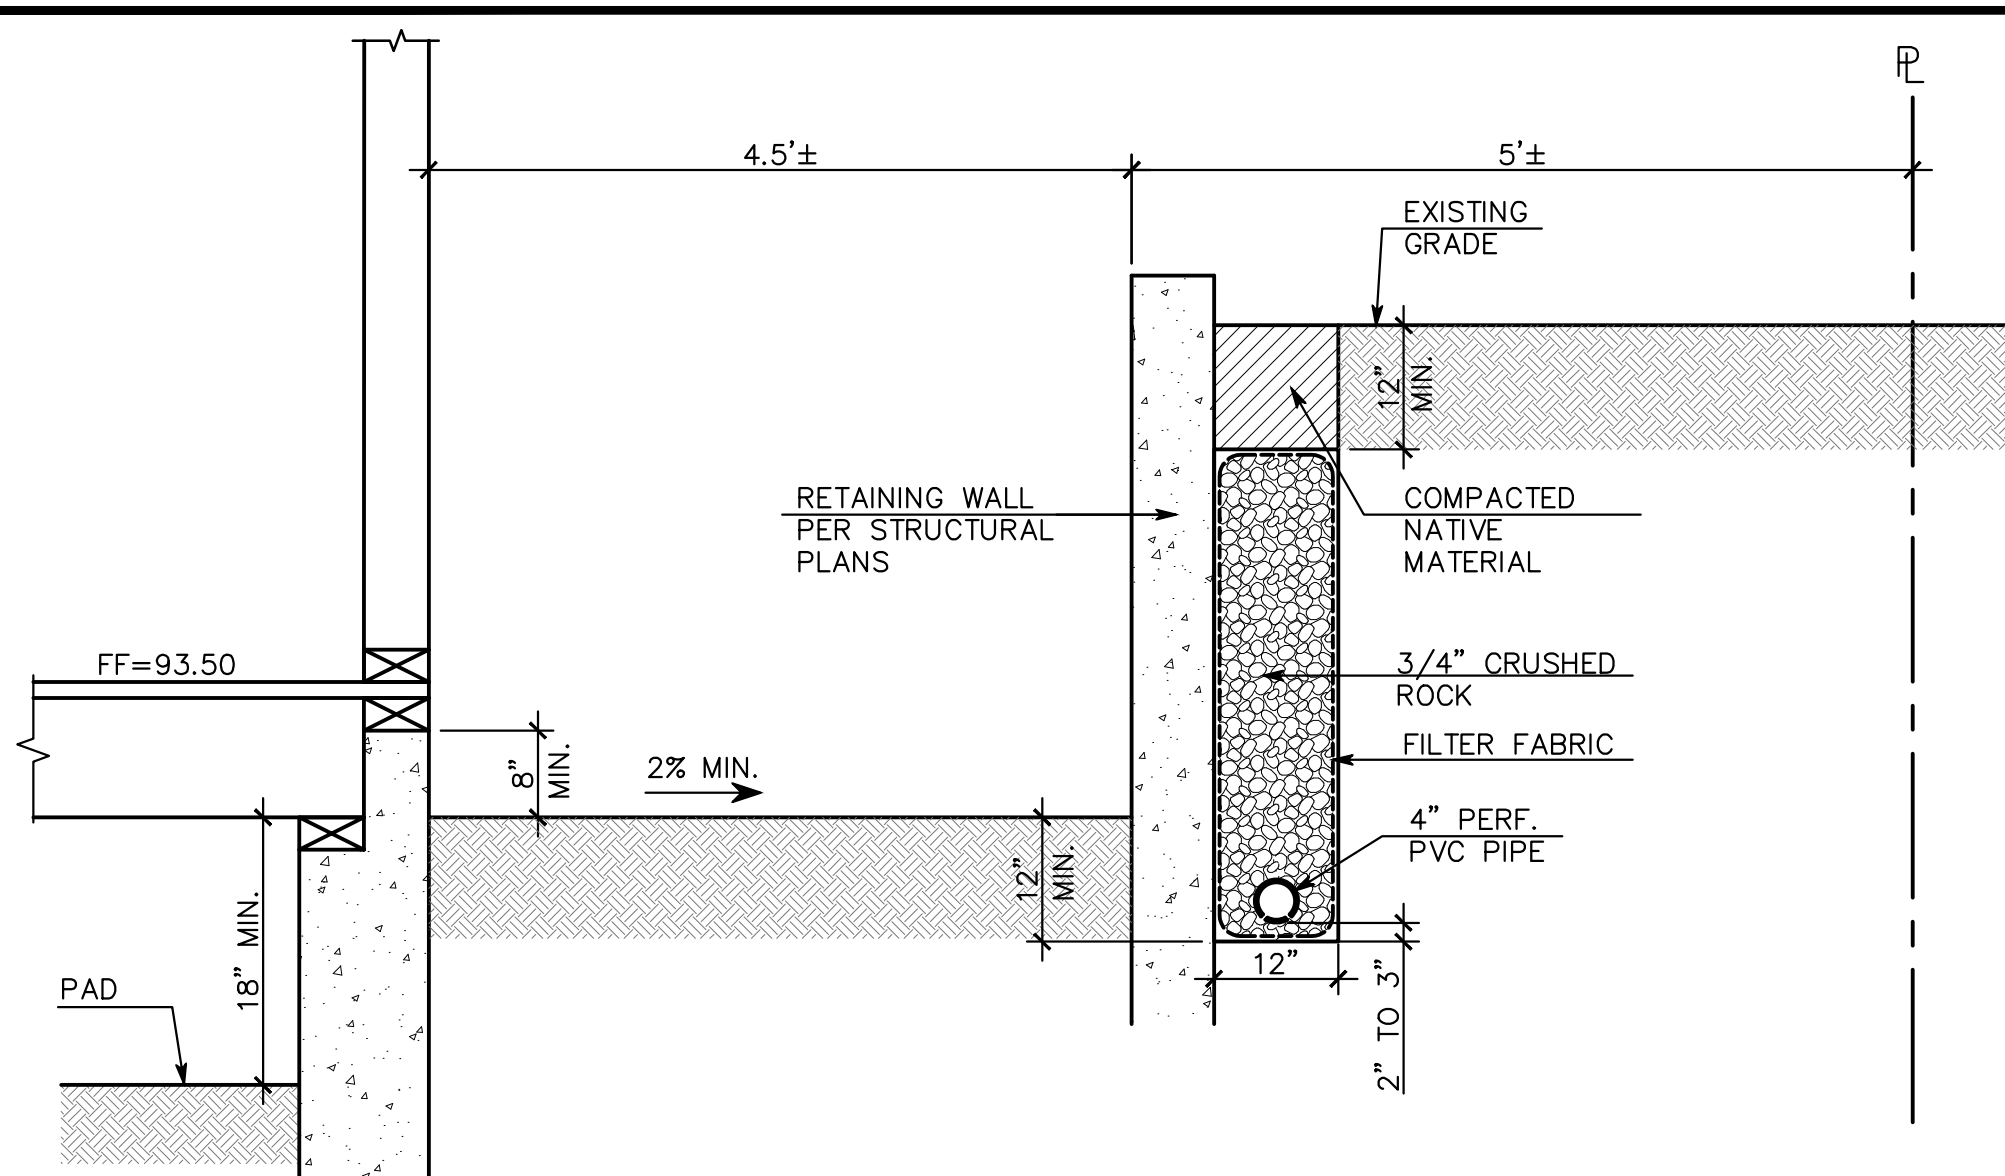


**A DRIVEWAY PAVEMENT SECTION**  
SCALE: (NOT TO SCALE)

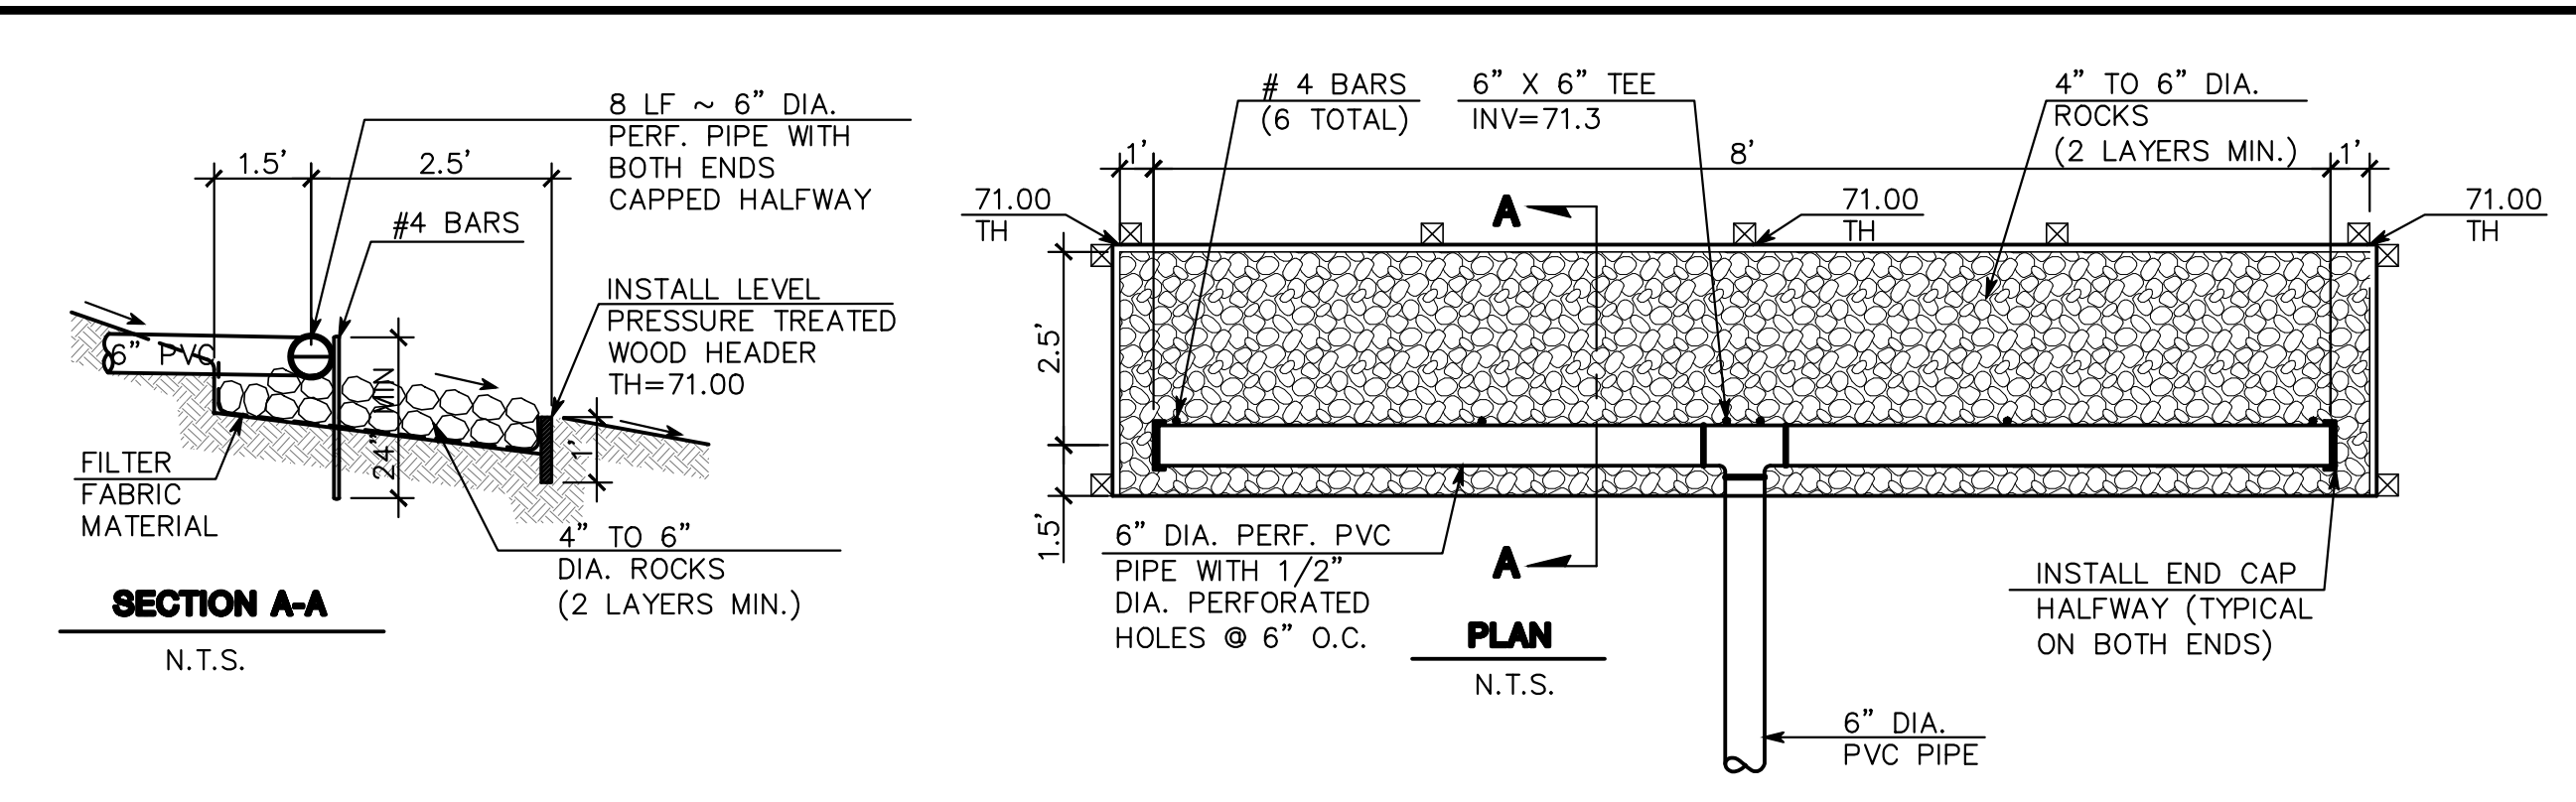


**E ENERGY DISSIPATER**  
SCALE: (NOT TO SCALE)

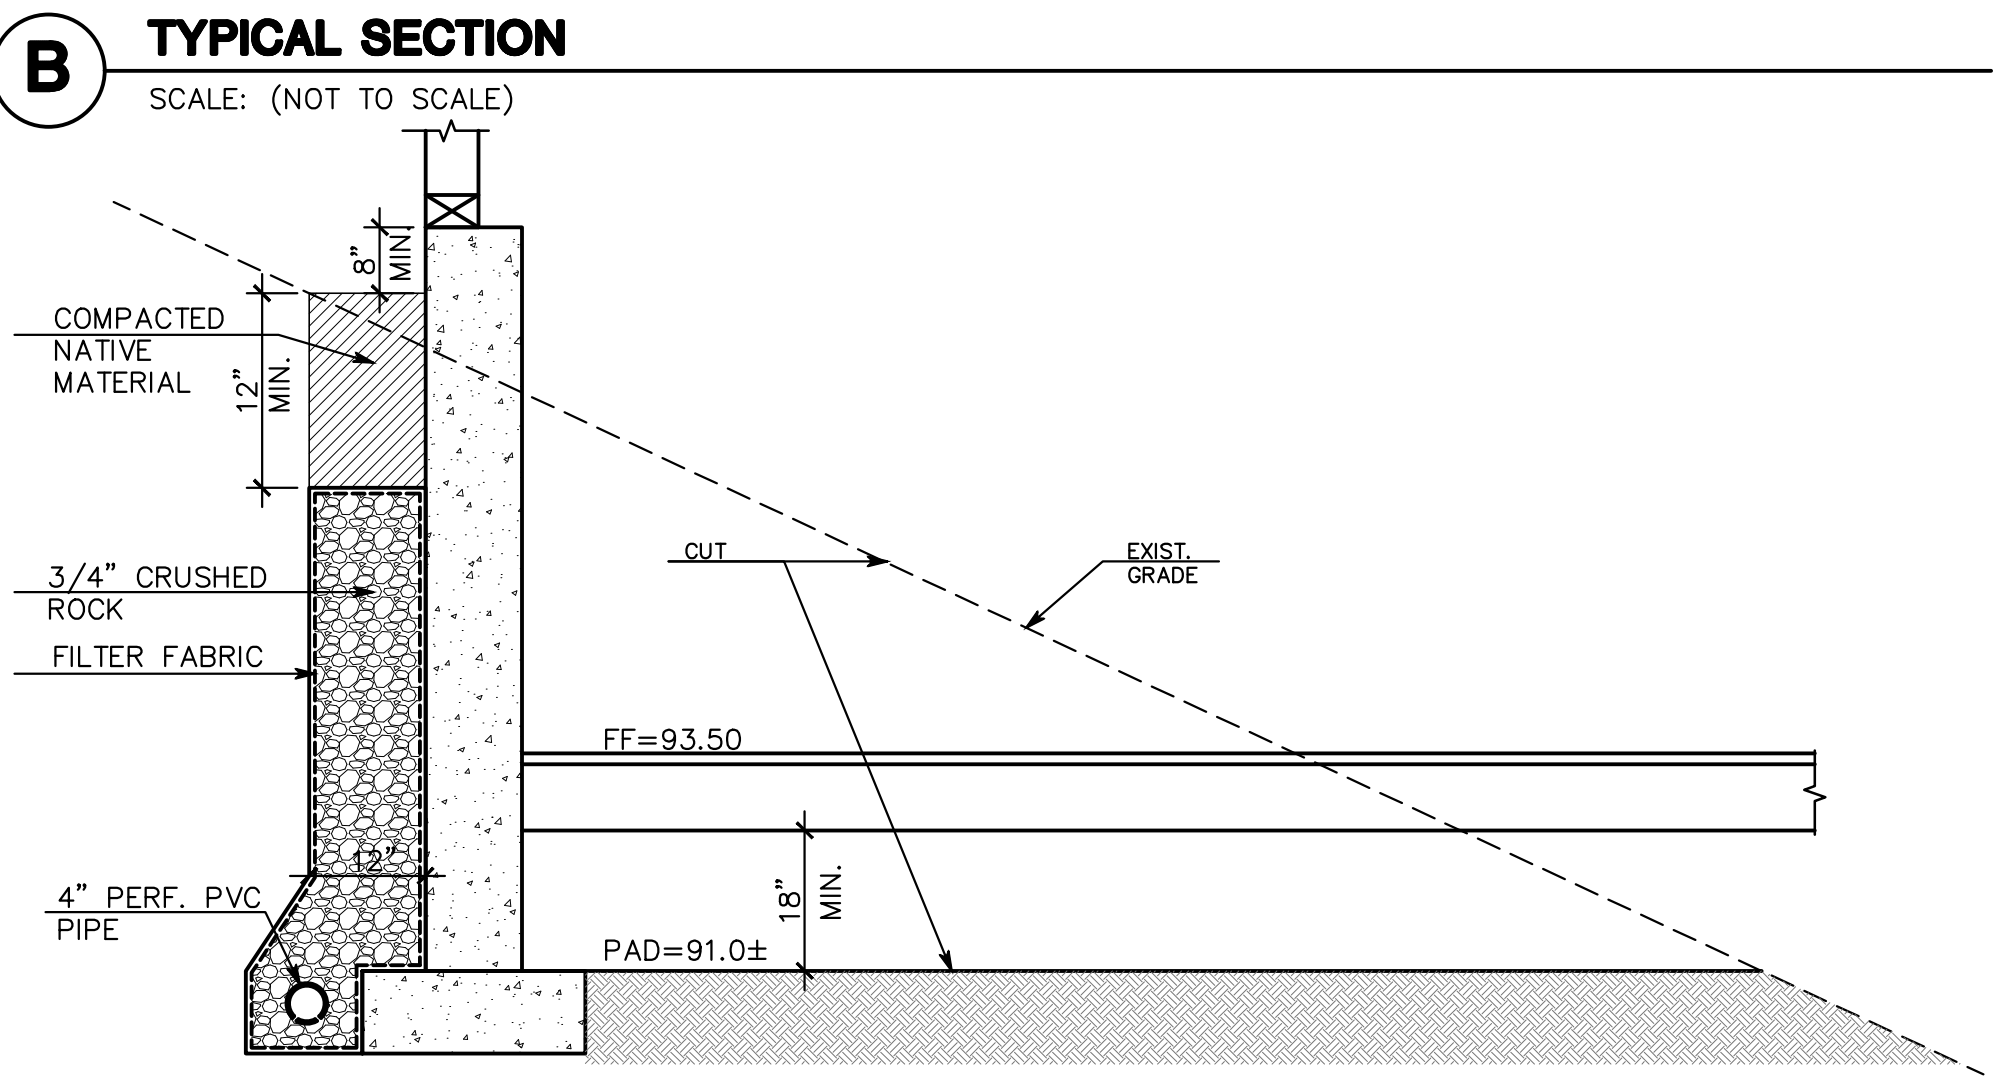

**B TYPICAL SECTION**  
SCALE: (NOT TO SCALE)

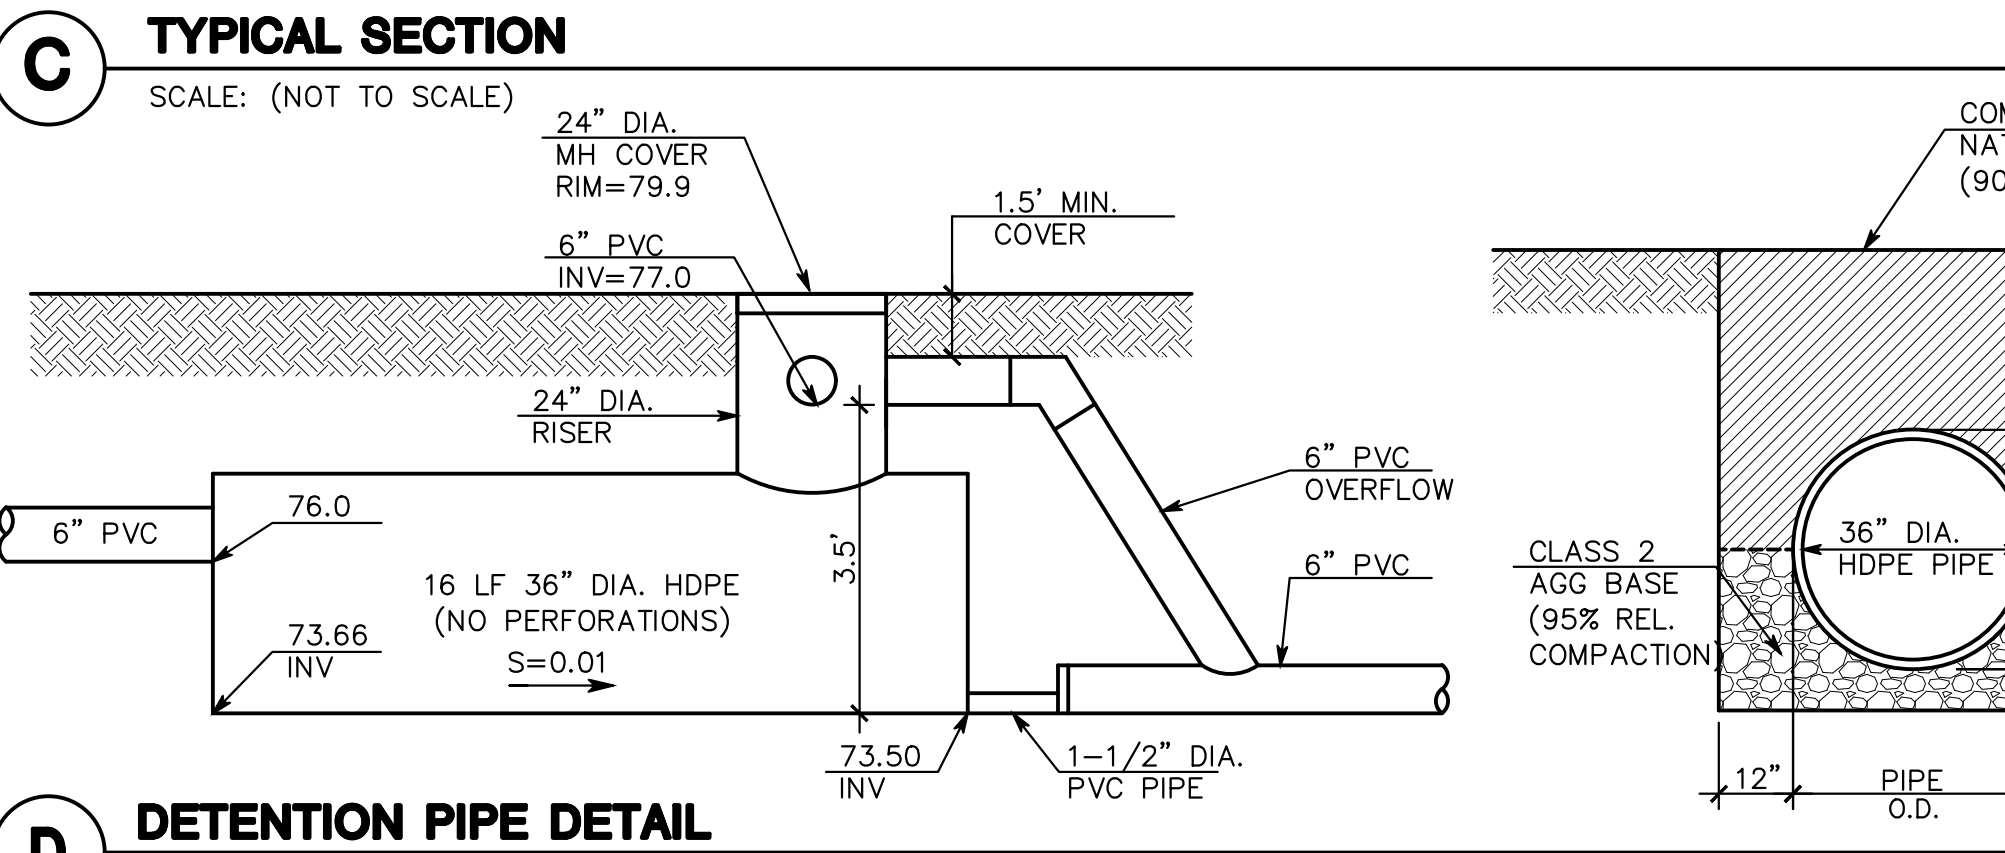


**C TYPICAL SECTION**  
SCALE: (NOT TO SCALE)

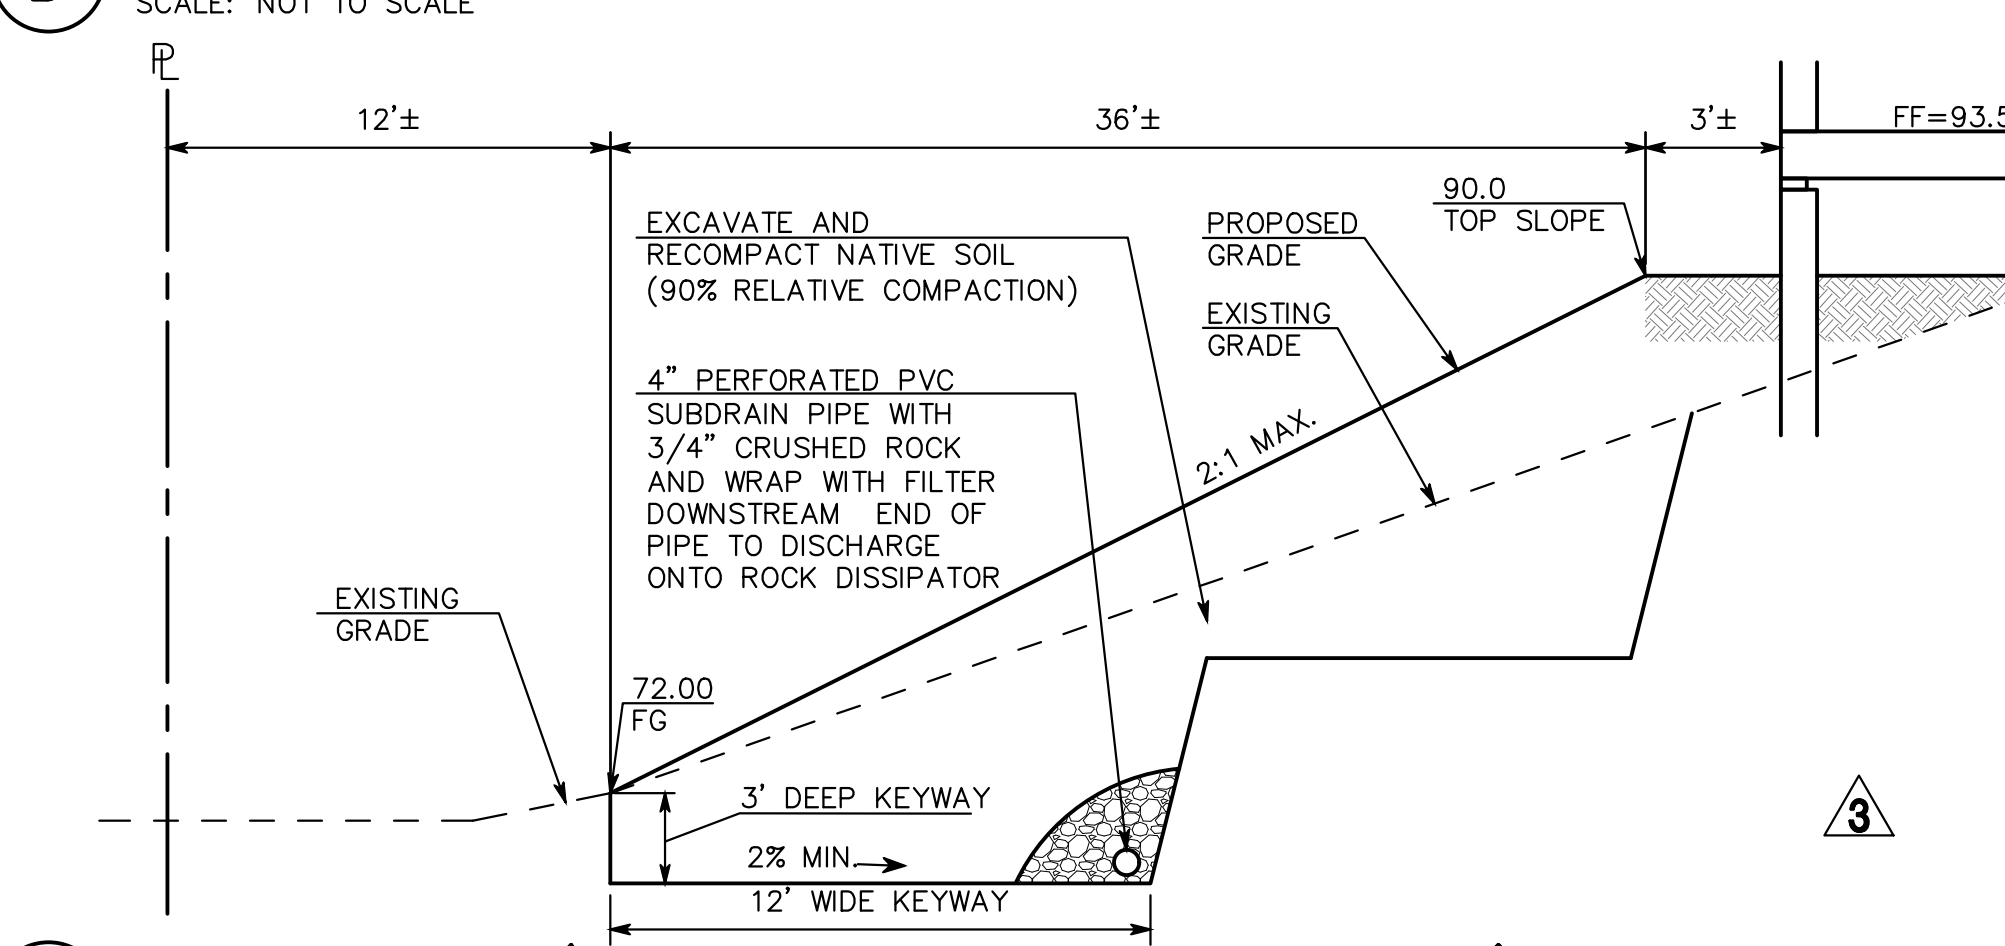


**D DETENTION PIPE DETAIL**  
SCALE: NOT TO SCALE




**I CROSS SECTION (PROPOSED FILL ON EXISTING SLOPE)**  
SCALE: (NOT TO SCALE)

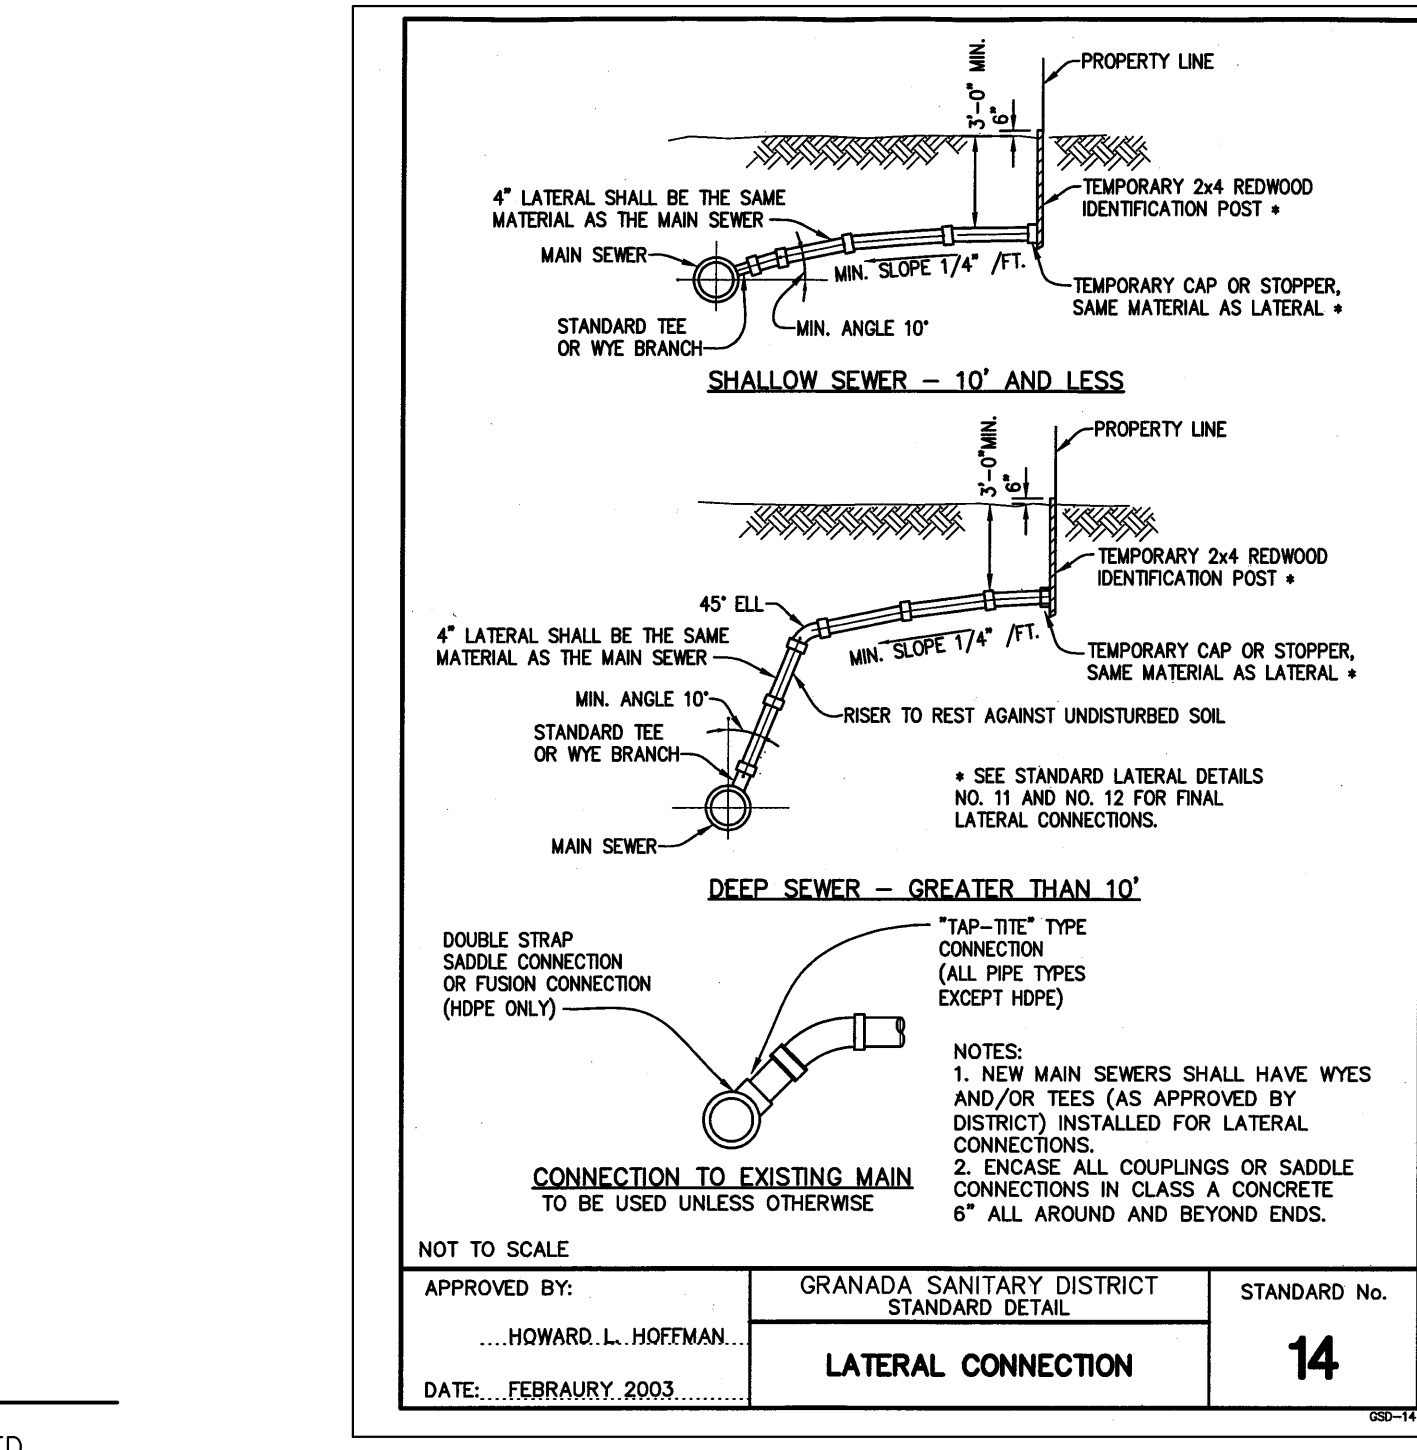


**F STANDARD DETAIL**  
SCALE: (NOT TO SCALE)

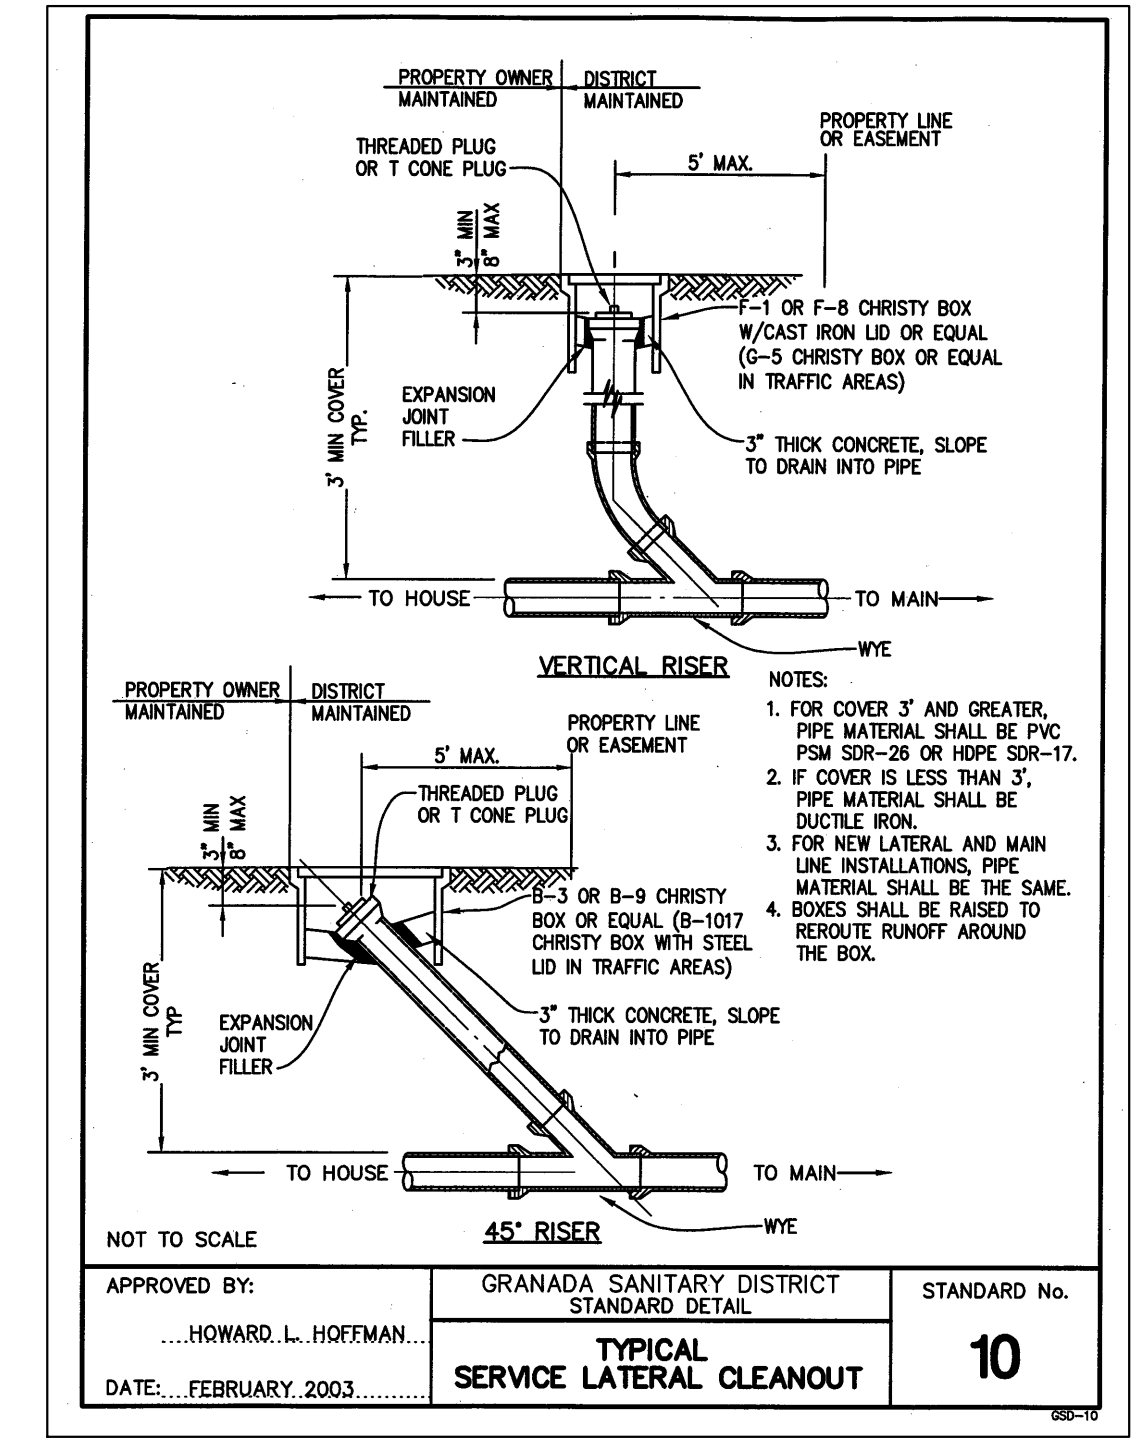

**G STANDARD DETAIL**  
SCALE: (NOT TO SCALE)

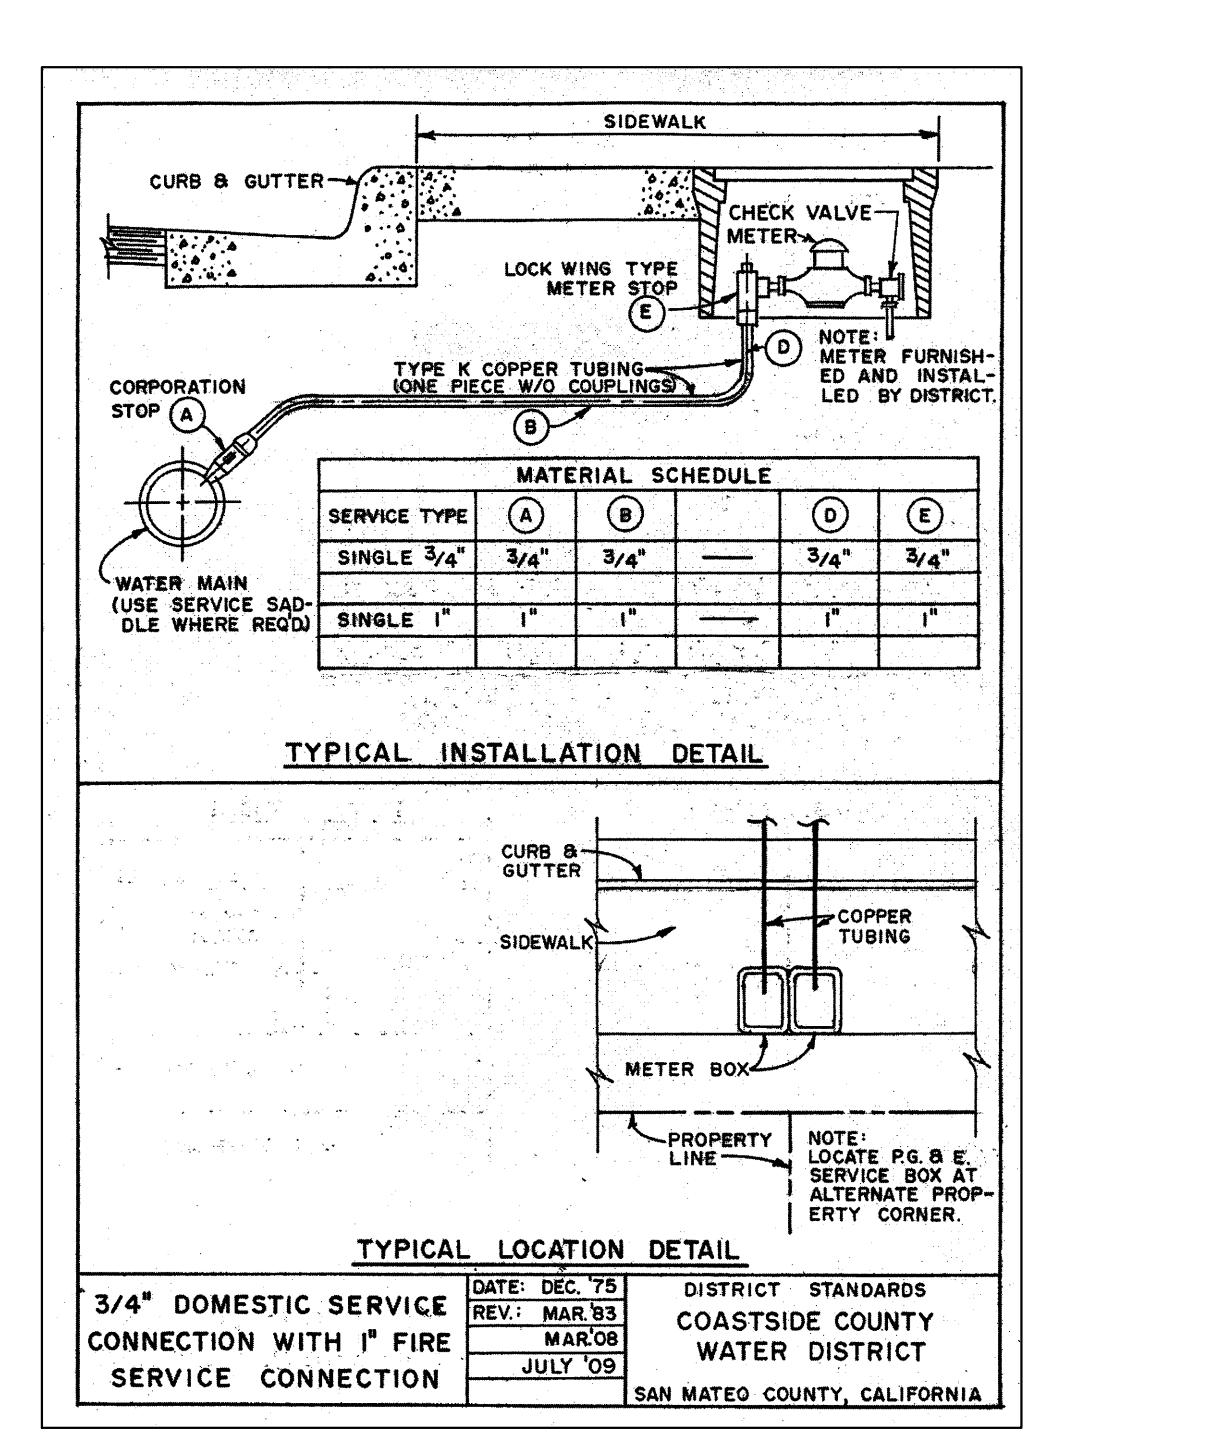

**H STANDARD DETAIL**  
SCALE: (NOT TO SCALE)

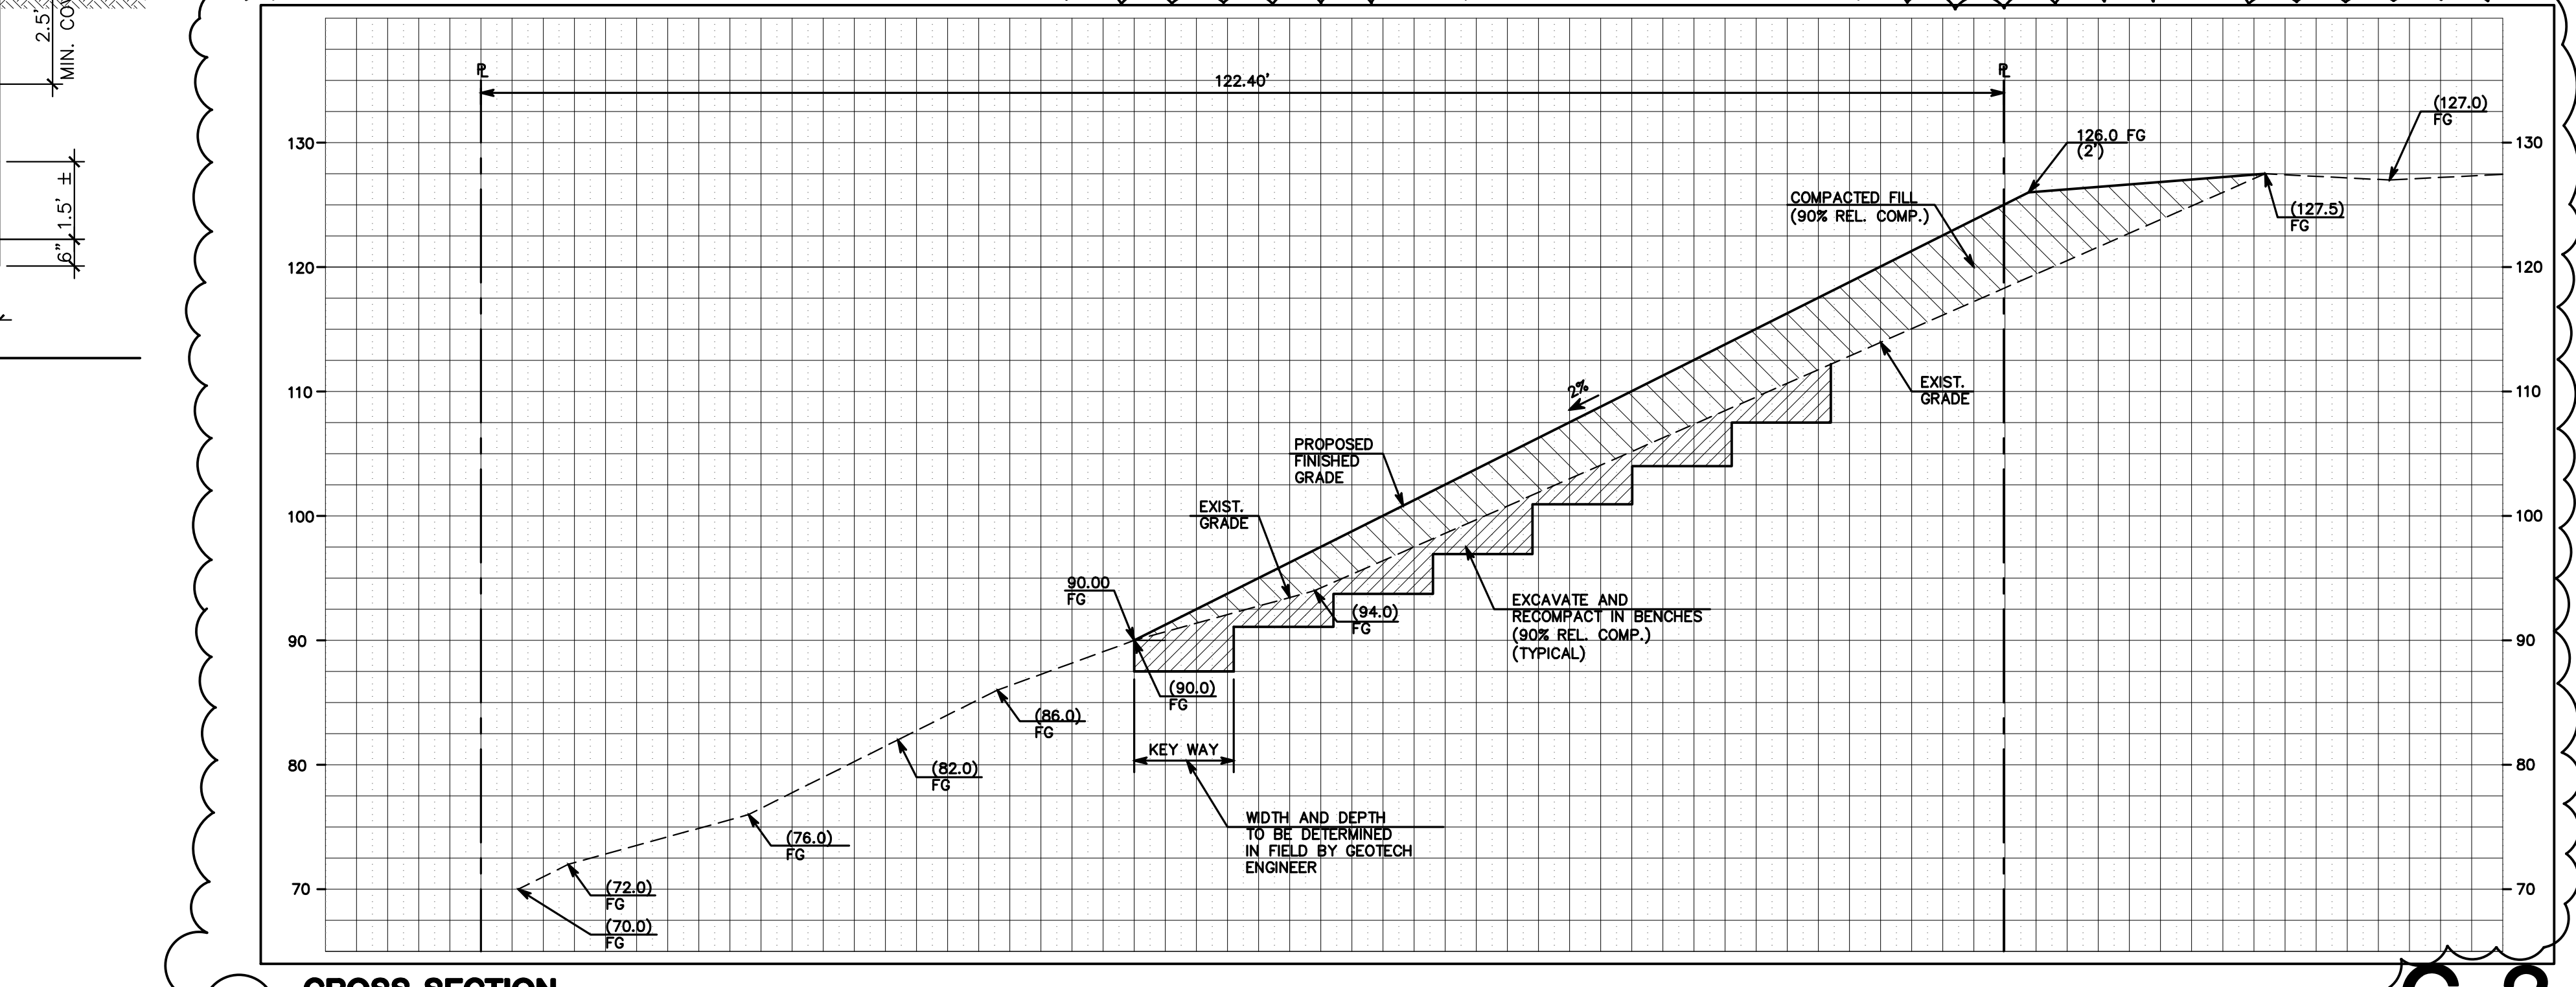

**J CROSS SECTION**  
SCALE: 1":10' (H & V)

DATE:	10/05/20
BY:	VPG
REV:	02/03/20
DESCRIPTION:	SITE REGRADING
REV:	09/14/19
DESCRIPTION:	PER COUNTY COMMENTS
REV:	07/25/19
DESCRIPTION:	GRADING REVISION


**MACLEOD AND ASSOCIATES**  
CIVIL ENGINEERING • LAND SURVEYING  
965 CENTER STREET • SAN CARLOS, CA 94070 • (650) 593-8560

PREPARED FOR:  
BAHRAM ABOLMOLUKI

CIVIL DETAILS  
COLUMBUS STREET  
A.P.N. 047-275-050  
UNINCORPORATED SAN MATEO COUNTY CALIFORNIA

DRAWN BY: DJK/AAP  
DESIGNED BY: VPG  
CHECKED BY: DGM  
SCALE: NONE  
DATE: 08/24/18  
DRAWING NO. 4452-DETAIL  
SHEET 3 OF 4



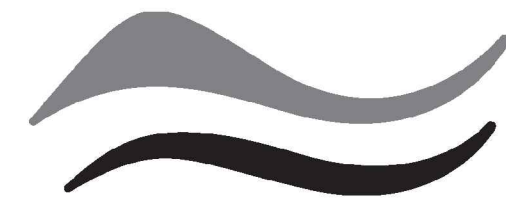


SAN MATEO COUNTYWIDE  
**Water Pollution  
 Prevention Program**  
 Clean Water. Healthy Community.

# Construction Best Management Practices (BMPs)

Construction projects are required to implement the stormwater best management practices (BMP) on this page, as they apply to your project, all year long.

## Materials & Waste Management

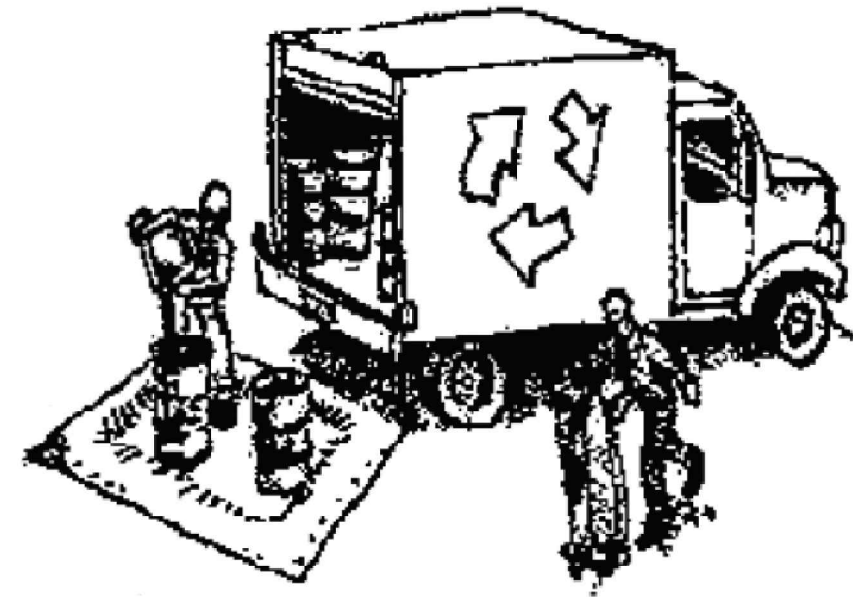

### Non-Hazardous Materials

- Berm and cover stockpiles of sand, dirt or other construction material with tarps when rain is forecast or if not actively being used within 14 days.
- Use (but don't overuse) reclaimed water for dust control.

### Hazardous Materials

- Label all hazardous materials and hazardous wastes (such as pesticides, paints, thinners, solvents, fuel, oil, and antifreeze) in accordance with city, county, state and federal regulations.
- Store hazardous materials and wastes in water tight containers, store in appropriate secondary containment, and cover them at the end of every work day or during wet weather or when rain is forecast.
- Follow manufacturer's application instructions for hazardous materials and be careful not to use more than necessary. Do not apply chemicals outdoors when rain is forecast within 24 hours.
- Arrange for appropriate disposal of all hazardous wastes.

### Waste Management

- Cover waste disposal containers securely with tarps at the end of every work day and during wet weather.
- Check waste disposal containers frequently for leaks and to make sure they are not overfilled. Never hose down a dumpster on the construction site.
- Clean or replace portable toilets, and inspect them frequently for leaks and spills.
- Dispose of all wastes and debris properly. Recycle materials and wastes that can be recycled (such as asphalt, concrete, aggregate base materials, wood, gyp board, pipe, etc.)
- Dispose of liquid residues from paints, thinners, solvents, glues, and cleaning fluids as hazardous waste.

### Construction Entrances and Perimeter

- Establish and maintain effective perimeter controls and stabilize all construction entrances and exits to sufficiently control erosion and sediment discharges from site and tracking off site.
- Sweep or vacuum any street tracking immediately and secure sediment source to prevent further tracking. Never hose down streets to clean up tracking.

## Equipment Management & Spill Control



### Maintenance and Parking

- Designate an area, fitted with appropriate BMPs, for vehicle and equipment parking and storage.
- Perform major maintenance, repair jobs, and vehicle and equipment washing off site.
- If refueling or vehicle maintenance must be done onsite, work in a bermed area away from storm drains and over a drip pan or drop cloths big enough to collect fluids. Recycle or dispose of fluids as hazardous waste.
- If vehicle or equipment cleaning must be done onsite, clean with water only in a bermed area that will not allow rinse water to run into gutters, streets, storm drains, or surface waters.
- Do not clean vehicle or equipment onsite using soaps, solvents, degreasers, or steam cleaning equipment.

### Spill Prevention and Control

- Keep spill cleanup materials (e.g., rags, absorbents and cat litter) available at the construction site at all times.
- Inspect vehicles and equipment frequently for and repair leaks promptly. Use drip pans to catch leaks until repairs are made.
- Clean up spills or leaks immediately and dispose of cleanup materials properly.
- Do not hose down surfaces where fluids have spilled. Use dry cleanup methods (absorbent materials, cat litter, and/or rags).
- Sweep up spilled dry materials immediately. Do not try to wash them away with water, or bury them.
- Clean up spills on dirt areas by digging up and properly disposing of contaminated soil.
- Report significant spills immediately. You are required by law to report all significant releases of hazardous materials, including oil. To report a spill: 1) Dial 911 or your local emergency response number, 2) Call the Governor's Office of Emergency Services Warning Center, (800) 852-7550 (24 hours).

## Earthmoving



- Schedule grading and excavation work during dry weather.
- Stabilize all denuded areas, install and maintain temporary erosion controls (such as erosion control fabric or bonded fiber matrix) until vegetation is established.
- Remove existing vegetation only when absolutely necessary, and seed or plant vegetation for erosion control on slopes or where construction is not immediately planned.
- Prevent sediment from migrating offsite and protect storm drain inlets, gutters, ditches, and drainage courses by installing and maintaining appropriate BMPs, such as fiber rolls, silt fences, sediment basins, gravel bags, berms, etc.
- Keep excavated soil on site and transfer it to dump trucks on site, not in the streets.

### Contaminated Soils

- If any of the following conditions are observed, test for contamination and contact the Regional Water Quality Control Board:
  - Unusual soil conditions, discoloration, or odor.
  - Abandoned underground tanks.
  - Abandoned wells
  - Buried barrels, debris, or trash.

## Paving/Asphalt Work




- Avoid paving and seal coating in wet weather or when rain is forecast, to prevent materials that have not cured from contacting stormwater runoff.
- Cover storm drain inlets and manholes when applying seal coat, tack coat, slurry seal, fog seal, etc.
- Collect and recycle or appropriately dispose of excess abrasive gravel or sand. Do NOT sweep or wash it into gutters.
- Do not use water to wash down fresh asphalt concrete pavement.

### Sawcutting & Asphalt/Concrete Removal


- Protect nearby storm drain inlets when saw cutting. Use filter fabric, catch basin inlet filters, or gravel bags to keep slurry out of the storm drain system.
- Shovel, absorb, or vacuum saw-cut slurry and dispose of all waste as soon as you are finished in one location or at the end of each work day (whichever is sooner!).
- If sawcut slurry enters a catch basin, clean it up immediately.

## Concrete, Grout & Mortar Application

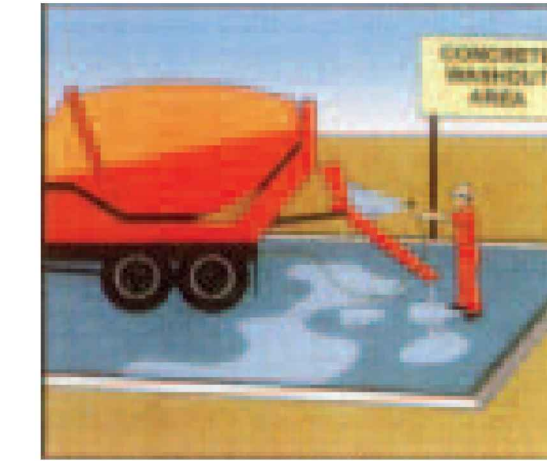


- Store concrete, grout, and mortar away from storm drains or waterways, and on pallets under cover to protect them from rain, runoff, and wind.
- Wash out concrete equipment/trucks offsite or in a designated washout area, where the water will flow into a temporary waste pit, and in a manner that will prevent leaching into the underlying soil or onto surrounding areas. Let concrete harden and dispose of as garbage.
- When washing exposed aggregate, prevent washwater from entering storm drains. Block any inlets and vacuum gutters, hose washwater onto dirt areas, or drain onto a bermed surface to be pumped and disposed of properly.

## Landscaping

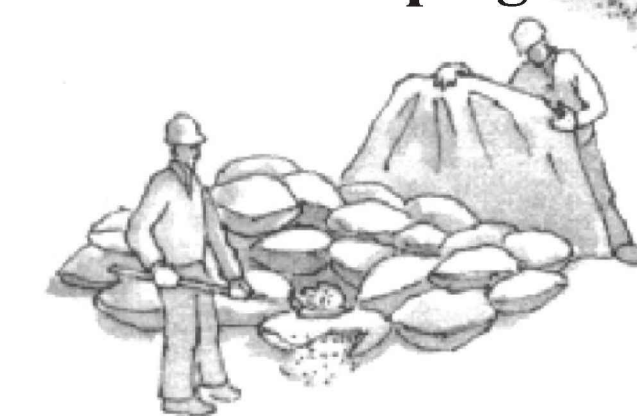

- Protect stockpiled landscaping materials from wind and rain by storing them under tarps all year-round.
- Stack bagged material on pallets and under cover.
- Discontinue application of any erodible landscape material within 2 days before a forecast rain event or during wet weather.


## Painting & Paint Removal

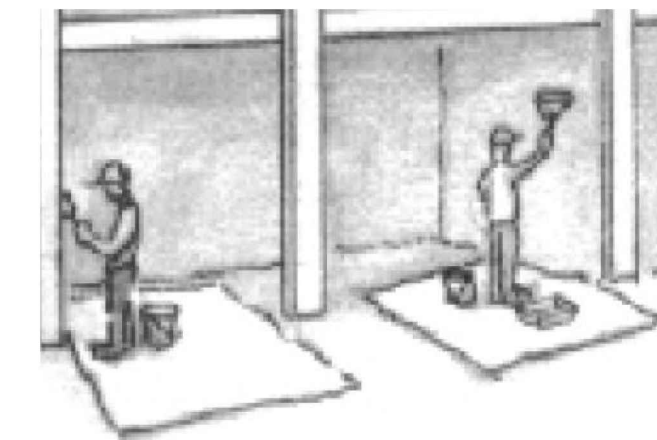

### Painting Cleanup and Removal

- Never clean brushes or rinse paint containers into a street, gutter, storm drain, or stream.
- For water-based paints, paint out brushes to the extent possible, and rinse into a drain that goes to the sanitary sewer. Never pour paint down a storm drain.
- For oil-based paints, paint out brushes to the extent possible and clean with thinner or solvent in a proper container. Filter and reuse thinners and solvents. Dispose of excess liquids as hazardous waste.
- Paint chips and dust from non-hazardous dry stripping and sand blasting may be swept up or collected in plastic drop cloths and disposed of as trash.
- Chemical paint stripping residue and chips and dust from marine paints or paints containing lead, mercury, or tributyltin must be disposed of as hazardous waste. Lead based paint removal requires a state-certified contractor.


## Dewatering

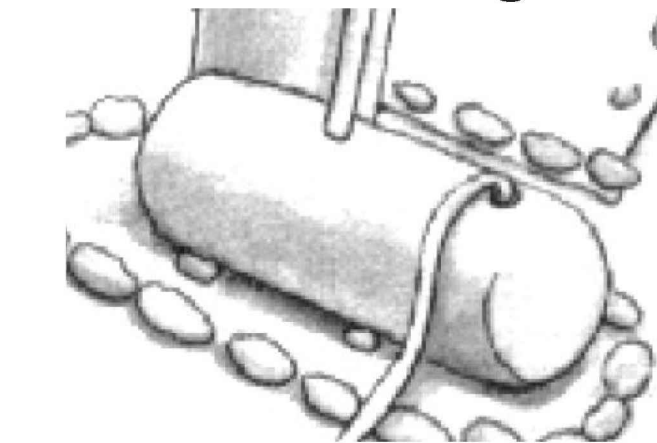

- Discharges of groundwater or captured runoff from dewatering operations must be properly managed and disposed. When possible send dewatering discharge to landscaped area or sanitary sewer. If discharging to the sanitary sewer call your local wastewater treatment plant.
- Divert run-on water from offsite away from all disturbed areas.
- When dewatering, notify and obtain approval from the local municipality before discharging water to a street gutter or storm drain. Filtration or diversion through a basin, tank, or sediment trap may be required.
- In areas of known or suspected contamination, call your local agency to determine whether the ground water must be tested. Pumped groundwater may need to be collected and hauled off-site for treatment and proper disposal.

**Storm drain polluters may be liable for fines of up to \$10,000 per day!**

DATE:	
BY:	
DESCRIPTION:	
REV:	
<b>MACLEOD AND ASSOCIATES</b> CIVIL ENGINEERING • LAND SURVEYING 965 CENTER STREET • SAN CARLOS, CA 94070 • (650) 593-8560	
PREPARED FOR:	BAHRAM ABOLMOLUKI
<b>CONSTRUCTION BEST MANAGEMENT PRACTICES PLAN</b>	COLUMBUS STREET A.P.N. 047-275-050
	UNINCORPORATED SAN MATEO COUNTY CALIFORNIA
DRAWN BY:	AAP
DESIGNED BY:	VPG
CHECKED BY:	DGM
SCALE:	NONE
DATE:	08/24/18
DRAWING NO.	4452-CBMPP
SHEET	4 OF 4

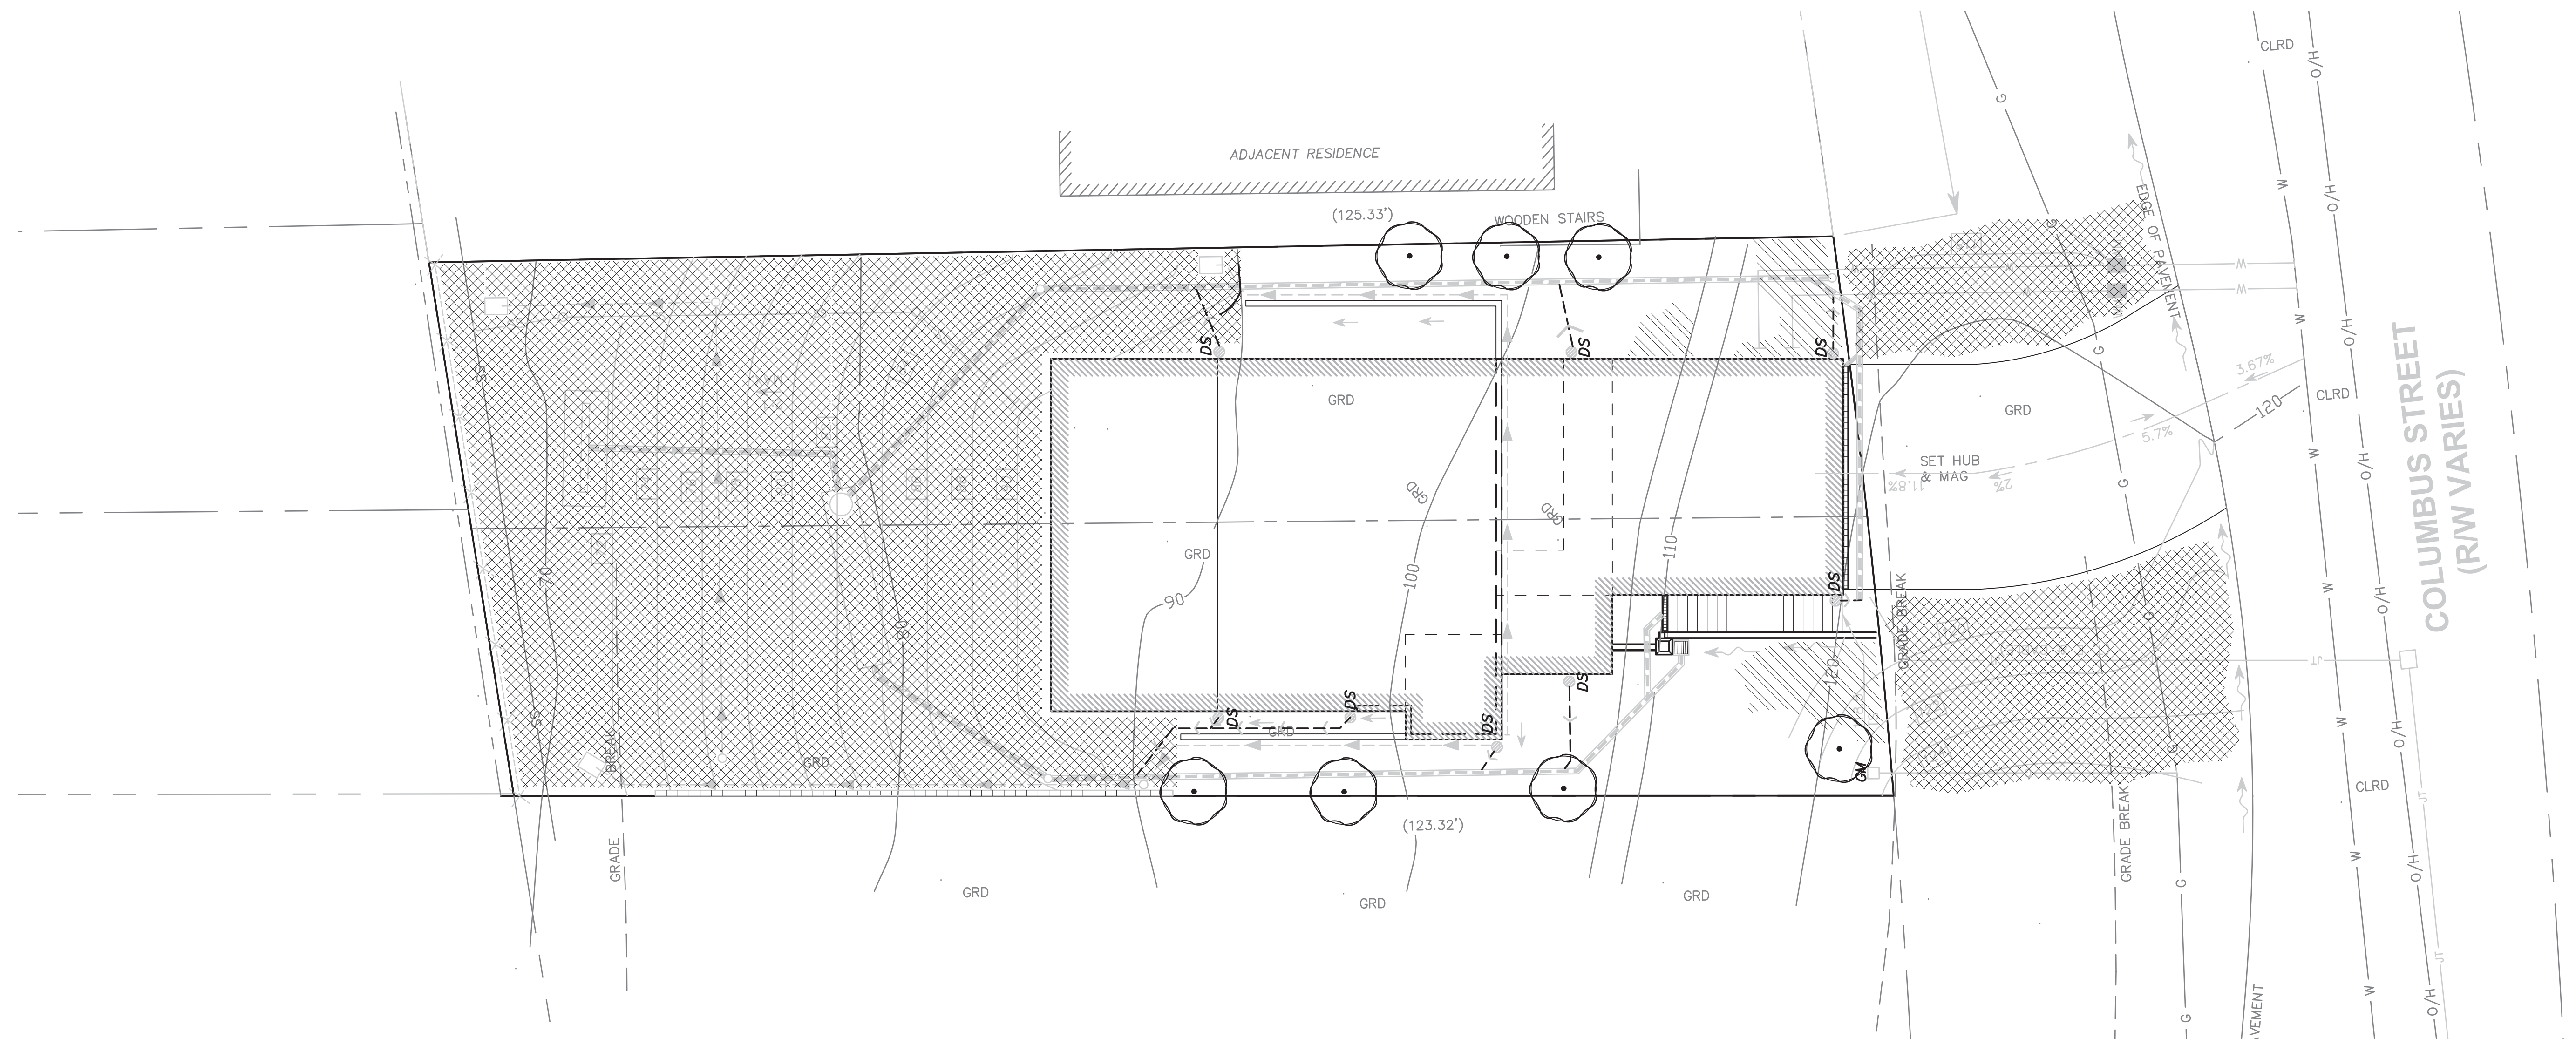

**MAINTENANCE DURING THE WARRANTY PERIOD** by the plant installer  
 During the warranty period, provide all maintenance for all plantings to keep the plants in a healthy state and the planting areas clean and neat.


**General requirements:**

- All work shall be undertaken by trained planting crews under the supervision of a foreman with a minimum of 5 years experience supervising commercial plant maintenance crews.
- All chemical and fertilizer applications shall be made by licensed applicators for the type of chemicals to be used. All work and chemical use shall comply with all applicable local, provincial and federal requirements.
- Assure that hoses and watering equipment and other maintenance equipment does not block paths or be placed in a manner that may create tripping hazards. Use standard safety warning barriers and other procedures to maintain the site in a safe manner for visitors at all times.
- All workers shall wear required safety equipment and apparel appropriate for the tasks being undertaken.
- The Contractor shall not store maintenance equipment at the site at times when they are not in use unless authorized in writing by the Owner's Representative.
- Maintenance vehicles shall not park on the site including walks and lawn areas at any time without the Owner's Representative's written permission.
- Maintain a detailed log of all maintenance activities including types of tasks, date of task, types and quantities of materials and products used, watering times and amounts, and number of each crew. Periodically review the logs with the Owner's Representative, and submit a copy of the logs at the end of each year of the maintenance agreement.
- Meet with the Owner's Representative a minimum of three times a year to review the progress and discuss any changes that are needed in the maintenance program. At the end of the warranty period attend a hand over meeting to formally transfer the responsibilities of maintenance to the Owner's Representative. Provide all information on past maintenance activities and provide a list of critical tasks that will be needed over the next 12 months. Provide all maintenance logs and soil test data. Make the Contractor's supervisor available for a minimum of one year after the end of the warranty period to answer questions about past maintenance.
- Provide the following maintenance tasks:
  - Watering; Provide all water required to keep soil within and around the root balls at optimum moisture content for plant growth.
  - Maintain all watering systems and equipment and keep them operational.
  - Monitor soil moisture to provide sufficient water. Check soil moisture and root ball moisture with a soil moisture meter on a regular basis and record moisture readings. Do not over water.
  - Soil nutrient levels: Take a minimum of 4 soil samples from around the site in the spring and fall and have them tested by an accredited agricultural soil testing lab for chemical composition of plant required nutrients, pH, salt and % organic matter. Test results shall include laboratory recommendations for nutrient applications. Apply fertilizers at rates recommended by the soil test.
  - Make any other soil test and/or plant tissue test that may be indicated by plant conditions that may not be related to soil nutrient levels such as soil contaminated by other chemicals or lack of chemical uptake by the plant.

- Plant pruning: Remove cross over branching, shorten or remove developing co dominant leaders, dead wood and winter-damaged branches. Unless directed by the Owner's Representative, do not shear plants or make heading cuts.
- Restore plants: Reset any plants that have settled or are leaning as soon as the condition is noticed.
- Guying and staking: Maintain plant guys in a taught position. Remove tree guys and staking after the first full growing season unless directed by Owner's Representative.
- Weed control: Keep all beds free of weeds. Hand-remove all weeds and any plants that do not appear on the planting plan. Chemical weed control is permitted only with the approval of the Owner's Representative. Schedule weeding as needed but not less 12 times per year.
- Trash removal: Remove all trash and debris from all planting beds and maintain the beds in a neat and tidy appearance. The number of trash and debris removal visits shall be no less than 12 times per year and may coincide with other maintenance visits.
- Plant pest control: Maintain disease, insects and other pests at manageable levels. Manageable levels shall be defined as damage to plants that may be noticeable to a professional but not to the average person. Use least invasive methods to control plant disease and insect outbreaks.
- The Owner's Representative must approve in advance the use of all chemical pesticide applications.
- Plant replacement: Replace all plants that are defective as defined in the warranty provisions, as soon as the plant decline is obvious and in suitable weather and season for planting as outlined in above sections. Plants that become defective during the maintenance period shall be covered and replaced under the warranty provisions.
- Mulch: Refresh mulch once a year to maintain complete coverage but do not over mulch. At no time shall the overall mulch thickness be greater than 3 inches. Do not apply mulch within 6 inches of the trunks or stems of any plants. Replacement mulch shall meet the requirements of the original approved material. Mulch shall be no more than one inch on top of the root ball surface.
- Bed edging: Check and maintain edges between mulch and lawn areas in smooth neat lines as originally shown on the drawings.
- Leaf, fruit and other plant debris removal: Remove fall leaf, spent flowers, fruit and plant part accumulations from beds and paved surfaces. Maintain all surface water drains free of debris. Debris removal shall be undertaken at each visit to weed or pick up trash in beds.
- Damage from site use: Repair of damage by site visitors and events, beyond normal wear, are not part of this maintenance. The Owner's Representative may request that the Contractor repair damage beds or plantings for an additional cost. All additional work shall be approved in advance by the Owner's Representative.

**PLANT SCHEDULE**

TREES	CODE	QTY	BOTANICAL / COMMON NAME	CONT	REMARKS	
	CUP SEM	7	CUPRESSUS SEMPERVIRENS / ITALIAN CYPRESS	15 GAL		
SHRUBS	CODE	QTY	BOTANICAL / COMMON NAME	CONT	REMARKS	
	CEA VAL	1	CEANOTHUS MARITIMUS 'VALLEY VIOLET' / MARITIME CEANOTHUS	5 GAL	LOW	
GROUND COVERS	CODE	QTY	BOTANICAL / COMMON NAME	CONT	SPACING	REMARKS
	MYO PAR	386	MYOPORUM PARVIFOLIUM / TRAILING MYOPORUM	1 GAL	36" o.c.	WATER USE LOW
	SAL BEE	13	SALVIA X 'BEE'S BLISS' / SAGE	1 GAL	48" o.c.	LOW

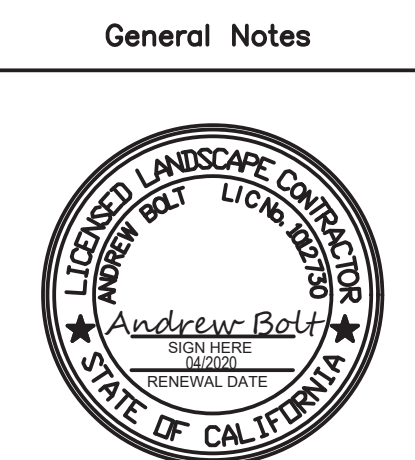

**PLANTING LAYOUT**

No.	Revision/Issue	Date




**Project Name and Address**  
 COLUMBUS ST.  
 EL GRANADA, CA

<b>Project</b> 236-2019	<b>Drawn By</b> 4Binc.
<b>Date</b> 9/10/19	<b>Checked By</b> 4Binc.
<b>Scale</b> 1/8"=1'-0"	<b>Approved By</b>
	<b>Sheet</b> L-1.0








"I HAVE COMPLIED WITH THE LANDSCAPE DESIGN CRITERIA OF THE MODEL WATER EFFICIENT LANDSCAPE ORDINANCE AND APPLIED THEM ACCORDINGLY FOR THE EFFICIENT USE OF WATER IN THIS DESIGN."  
 DATED: 6/15/2020  
 BY: Andrew Bolt



THESE PLANS ARE THE PROPERTY OF 4B INCORPORATED AND CAN NOT BE COPIED WITHOUT PERMISSION.

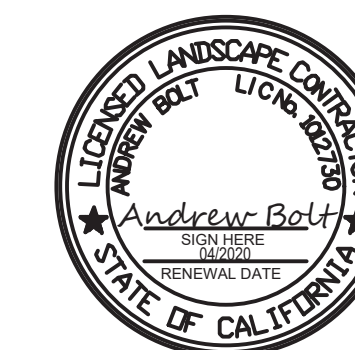

PLANTING DETAILS

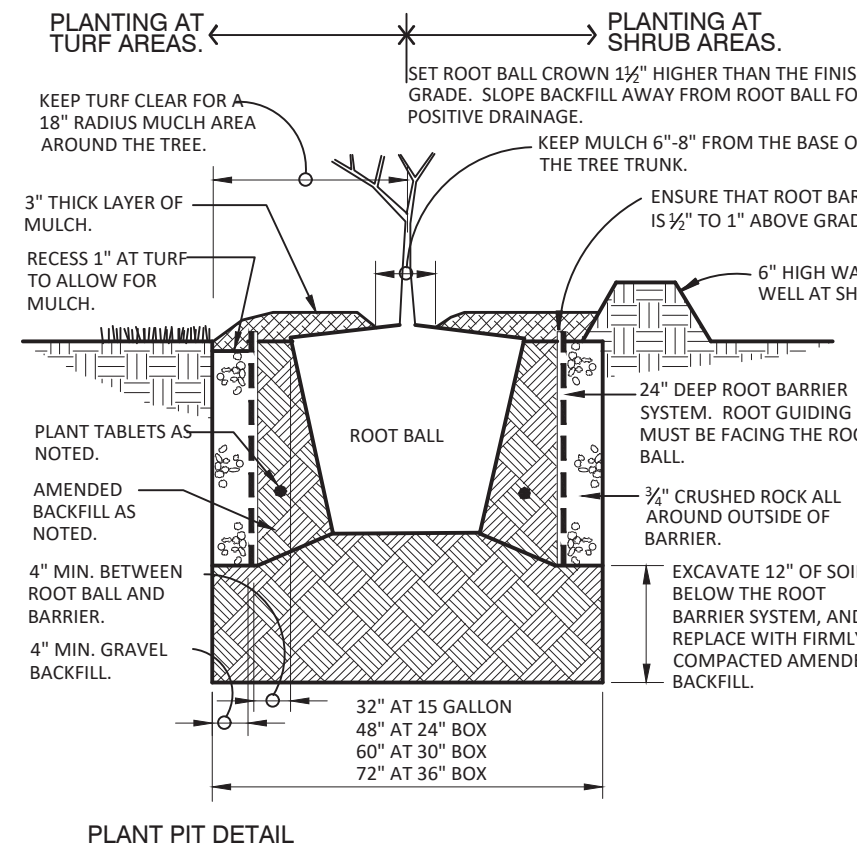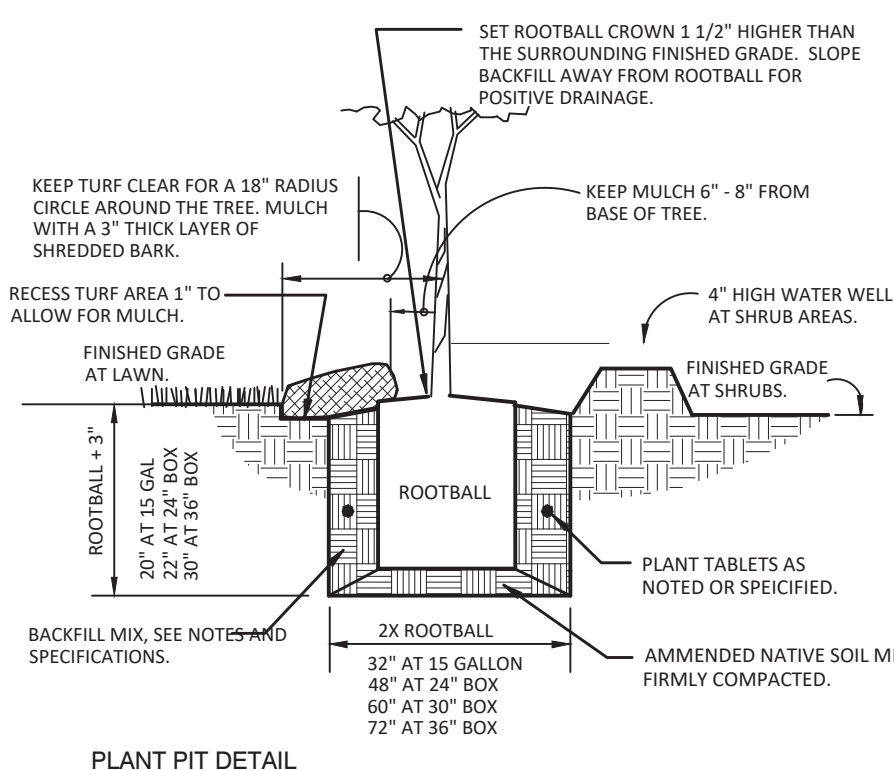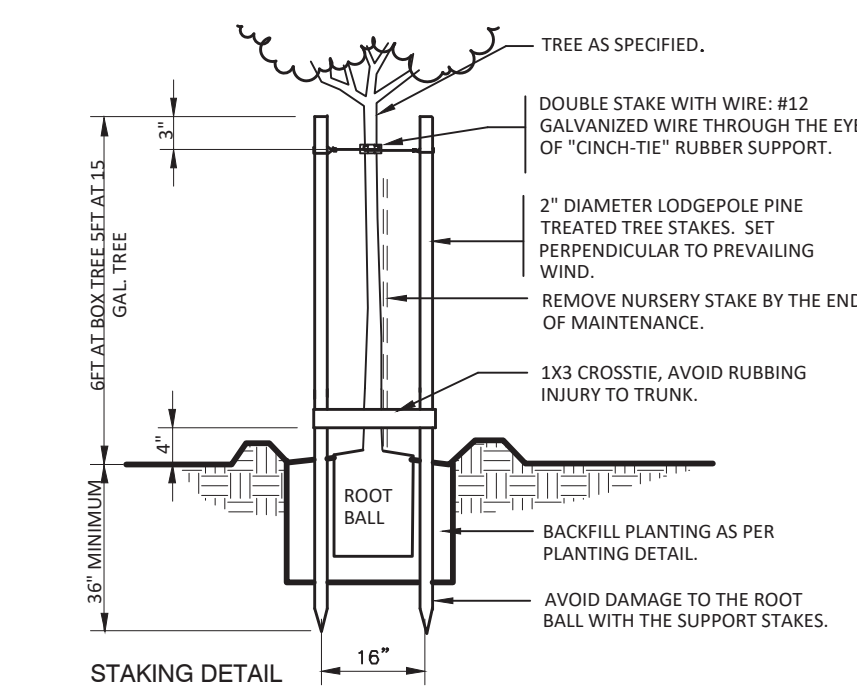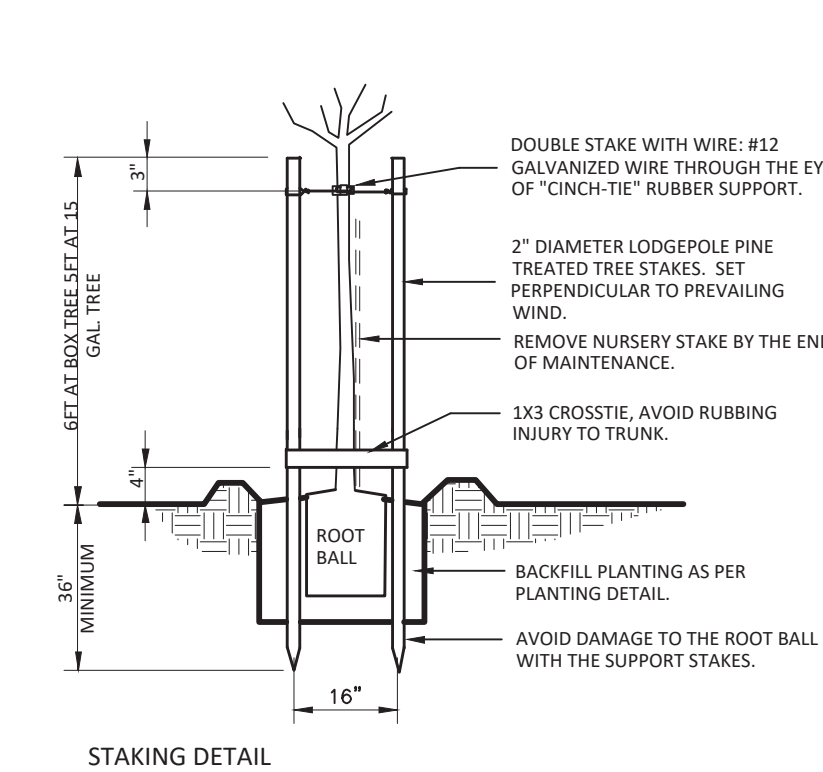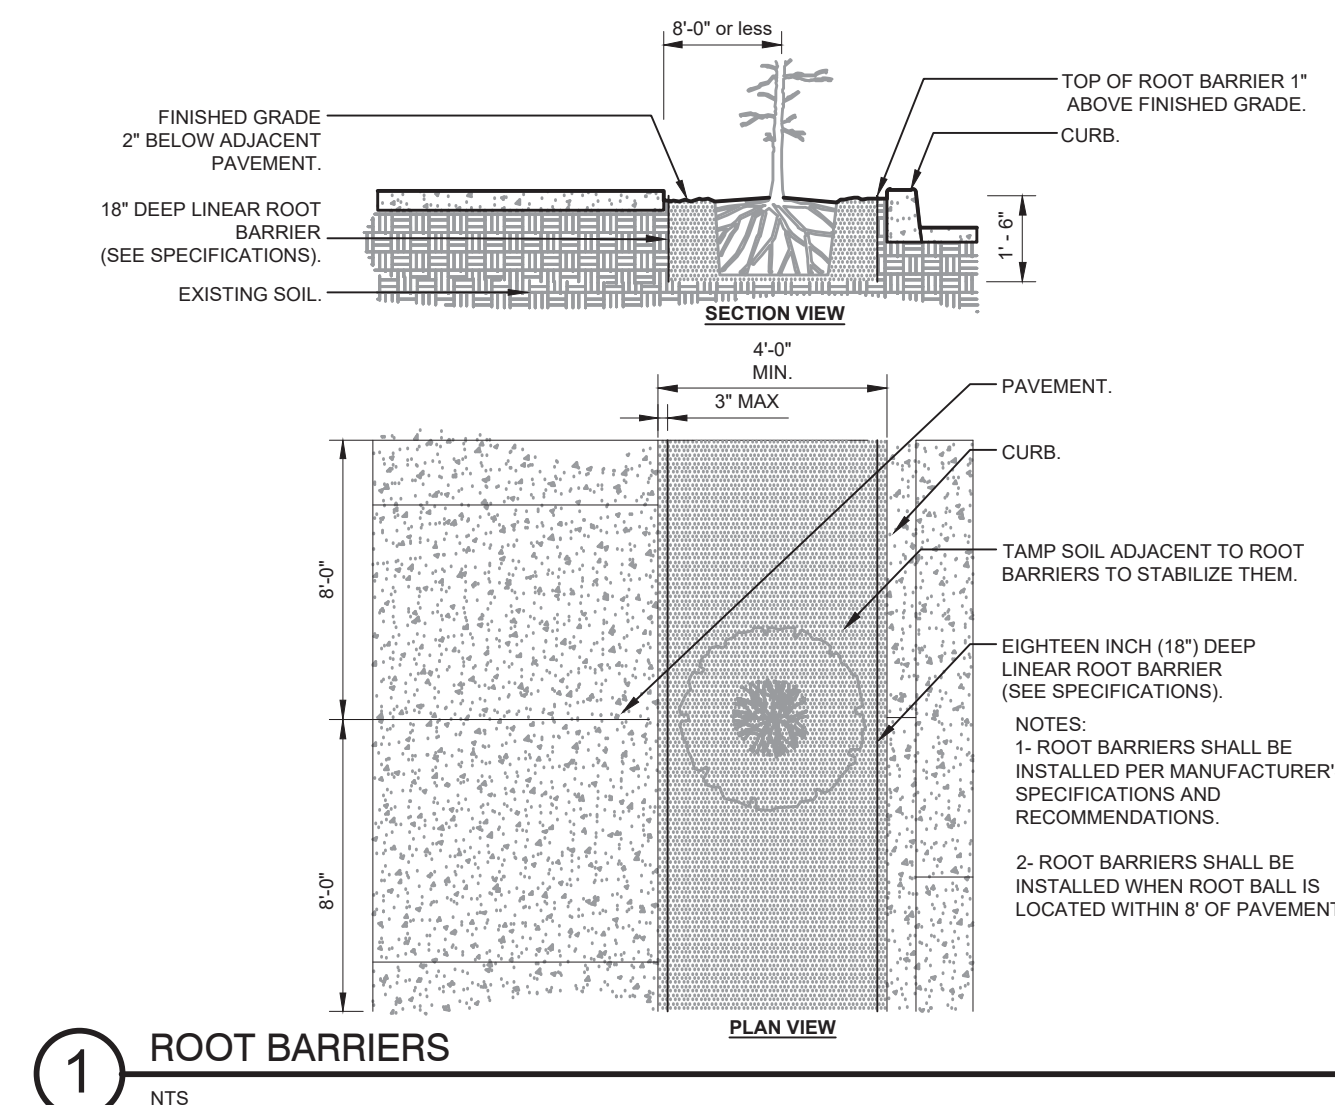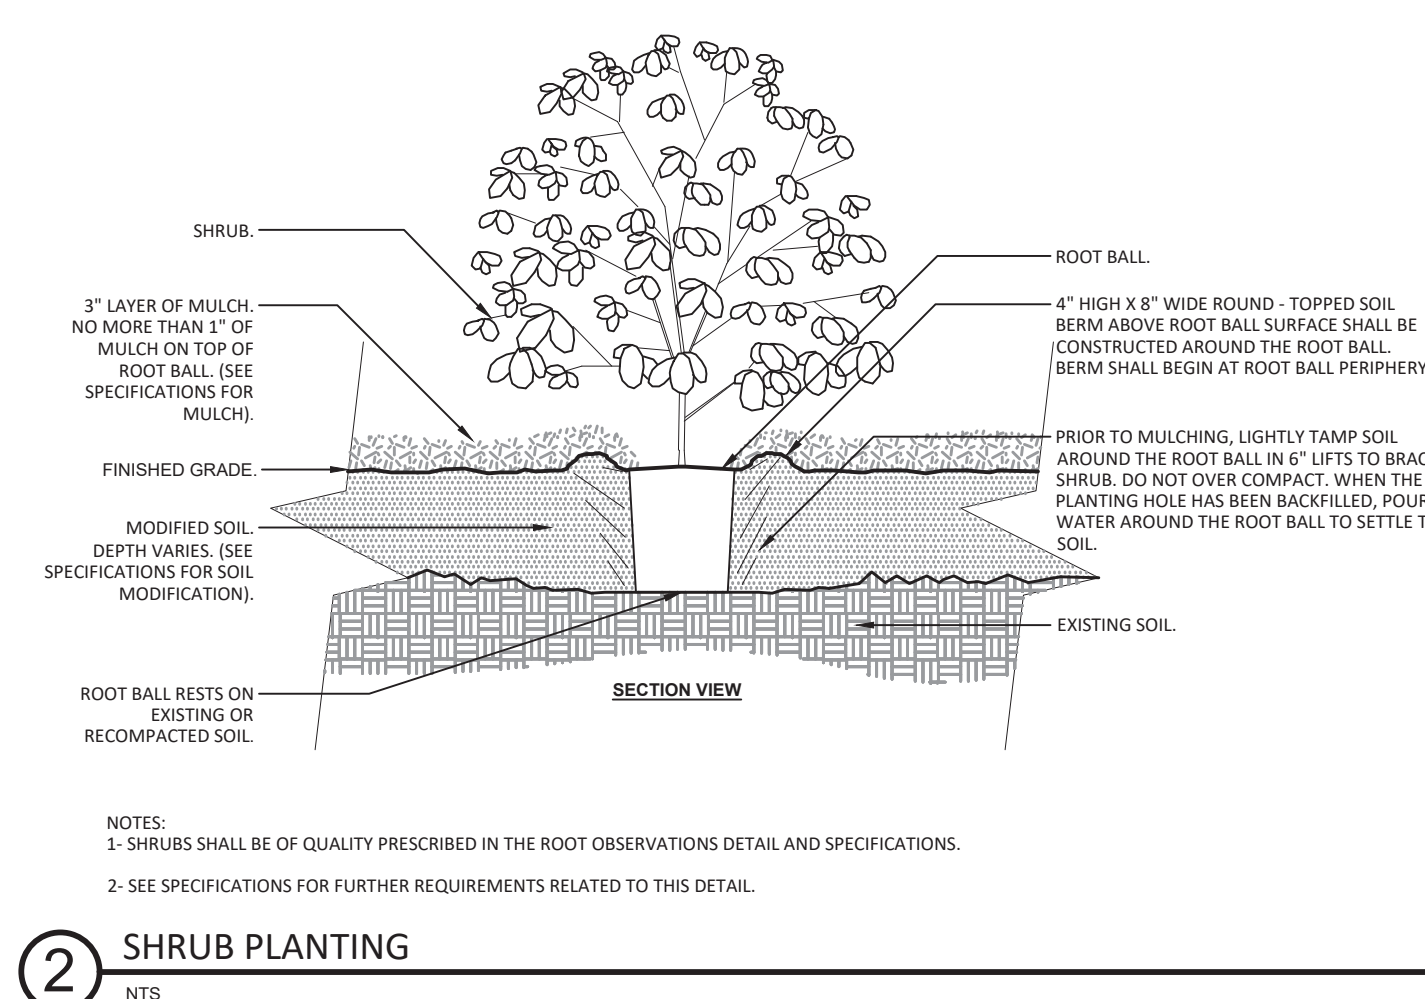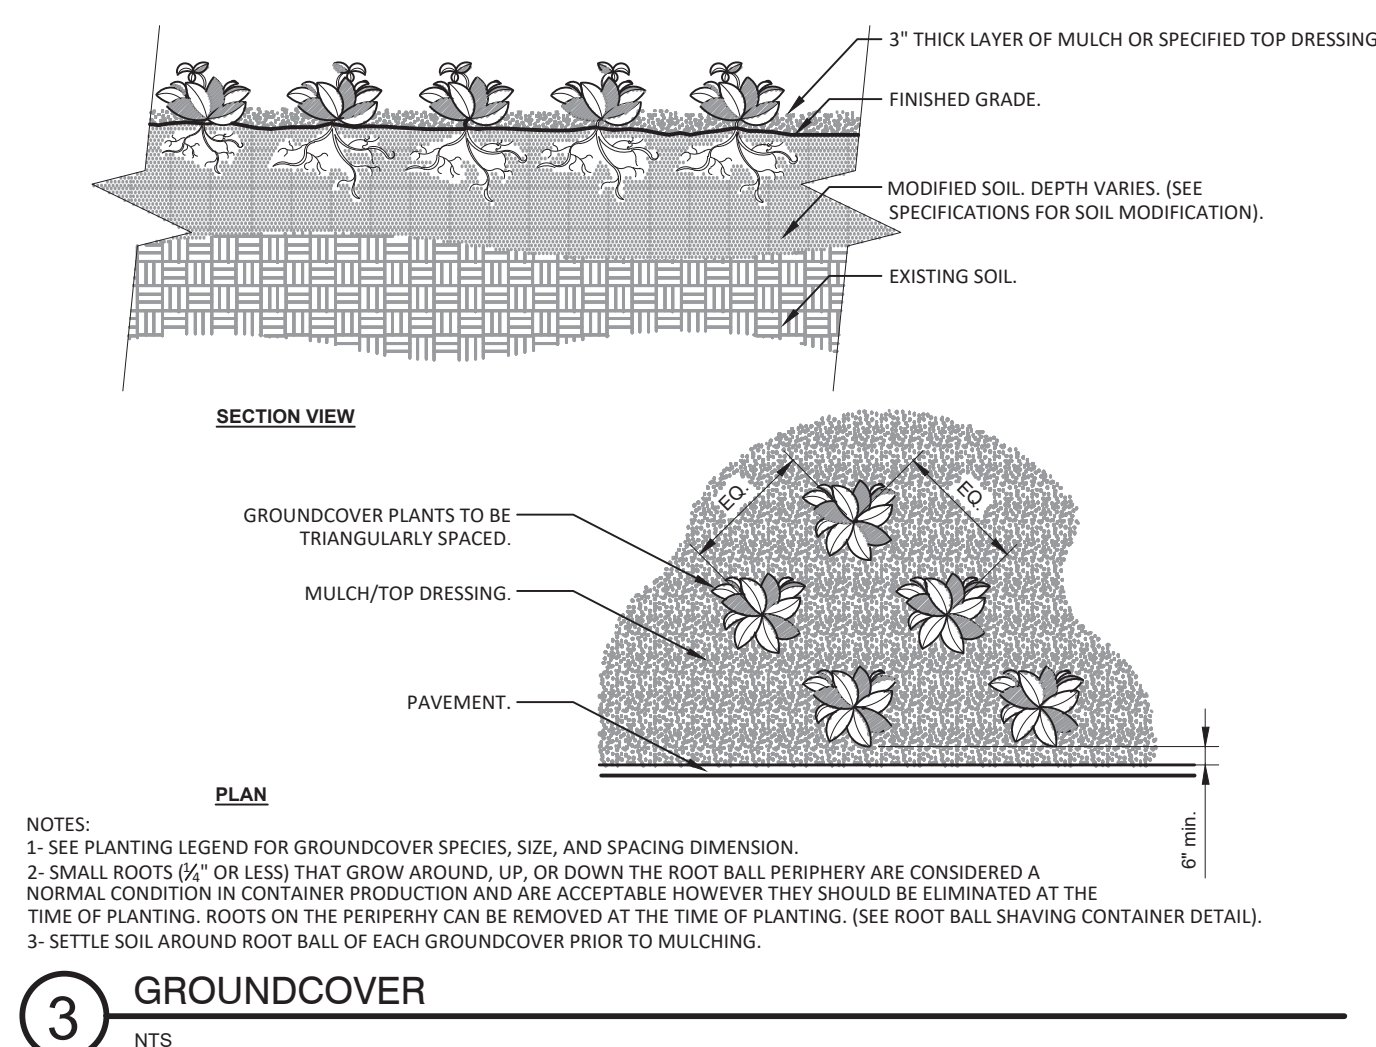

"I HAVE COMPLIED WITH THE LANDSCAPE DESIGN CRITERIA OF THE MODEL WATER EFFICIENT LANDSCAPE ORDINANCE AND APPLIED THEM ACCORDINGLY FOR THE EFFICIENT USE OF WATER IN THIS DESIGN."  
DATED: 6/15/2020  
BY: Andrew Bolt



THESE PLANS ARE THE PROPERTY OF 4B INCORPORATED AND CANNOT BE COPIED WITHOUT PERMISSION

No.	Revision/Issue	Date

Firm Name and Address

**4Binc**  
Select Certified  
IRRIDIGATION ASSOCIATION  
LIC # 1012750 IA CERT # 57436

**ASIC**  
COMMERCIAL MEMBER

Project Name and Address

**COLUMBUS ST.  
EL GRANADA, CA**

Project	236-2019	Drawn By	4Binc.
Date	9/10/19	Checked By	4Binc.
Scale		Approved By	
		Sheet	



General Notes



IRRIGATION LAYOUT

No.	Revision/Issue	Date


Firm Name and Address

Project Name and Address

**COLUMBUS ST.  
EL GRANADA, CA**

Project	236-2019	Drawn By	4Binc.
Date	9/10/19	Checked By	4Binc.
Scale	1/8"=1'-0"	Approved By	
		Sheet	IR-1.0

THESE PLANS ARE THE PROPERTY OF 4B INCORPORATED AND CAN NOT BE COPIED WITHOUT PERMISSION.

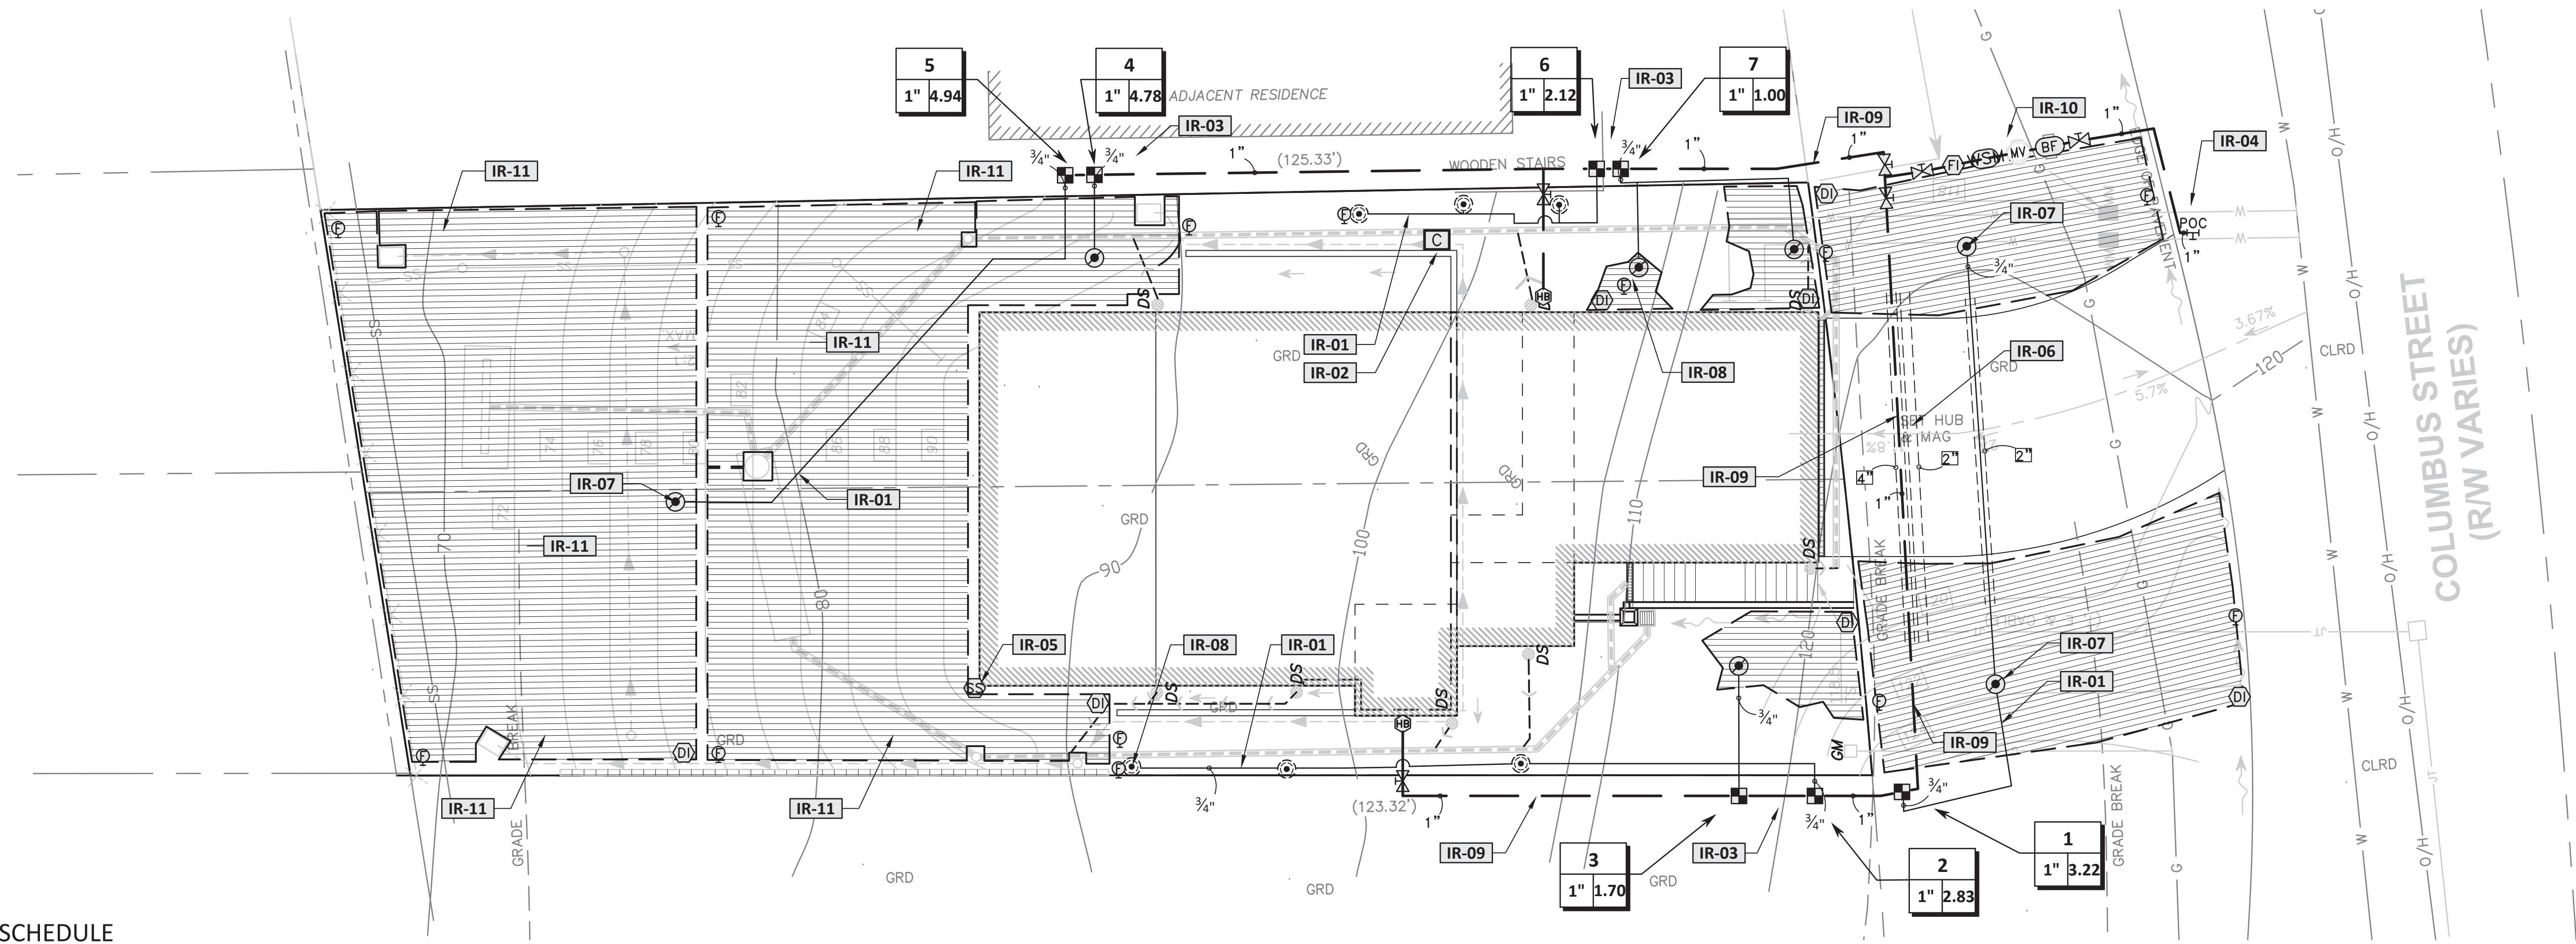

IRRIGATION SCHEDULE

SYMBOL	MANUFACTURER/MODEL/DESCRIPTION
	TORO DZK-700-1-MF MEDIUM-FLOW DRIP CONTROL VALVE KIT. WITH 1" IRRITROL 700 ULTRAFLOW INLINE VALVE, TORO Y-FILTER, AND MEDIUM-FLOW PRESSURE REGULATOR AND FITTINGS. 5GPM-20GPM.
	PIPE TRANSITION POINT PVC-PLOY PIPE TRANSITION POINT.
	NETAFIM TISOV NETAFIM TISOV- 1/2" MANUAL FLUSH VALVE, BARBED INSERT. INSTALL IN 10" BOX, WITH ADEQUATE BLANK OR "COBRA" TUBING TO EXTEND VALVE OUT OF VALVE BOX. 17MM FITS TECHLINE HCVXR, HCVXR-RW/RWP, CV, DL, RW AND RWP DRIP LINES, AND PE IRRIGATION HOSE
	RAIN BIRD OPERIND DRIP SYSTEM OPERATION INDICATOR, STEM RISES 6" FOR CLEAR VISIBILITY WHEN DRIP SYSTEM IS CHARGED TO A MINIMUM OF 20PSI. INCLUDES 16" OF 1/4" DISTRIBUTION TUBING WITH CONNECTION FITTING PRE-INSTALLED. INSTALL MINIMUM TWO PER DRIP ZONE, PLACE NEXT TO FLUSH VALVE.
	TREE DRIP RING 1.0 GPH TREE DRIP RING TORO RGP-212 / 1.0 GPH. INSTALL PER DETAIL. 3 RINGS = 42.5 GPH 4 RINGS = 69.5 GPH. INSTALL (2) ROOTWELL 318-C EVENLY AROUND THE ROOT BALL OF EVERY PROPOSED TREE
	AREA TO RECEIVE DRIP EMITTERS NETAFIM WPC WITH BUG CAP SINGLE OUTLET PRESSURE COMPENSATING DRIP EMITTER, 5PSI INTERNAL CHECK VALVE, WITH A BARB INLET X NIPPLE OUTLET. BUG CAP INCLUDED. RED= 0.5GPH, BLACK= 1.0GPH, GREEN= 2.0GPH. Emitter Notes: 2.0 GPH emitters (3 assigned to each 1 Gal plant) 2.0 GPH emitters (3 assigned to each 5 Gal plant)
	AREA TO RECEIVE DRIPLINE NETAFIM TLHCVXR-053-18 TECHLINE HCVXR PRESSURE COMPENSATING LANDSCAPE DRIPLINE WITH CHECK VALVE AND ANTI-SIPHON FEATURE. 0.53 GPH EMITTERS AT 18" O.C. DRIPLINE LATERALS SPACED AT 18" APART, WITH EMITTERS OFFSET FOR TRIANGULAR PATTERN. 17MM.
SYMBOL	MANUFACTURER/MODEL/DESCRIPTION
	BUCKNER-SUPERIOR HB1F 3/4" X 1/2" FEMALE NPT RED BRASS HOSE BIBB. INSTALL BELOW GRADE WITHIN A 1416 VALVE BOX, TYPICAL
	NIBCO T-113 CLASS 125 BRONZE GATE SHUT OFF VALVE WITH WHEEL HANDLE. SAME SIZE AS MAINLINE PIPE DIAMETER AT VALVE LOCATION. SIZE RANGE - 1/4" - 3"

SYMBOL	MANUFACTURER/MODEL/DESCRIPTION
	BUCKNER-SUPERIOR 3300 1-1/2" NORMALLY OPEN BRASS MASTER VALVE THAT PROVIDES DIRTY WATER PROTECTION AND NO MINIMUM FLOW FEATURE, WHICH ENSURES RELIABLE OPENING AND CLOSING OF THE VALVE IN EXTREME HIGH OR LOW FLOW SCENARIOS. AVAILABLE IN 1-1/2", 2", 2-1/2" AND 3".
	FEBCO 825Y 3/4" REDUCED PRESSURE BACKFLOW PREVENTER WITH FREEZE BLANKET PER CITY STANDARDS
	HUNTER HC-12 12 STATION CONTROLLER WITH WI-FI CONNECTION
	HUNTER WSS WIRELESS SOLAR, RAIN FREEZE SENSOR WITH OUTDOOR INTERFACE, CONNECTS TO HUNTER PCC, PRO-C, AND I-CORE CONTROLLERS, INSTALL AS NOTED. INCLUDES 10 YEAR LITHIUM BATTERY AND RUBBER MODULE COVER, AND GUTTER MOUNT BRACKET.
	HUNTER HC-075-FLOW 3/4" FLOW METER FOR USE WITH HYDRAWISE ENABLED CONTROLLER TO MONITOR FLOW AND PROVIDE SYSTEM ALERTS. ALSO FUNCTIONS AS STAND ALONE FLOW TOTALIZER/SUB METER ON ANY RESIDENTIAL OR COMMERCIAL IRRIGATION SYSTEM.
	EZ-FLO FERTILIZING SYSTEMS EZ001-CX ONE SYSTEM FEEDS ALL ZONES, DRIP OR SPRINKLER. INSTALL DIRECTLY IN THE IRRIGATION SYSTEM MAIN LINE AFTER THE BACK FLOW PREVENTER. TANK CAPACITY: 1.5 G. USE LIQUID ORGANIC FERTILIZER OR CONTACT EZ FLOW FOR RECOMMENDED FERTILIZERS.
	POINT OF CONNECTION 1"
	IRRIGATION LATERAL LINE: PVC CLASS 200 SDR 21 INSTALL ALL LATERAL LINES TO A DEPTH OF 12" BELOW FINISH GRADE. PIPE TO SHRUB IRRIGATION ONLY. BACKFILL WITH CLEAN FILL NO ROCKS OVER 1/2" IN SIZE.
	IRRIGATION MAINLINE: PVC SCHEDULE 40 INSTALL ALL MAINLINE TO A DEPTH OF 18" UNLESS OTHERWISE NOTED. BACKFILL WITH CLEAN FILL NO ROCKS OVER 1/2" IN SIZE. NOTE ALL MAINLINE LOCATION ON ASBUILT PLANS.
	PIPE SLEEVE: PVC SCHEDULE 40 INSTALL SLEEVE 12" PAST EDGE OF HARDSCAPE TO A DEPTH OF 24" FOR MAINLINE AND 18" FOR LATERAL LINES. ALL OTHER SLEEVING INSTALL TO A DEPTH OF 12".
	Valve Callout # Valve Number # Valve Flow # Valve Size

CRITICAL ANALYSIS

Generated: 2019-09-10 17:59

P.O.C. NUMBER: 01  
Water Source Information:

FLOW AVAILABLE  
Point of Connection Size: 1"  
Flow Available: 20.24 gpm

PRESSURE AVAILABLE  
Static Pressure at POC: 50.00 psi  
Pressure Available: 50.00 psi

DESIGN ANALYSIS  
Maximum Station Flow: 4.94 gpm  
Flow Available at POC: 20.24 gpm  
Residual Flow Available: 15.30 gpm

Critical Station: 3  
Design Pressure: 30.00 psi  
Friction Loss: 0.57 psi  
Fittings Loss: 0.06 psi  
Elevation Loss: 0.00 psi  
Loss through Valve: 3.00 psi  
Pressure Req. at Critical Station: 33.63 psi  
Loss for Fittings: 0.07 psi  
Loss for Main Line: 0.73 psi  
Loss for POC to Valve Elevation: 0.00 psi  
Loss for Backflow: 11.68 psi  
Loss for Master Valve: 0.45 psi  
Critical Station Pressure at POC: 46.56 psi  
Pressure Available: 50.00 psi  
Residual Pressure Available: 3.44 psi

IRRIGATION NOTES:

- POINT OF CONNECTION (P.O.C.)**
- CONNECT IRRIGATION MAINLINE TO MAIN WATER SUPPLY (SEE CIVIL OR ARCHITECTURAL DRAWINGS FOR LOCATION). LANDSCAPE CONTRACTOR TO VERIFY LOCATION, SIZE, FLOW AND PRESSURES AVAILABLE AND TO NOTIFY LANDSCAPE ARCHITECT OF ANY NECESSARY CHANGES NEEDED TO BE MADE SO THAT THE IRRIGATION SYSTEM PERFORMS TO AN IRRIGATION EFFICIENCY OF A MINIMUM OF 81 PERCENT.
  - SYSTEM MAXIMUM OPERATING PRESSURES: 80 PSI (AT P.O.C.) INSTALL PRESSURE REDUCER IF PRESSURES EXCEED EQUIPMENT MANUFACTURERS SUGGESTED MAXIMUM OPERATING PRESSURES.
  - SYSTEM MINIMUM OPERATING PRESSURES: 47 PSI (AT P.O.C.)

MWELO NOTES  
CERTIFICATION OF COMPLETION REQUIREMENTS

UPON COMPLETION OF LANDSCAPE AND IRRIGATION INSTALLATION THE LANDSCAPE CONTRACTOR SHALL SUBMIT THE FOLLOWING AS REQUIRED BY CALIFORNIA MODEL WATER EFFICIENT LANDSCAPE ORDINANCE. (MWELO)


REFERENCE NOTES SCHEDULE

SYMBOL	IRRIGATION DESCRIPTION
	LATERAL LINES- ALL LATERALS ARE SIZED 3/4" UNLESS OTHERWISE NOTED.
	CONTROLLER LOCATION- CONTRACTOR TO CONFIRM LOCATION WITH OWNER OR GENERAL CONTRACTOR.
	SCHEMATIC VALVE BOX LOCATION- INSTALL ALL VALVE BOXES IN PLANTER AREAS AND SET BACK 2 FEET FROM ANY PATHS, ROADS OR OTHER HARDSCAPE AREAS.
	POINT OF CONNECTION- CONTRACTOR TO CONFIRM POC LOCATION, WELL STATIC PRESSURE AND FLOWS AVAILABLE. IF LOCATION IS DIFFERENT INDICATE ON AS BUILT PLANS. IF STATIC PRESSURE AVAILABLE IS UNDER 45 PSI NOTIFY LANDSCAPE ARCHITECT PRIOR TO PROCEEDING WITH IRRIGATION INSTALLATION.
	WEATHER BASED SENSOR LOCATION- INSTALL WEATHER SENSOR ON SW SIDE OF BUILDING WITH NO OVERHANG OBSTRUCTIONS.
	CONDUIT- FOR CONTROL VALVE WIRE RUN(S) TO CONTROLLER, SIZE PER PLAN
	INLINE DRIP SUPPLY AND EXHAUST HEADERS- CONTRACTOR MUST INSTALL PVC SUPPLY AND EXHAUST HEADERS ON ALL DRIP SYSTEMS PER DETAILS ON THE IRRIGATION DETAIL SHEET(S). ALL SUBSURFACE DRIP MUST TERMINATE IN A PVC EXHAUST HEADER. PLANS ONLY SHOW SUPPLY TAP-IN LOCATION.
	TREE DRIP RING- FOR PROPOSED TREES
	MAIN LINE- INSTALL MAIN LINE IN PLANTER AREAS WITHIN THE SITES PROPERTY BOUNDARIES AND SET BACK 2 FEET FROM ANY PATHS, ROADS OR OTHER HARDSCAPE AREAS. THE PROPOSED MAIN LINE LOCATION(S) IS DIAGRAMMATIC.
	MASTER CONTROL VALVE & HUNTER HC FLOW METER- INSTALLING CONTRACTOR IS RESPONSIBLE FOR INSTALLING AND PROGRAMMING MASTER VALVE AND FLOW METER AT THE IRRIGATION CONTROLLER. CONTACT MANUFACTURER FOR ASSISTANCE WITH SET UP.
	EROSION CONTROL- REFER TO CIVIL ENGINEER PLANS, SHEET C-2 FOR JUTE MESH (OVER GRADED SLOPES) SPECIFICATION AND DETAILS


LANDSCAPE MWELO GENERAL NOTES:

- A CERTIFICATE OF COMPLETION SHALL BE COMPLETED BY EITHER THE OWNER, THE DESIGNER OF THE LANDSCAPE PLANS OR BY THE LICENSED INSTALLING CONTRACTOR.
- AN AS BUILT DIAGRAM OF THE INSTALLED IRRIGATION SHOWING NUMBERED ZONES, VALVE LOCATION, MAINLINE LOCATION, IRRIGATION CONTROLLER AND P.O.C. LOCATION SHALL BE KEPT WITH THE CONTROLLER FOR SUBSEQUENT MANAGEMENT PURPOSES.
- CHECK VALVES ARE REQUIRED ON ALL SPRINKLER HEADS WHERE LOW HEAD DRAINAGE COULD OCCUR.
- PRESSURE REGULATING DEVICES ARE REQUIRED IF WATER OPTIMUM PRESSURE OF THE SPECIFIED IRRIGATION DEVICE PRESSURE EXCEEDS THE OPERATING RECOMMENDATIONS.
- NO OVERHEAD IRRIGATION IS PERMITTED IN LANDSCAPE AREAS THAT ARE LESS THAN 10' WIDE. DRIP OR LOW FLOW BUBBLER IRRIGATION MUST BE USED AS AN ALTERNATIVE.
- INSTALLING CONTRACTOR IS RESPONSIBLE FOR INSTALLING AND PROGRAMMING ALL SELF ADJUSTING WEATHER/SOIL MOISTURE SENSING BASED CONTROLLERS. RAIN SENSORS ARE TO BE INSTALLED WITH ANY CONTROLLER WHERE AN OFFSITE WEATHER STATION IS USED.
- ALL SPECIFIED FLOW SENSORS AND MASTER VALVES MUST BE INSTALLED AND PROGRAMMED AS PER MANUFACTURERS REQUIREMENTS.
- AN IRRIGATION AUDIT AND COMMISSIONING IS REQUIRED ON ALL PROJECTS. CONTACT ANDREW BOLT 209-404-1746 TO SET UP.
- THESE PLANS HAVE BEEN PREPARED BY A CERTIFIED PROFESSIONAL AND ARE MEANT AS A GUIDE ONLY. PIPING AND VALVE PLACEMENT ARE DIAGRAMMATIC ONLY. ALL PIPING UNDER HARDSCAPES MUST BE SLEEVED WITH SPECIFIED SLEEVING MATERIALS.
- PROTECT ALL EXISTING TREES DURING IRRIGATION TRENCHING AND PIPE INSTALLATION. CONSULT WITH LANDSCAPE ARCHITECT BEFORE CUTTING ANY ROOTS.
- NOTE TO CONTRACTOR: ALL IRRIGATION ZONES HAVE BEEN LAYED OUT AND APPROVED BY THE CITY OR COUNTY BASED ON PLANT WATER USE. SHOULD THE INSTALLING CONTRACTOR CHANGE OR MODIFY THE APPROVED IRRIGATION LAYOUT IN ANYWAY WITHOUT PRIOR AUTHORIZATION THE CONTRACTOR WILL ASSUME ALL LIABILITY AND COST OF ALL CHANGES TO THE IRRIGATION LAYOUT AND ALL ADDITIONAL WATER USAGE OVER AND ABOVE FOR THE LIFE OF THE IRRIGATION SYSTEM(S) AND ALL COSTS THAT ARE ASSOCIATED WITH OVER WATER USAGE.

"I HAVE COMPLIED WITH THE LANDSCAPE DESIGN CRITERIA OF THE MODEL WATER EFFICIENT LANDSCAPE ORDINANCE AND APPLIED THEM ACCORDINGLY FOR THE EFFICIENT USE OF WATER IN THIS DESIGN."  
DATED: 6/15/2020  
By: Andrew Bolt

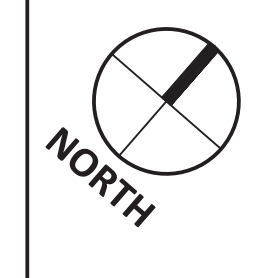

General Notes

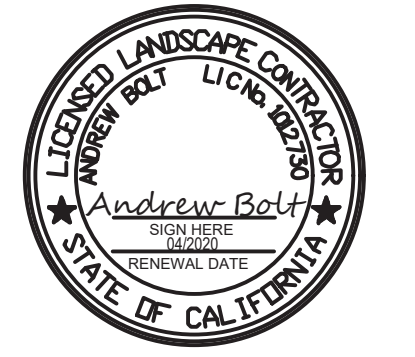

IRRIGATION DETAILS

No.	Revision/Issue	Date

Firm Name and Address


4Binc Select Certified  
 Irrigation Association  
 ASIC Commercial Member  
 LIC # 302220 LA CERT # 57436

Project Name and Address


**COLUMBUS ST. EL GRANADA, CA**

Project	236-2019	Drawn By	4Binc.
Date	9/10/19	Checked By	4Binc.
Scale		Approved By	
		Sheet	


IR-2.0

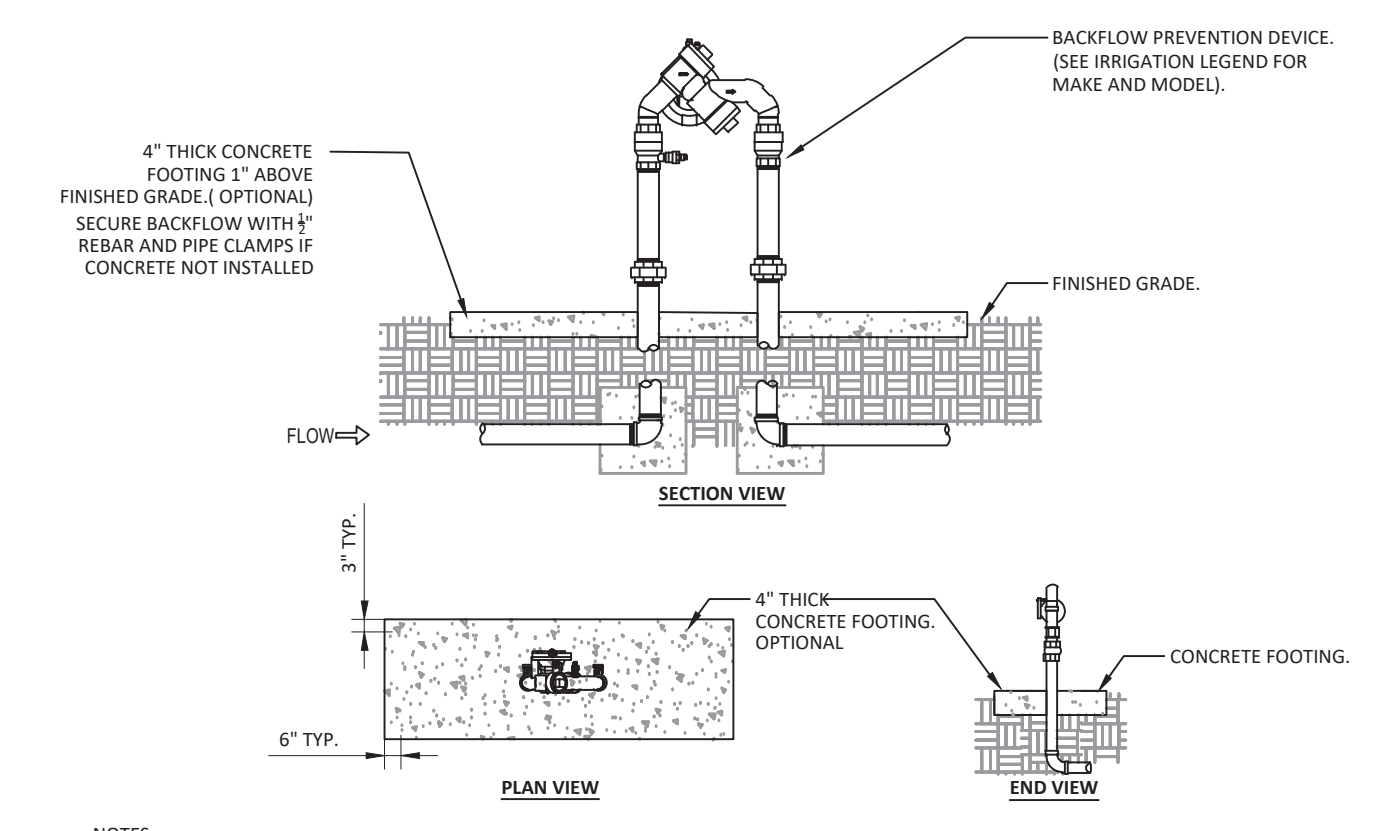


**1 BACKFLOW FEBCO 825YA PREVENTER**  
 NTS  
 AB-IR-BAC-02

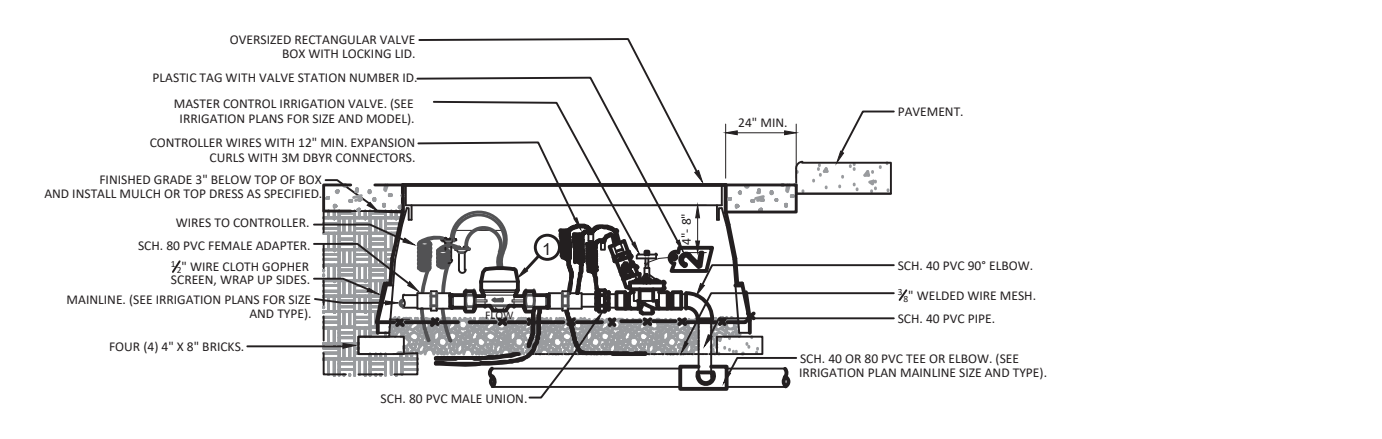


**4 MASTER CONTROL VALVE & HUNTER HC FLOW METER**  
 1" = 1'-0"  
 NTS

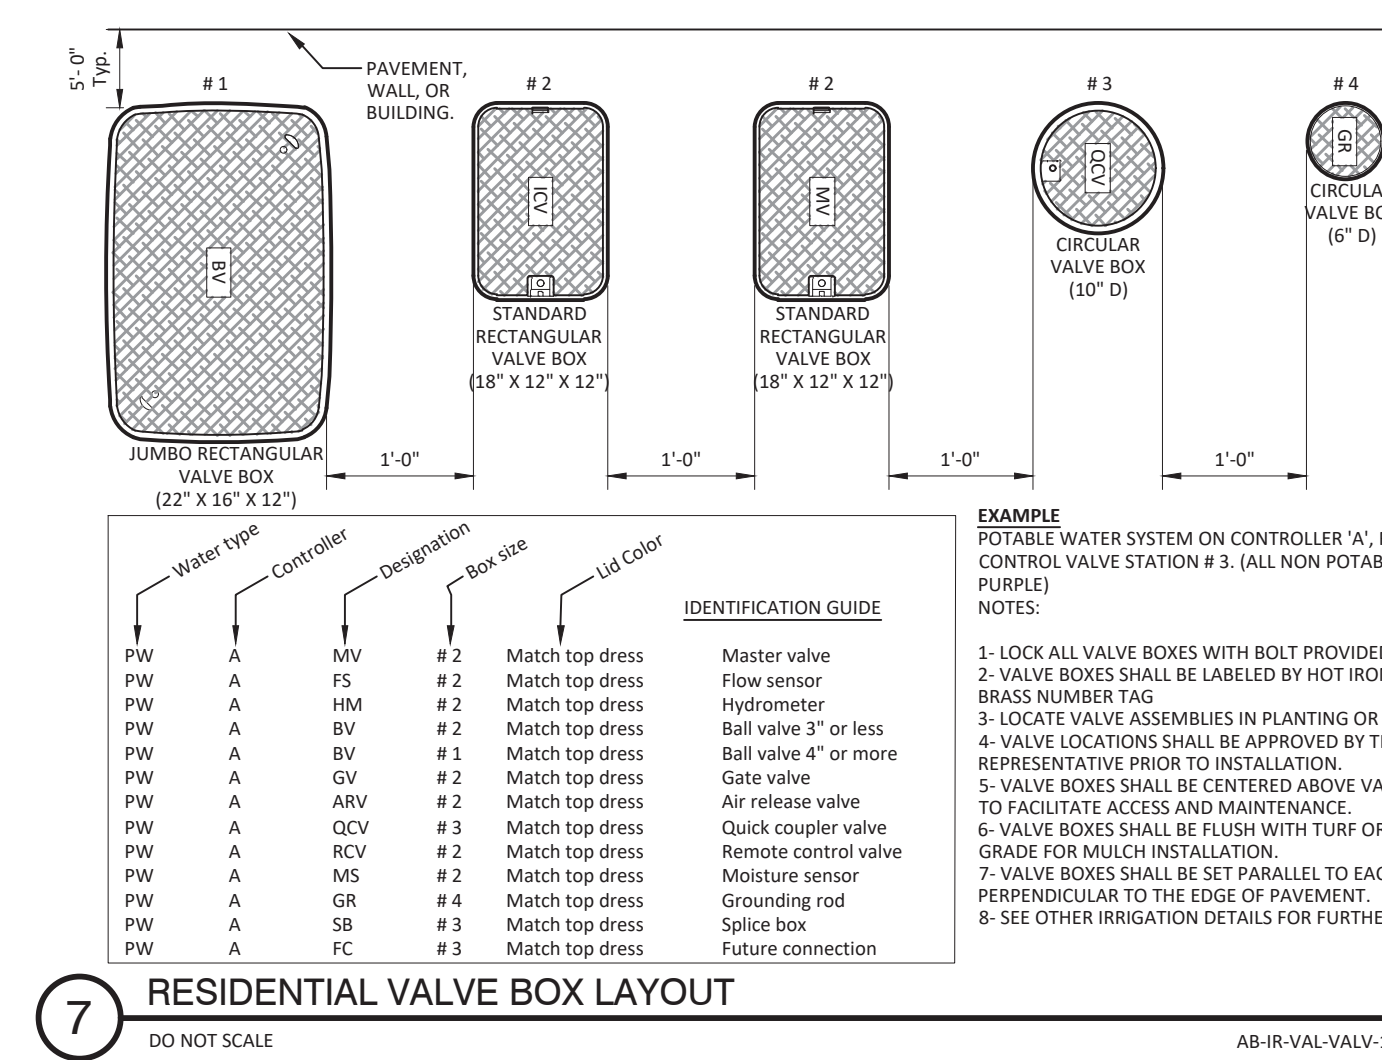


**7 RESIDENTIAL VALVE BOX LAYOUT**  
 DO NOT SCALE  
 AB-IR-VALV-10

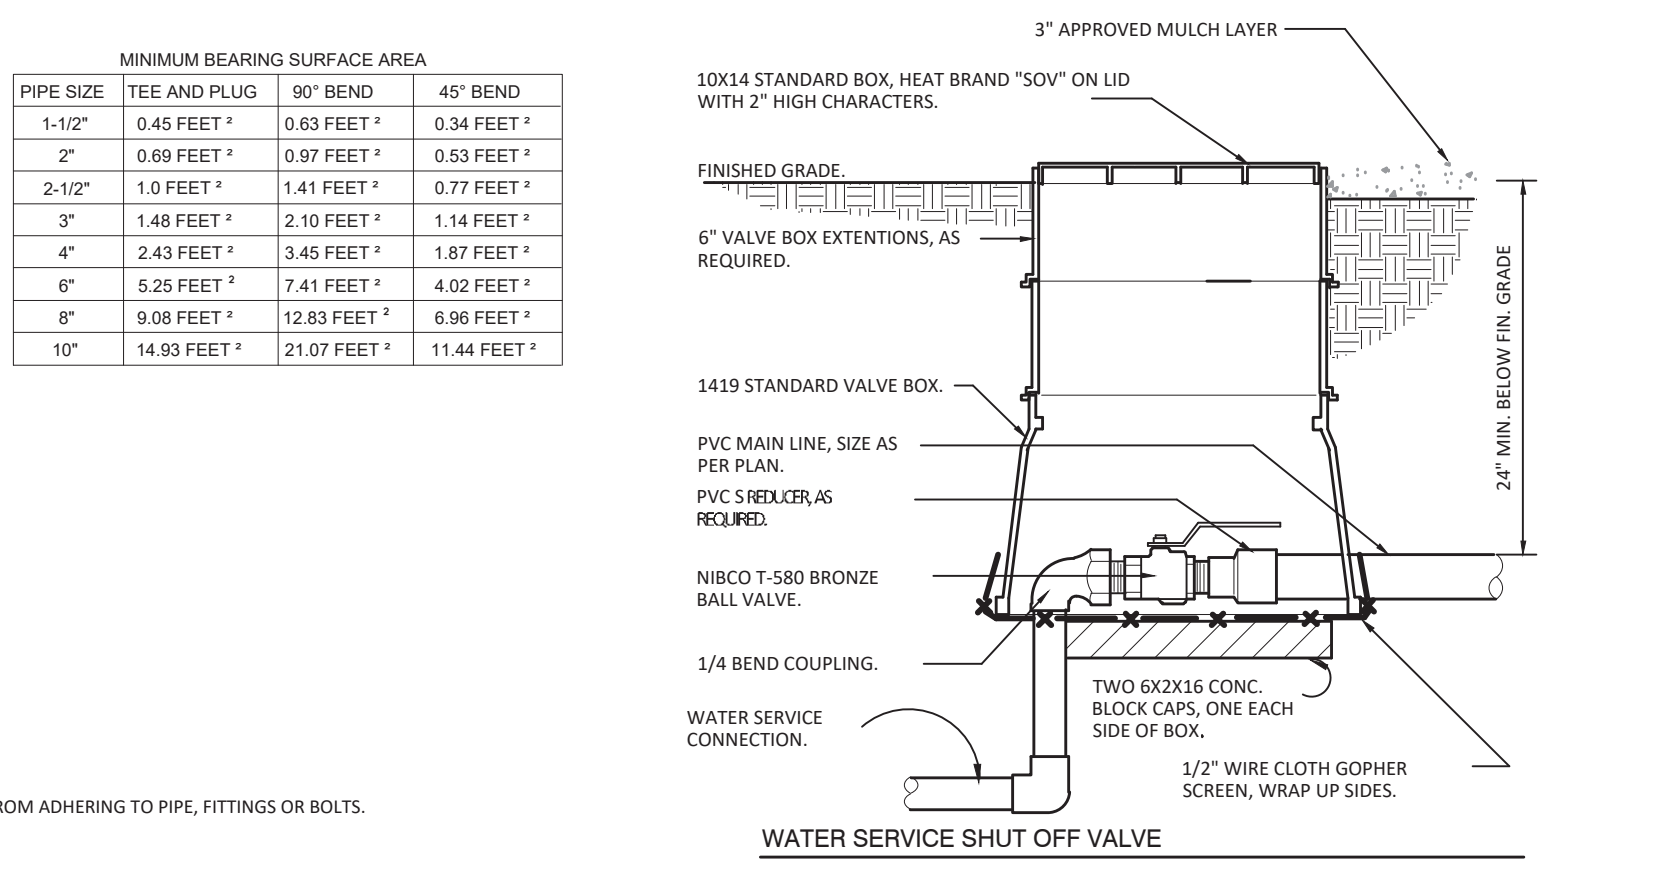

**2 WATER SERVICE CONNECTION**  
 NTS  
 AB-IR-POC-10

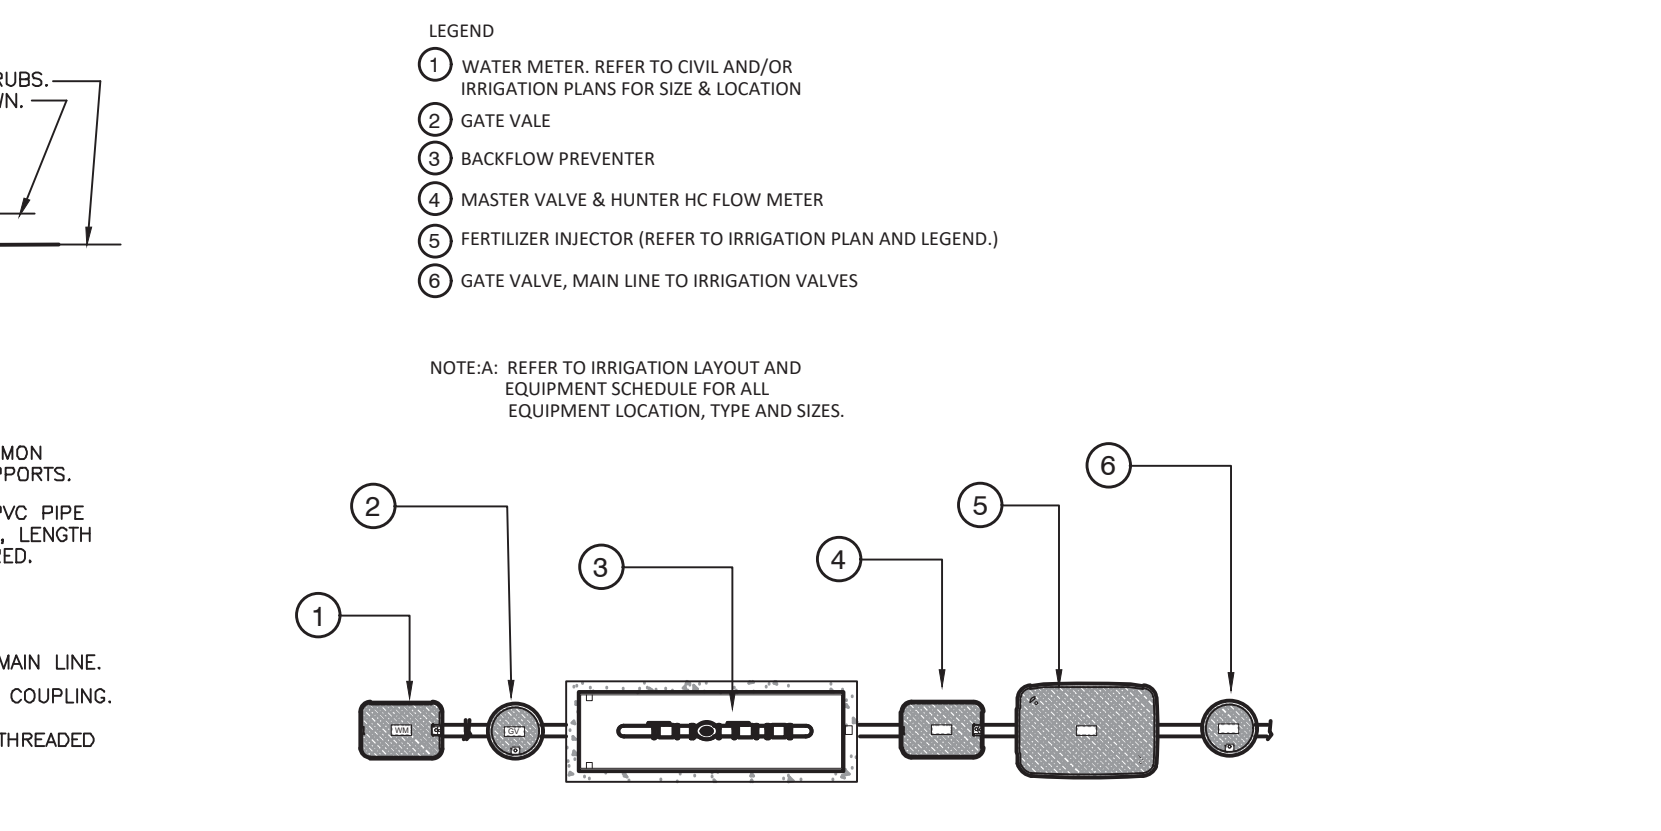


**5 POC & IRRIGATION EQUIPMENT LAYOUT**  
 NTS

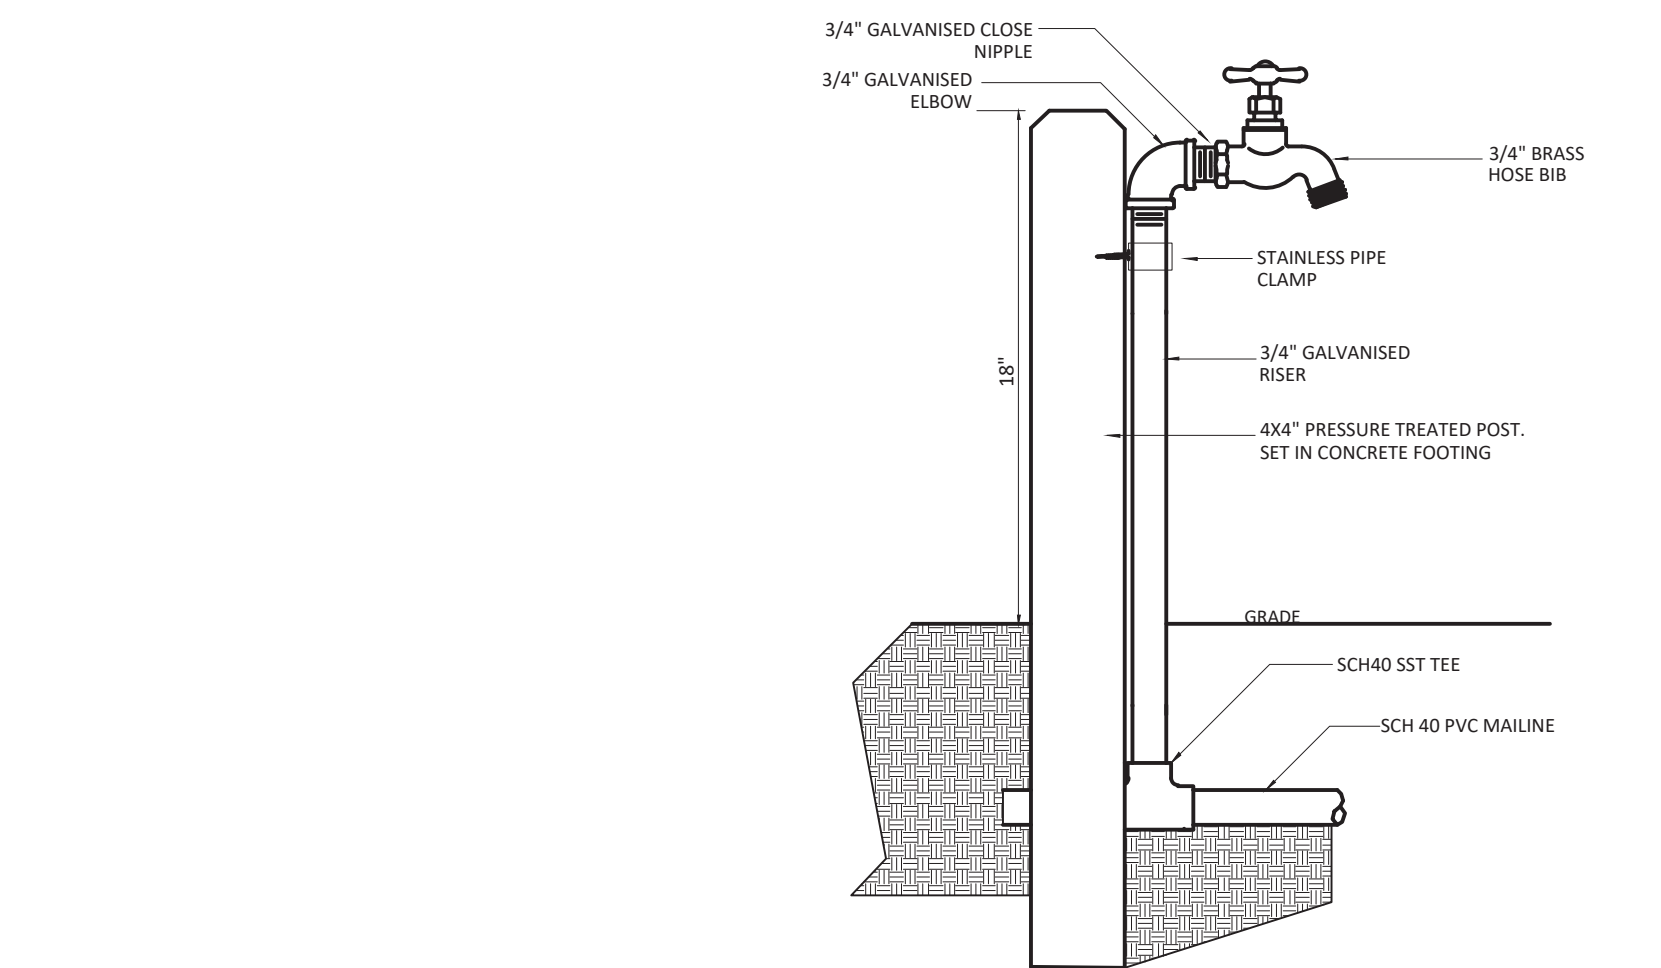

**8 HOSE BIB INSTALLATION POST**  
 NTS

PIPE SIZE	MINIMUM BEARING SURFACE AREA		
	TEE AND PLUG	90° BEND	45° BEND
1-1/2"	0.45 FEET <sup>2</sup>	0.63 FEET <sup>2</sup>	0.34 FEET <sup>2</sup>
2"	0.69 FEET <sup>2</sup>	0.97 FEET <sup>2</sup>	0.53 FEET <sup>2</sup>
2-1/2"	1.0 FEET <sup>2</sup>	1.41 FEET <sup>2</sup>	0.77 FEET <sup>2</sup>
3"	1.48 FEET <sup>2</sup>	2.10 FEET <sup>2</sup>	1.14 FEET <sup>2</sup>
4"	2.43 FEET <sup>2</sup>	3.45 FEET <sup>2</sup>	1.87 FEET <sup>2</sup>
6"	5.25 FEET <sup>2</sup>	7.41 FEET <sup>2</sup>	4.02 FEET <sup>2</sup>
8"	9.08 FEET <sup>2</sup>	13.83 FEET <sup>2</sup>	8.06 FEET <sup>2</sup>
10"	14.93 FEET <sup>2</sup>	21.07 FEET <sup>2</sup>	11.44 FEET <sup>2</sup>

**3 THRUST BLOCK (2)**  
 NTS

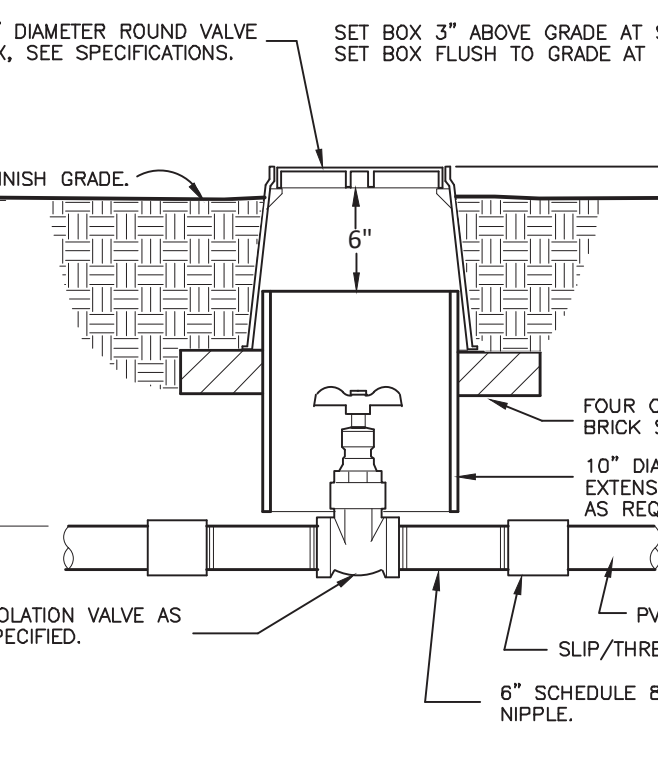

**6 BRASS ISOLATION VALVE**  
 1 1/2" = 1'-0"  
 AB-IR-VAL-ISOL-02



**8 HOSE BIB INSTALLATION POST**  
 NTS











"I HAVE COMPLIED WITH THE LANDSCAPE DESIGN CRITERIA OF THE MODEL WATER EFFICIENT LANDSCAPE ORDINANCE AND APPLIED THEM ACCORDINGLY FOR THE EFFICIENT USE OF WATER IN THIS DESIGN."  
 DATED: 6/15/2020  
 BY: Andrew Bolt



THESE PLANS ARE THE PROPERTY OF 4B INCORPORATED AND CANNOT BE COPIED WITHOUT PERMISSION



IRRIGATION DETAILS

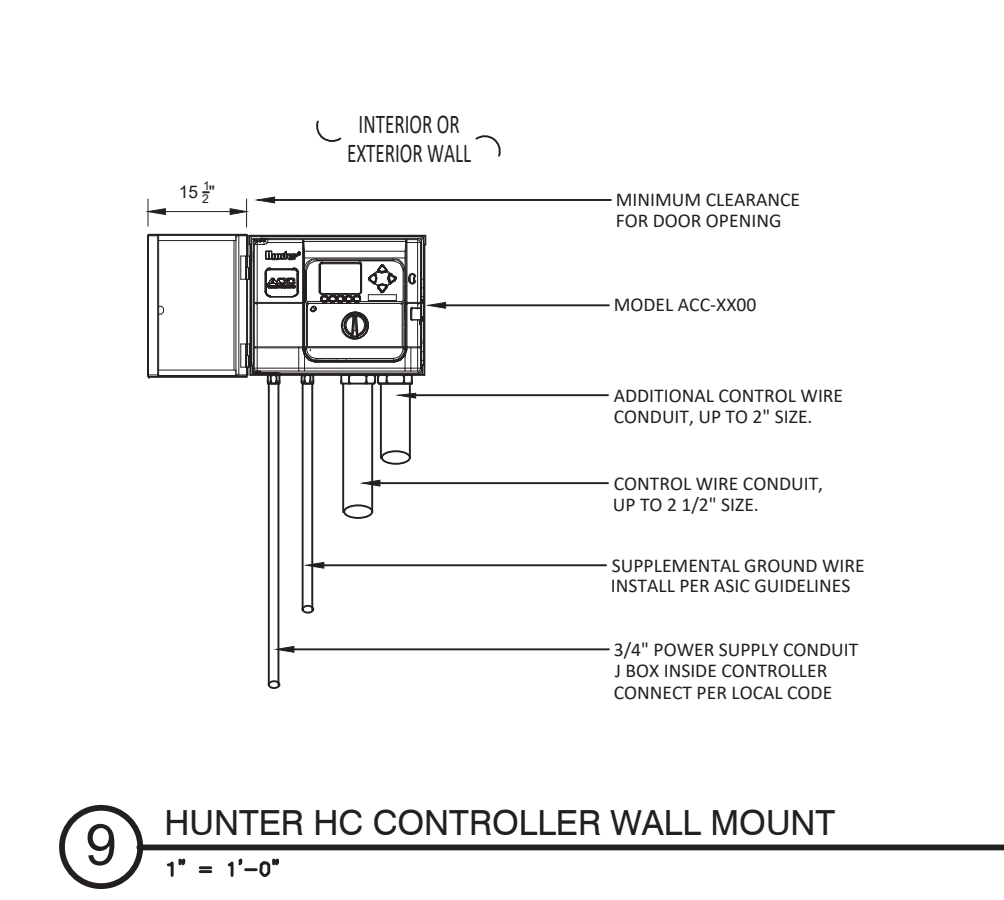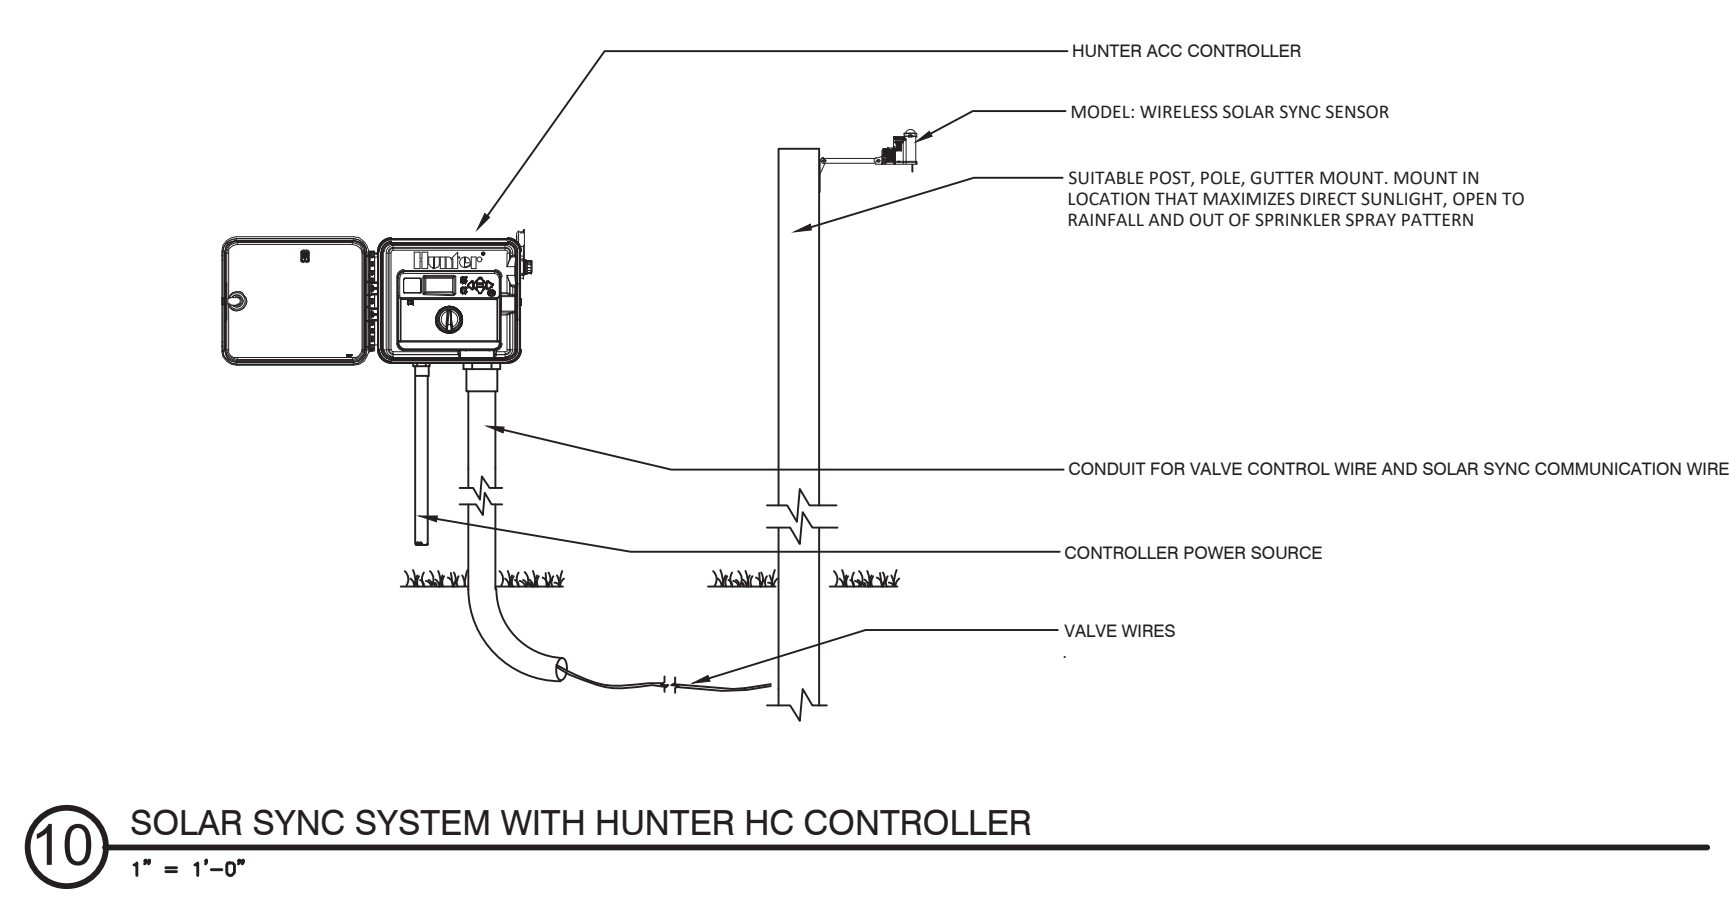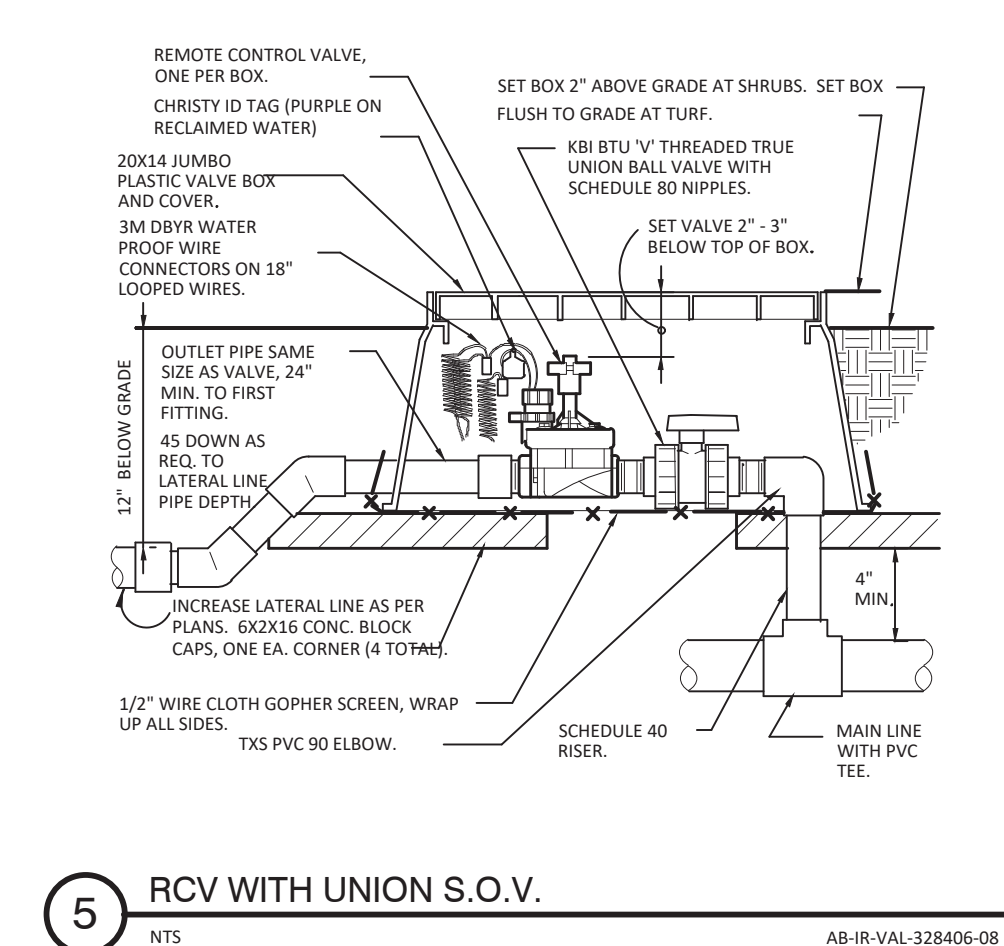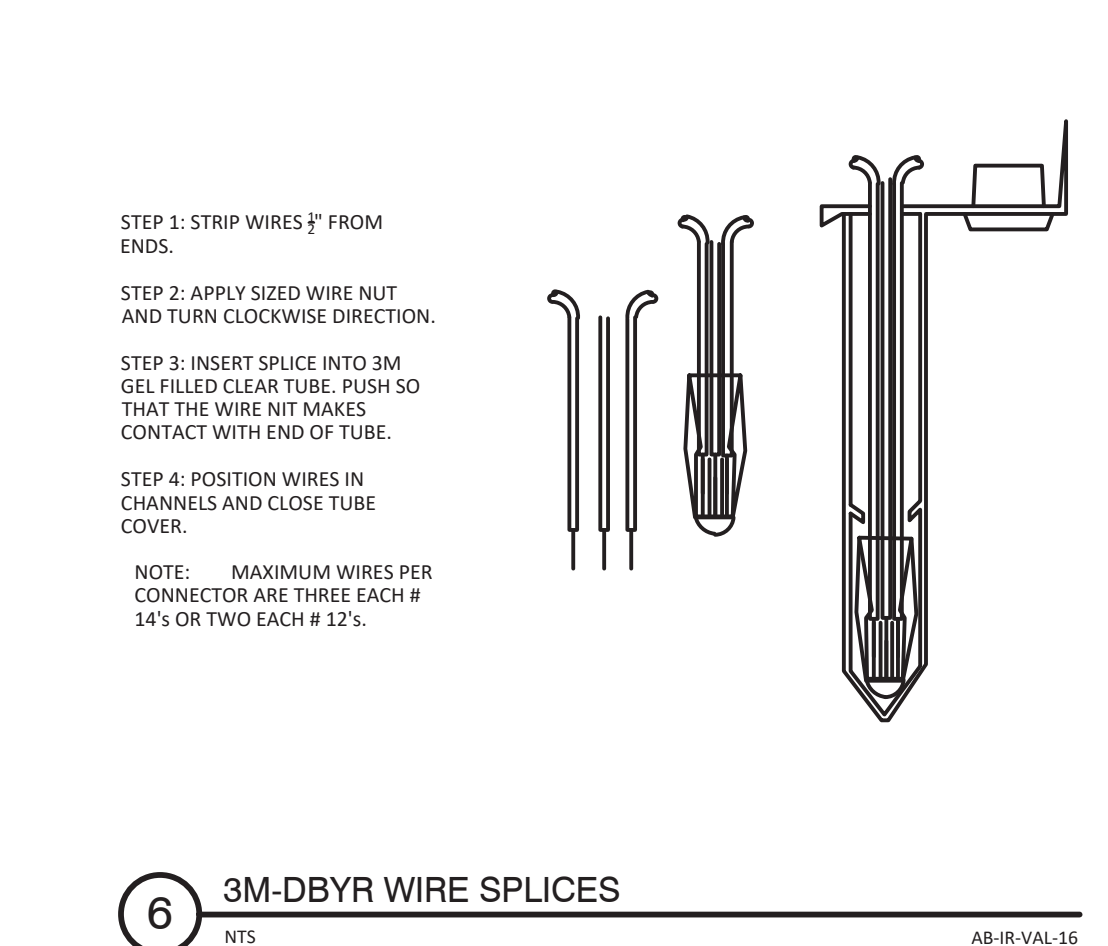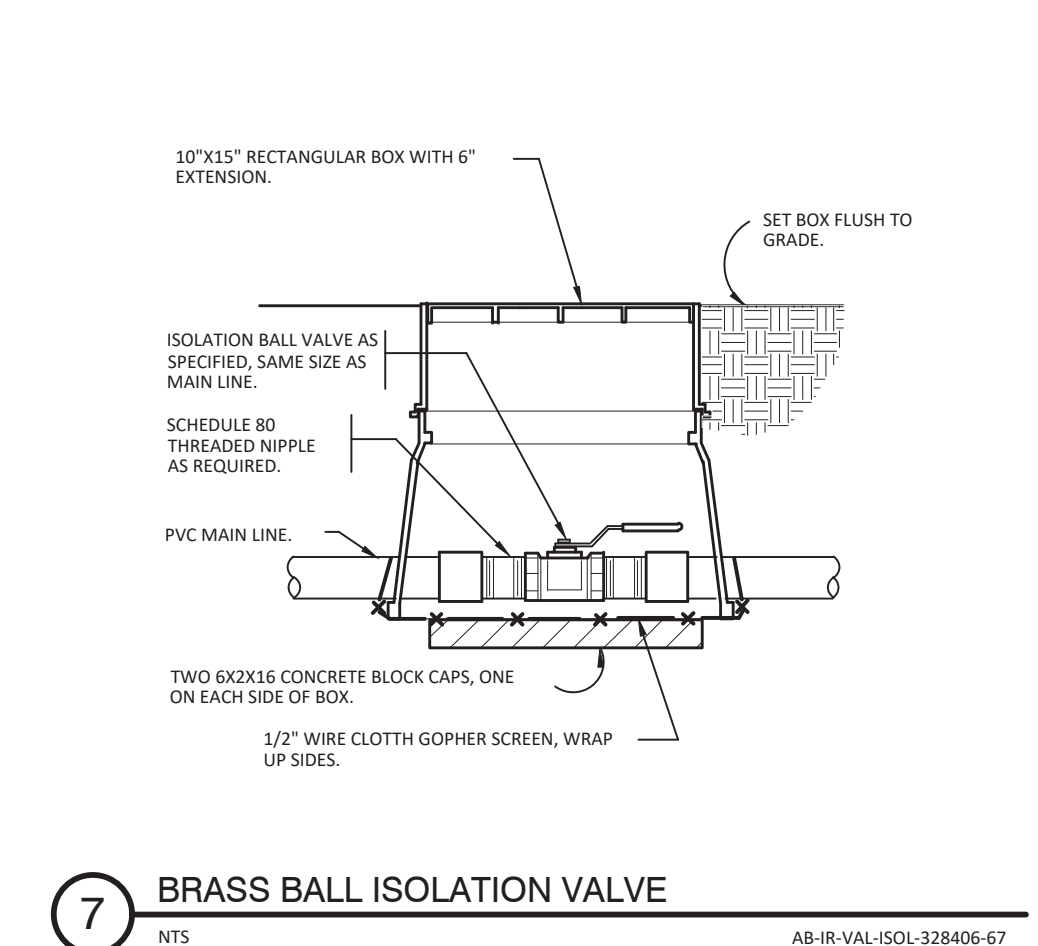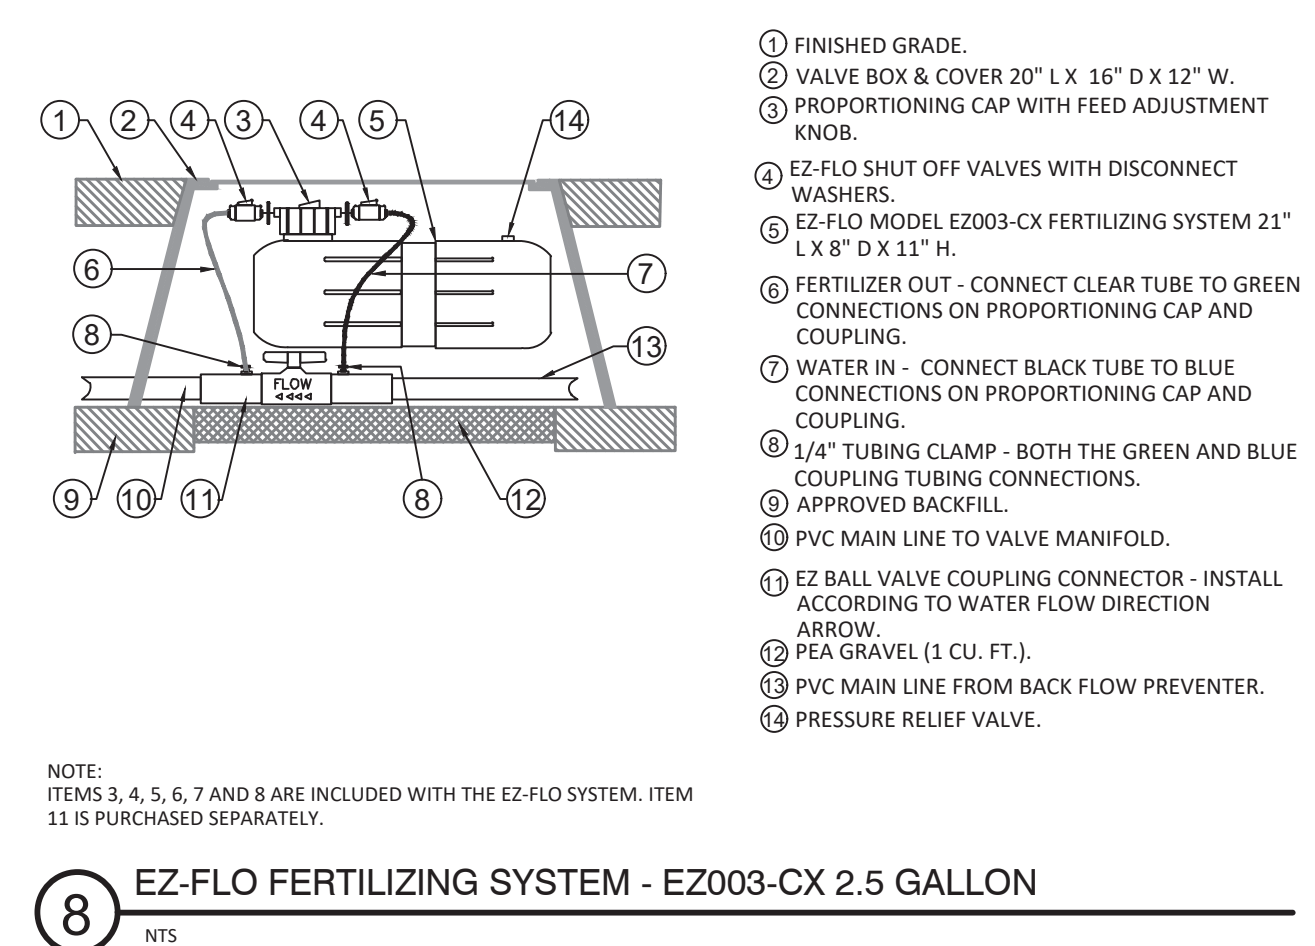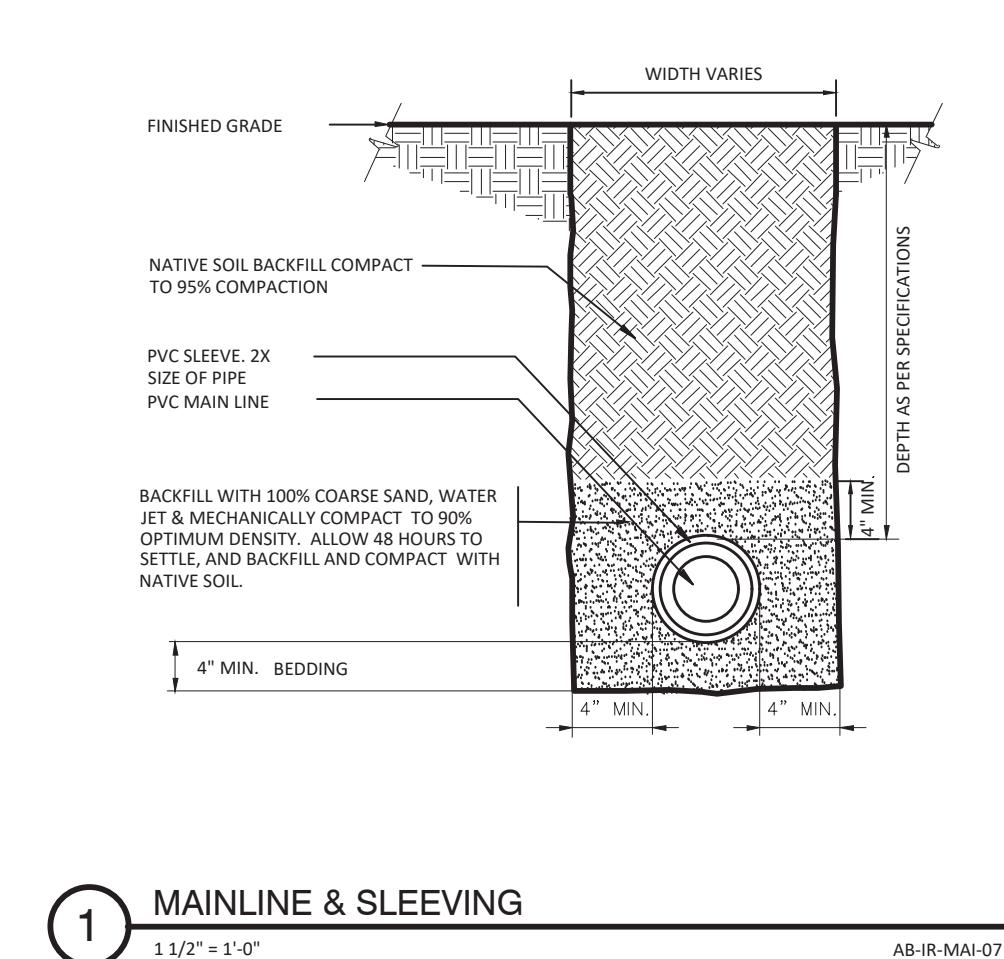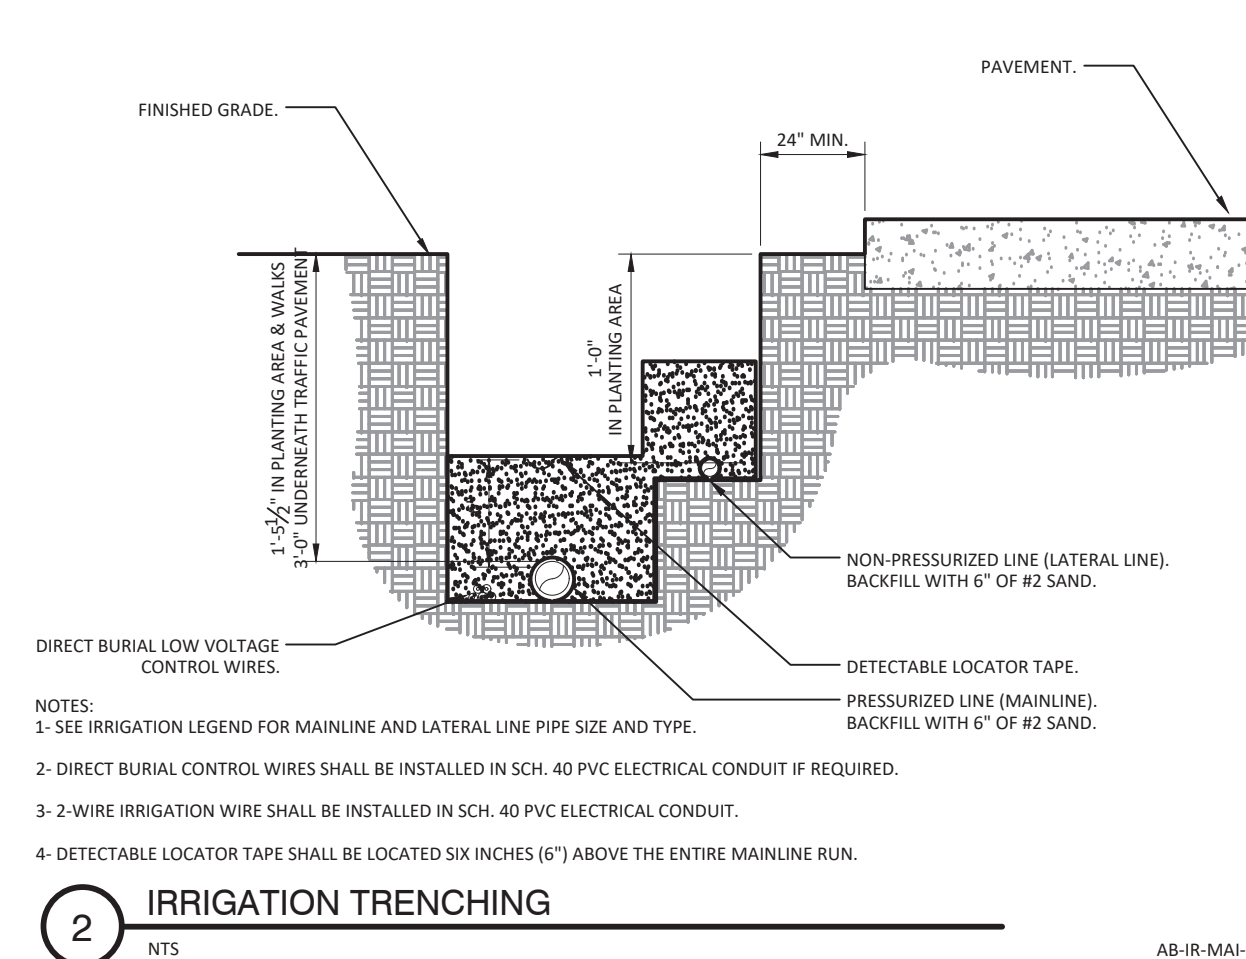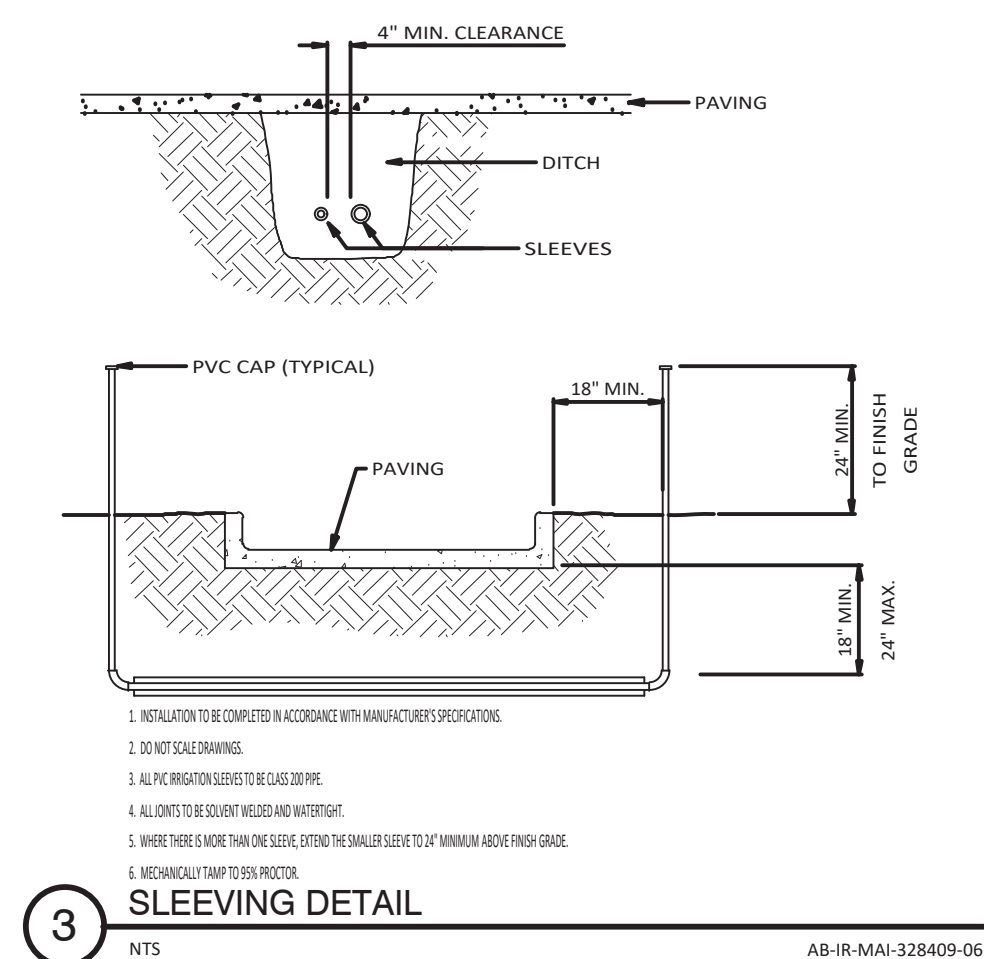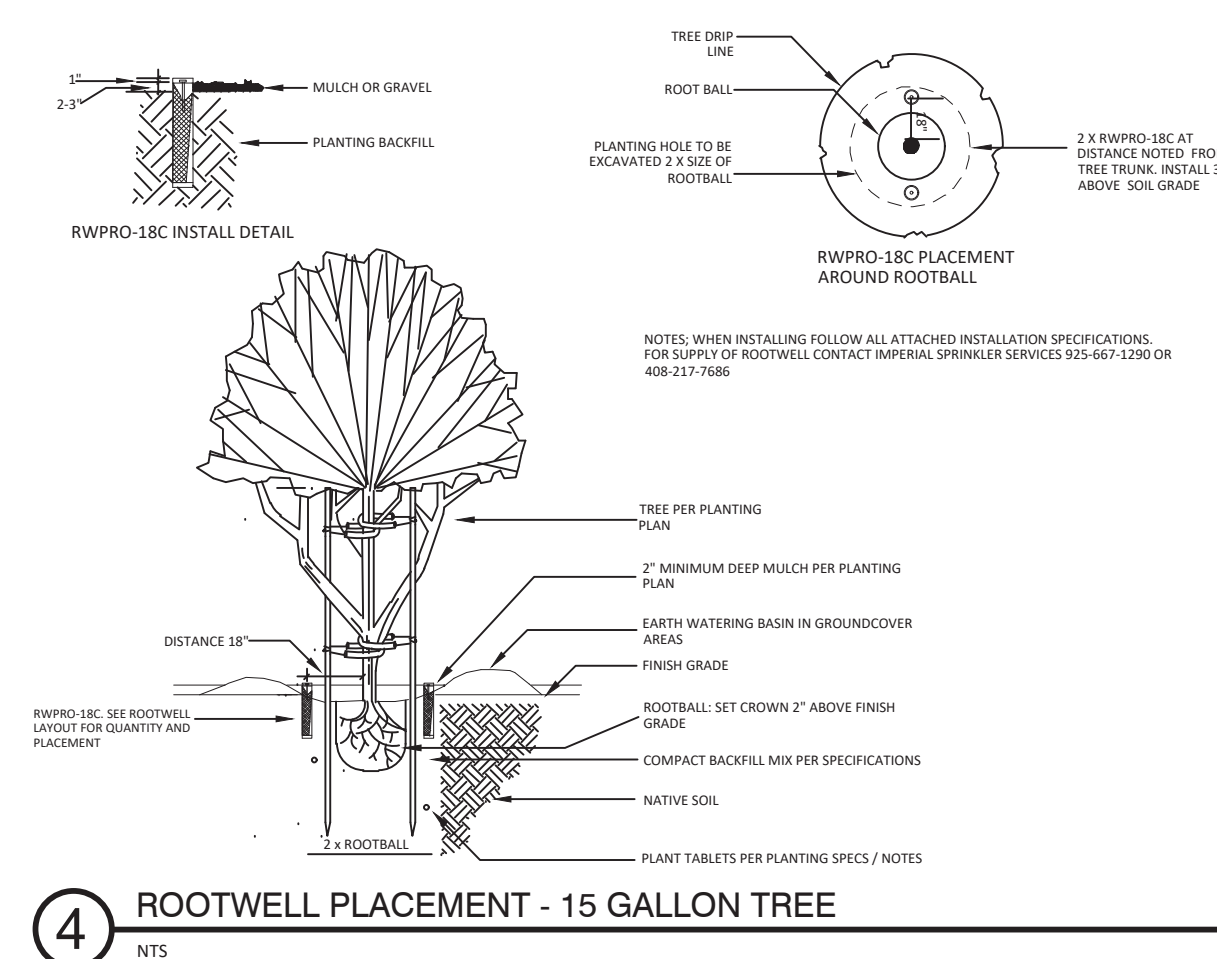

No.	Revision/Issue	Date

Firm Name and Address

**4Binc**  
Select Certified  
IRRIGATION ASSOCIATION  
LIC # 8022780    ILC ENT # 57586

**ASIC**  
COMMERCIAL MEMBER

Project Name and Address


**COLUMBUS ST.  
EL GRANADA, CA**

Project 236-2019	Drawn By 4Binc.
Date 9/10/19	Checked By 4Binc.
Scale	Approved By
	Sheet
<b>IR-2.1</b>	


"I HAVE COMPLIED WITH THE LANDSCAPE DESIGN CRITERIA OF THE MODEL WATER EFFICIENT LANDSCAPE ORDINANCE AND APPLIED THEM ACCORDINGLY FOR THE EFFICIENT USE OF WATER IN THIS DESIGN."  
DATED: 6/15/2020  
BY: Andrew Bolt




THESE PLANS ARE THE PROPERTY OF 4B INCORPORATED AND CAN NOT BE COPIED WITHOUT PERMISSION.

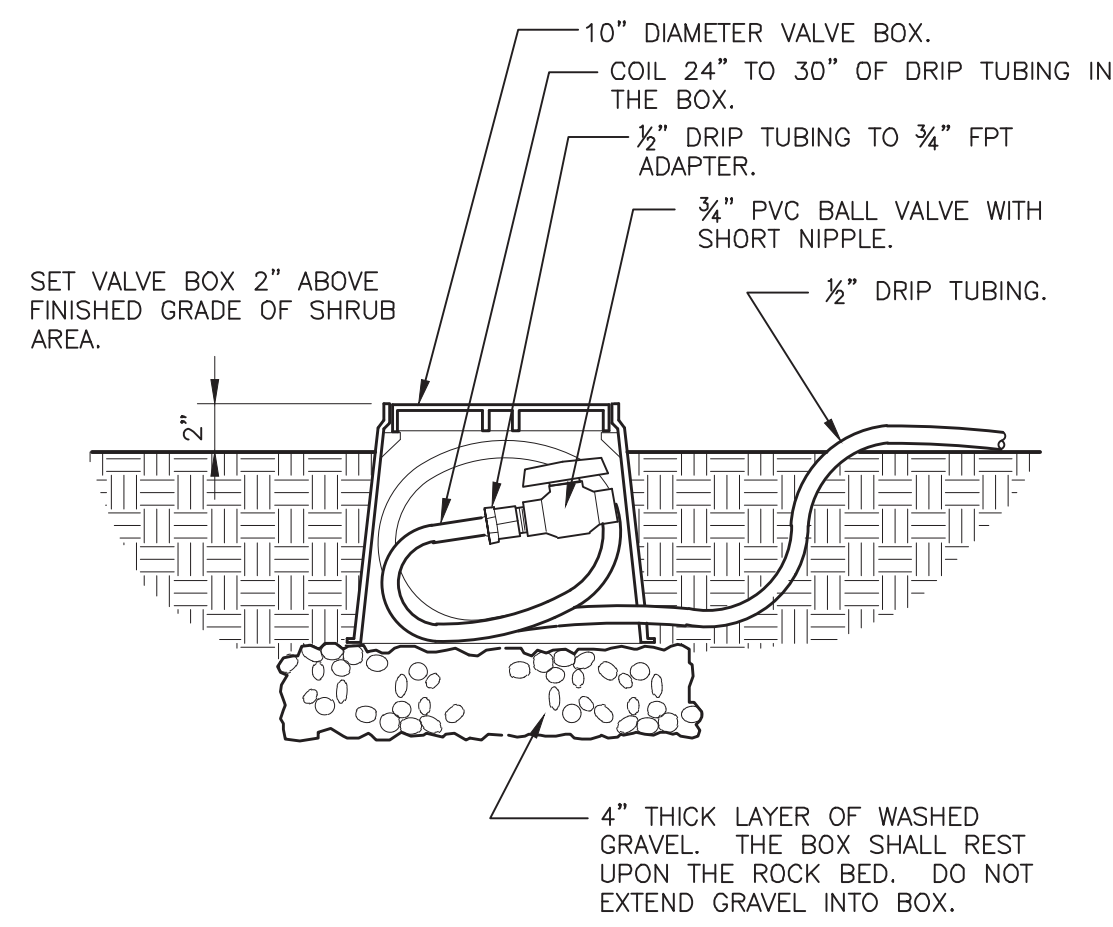


**3** DRIP FLUSH VALVE  
1 1/2" = 1'-0"

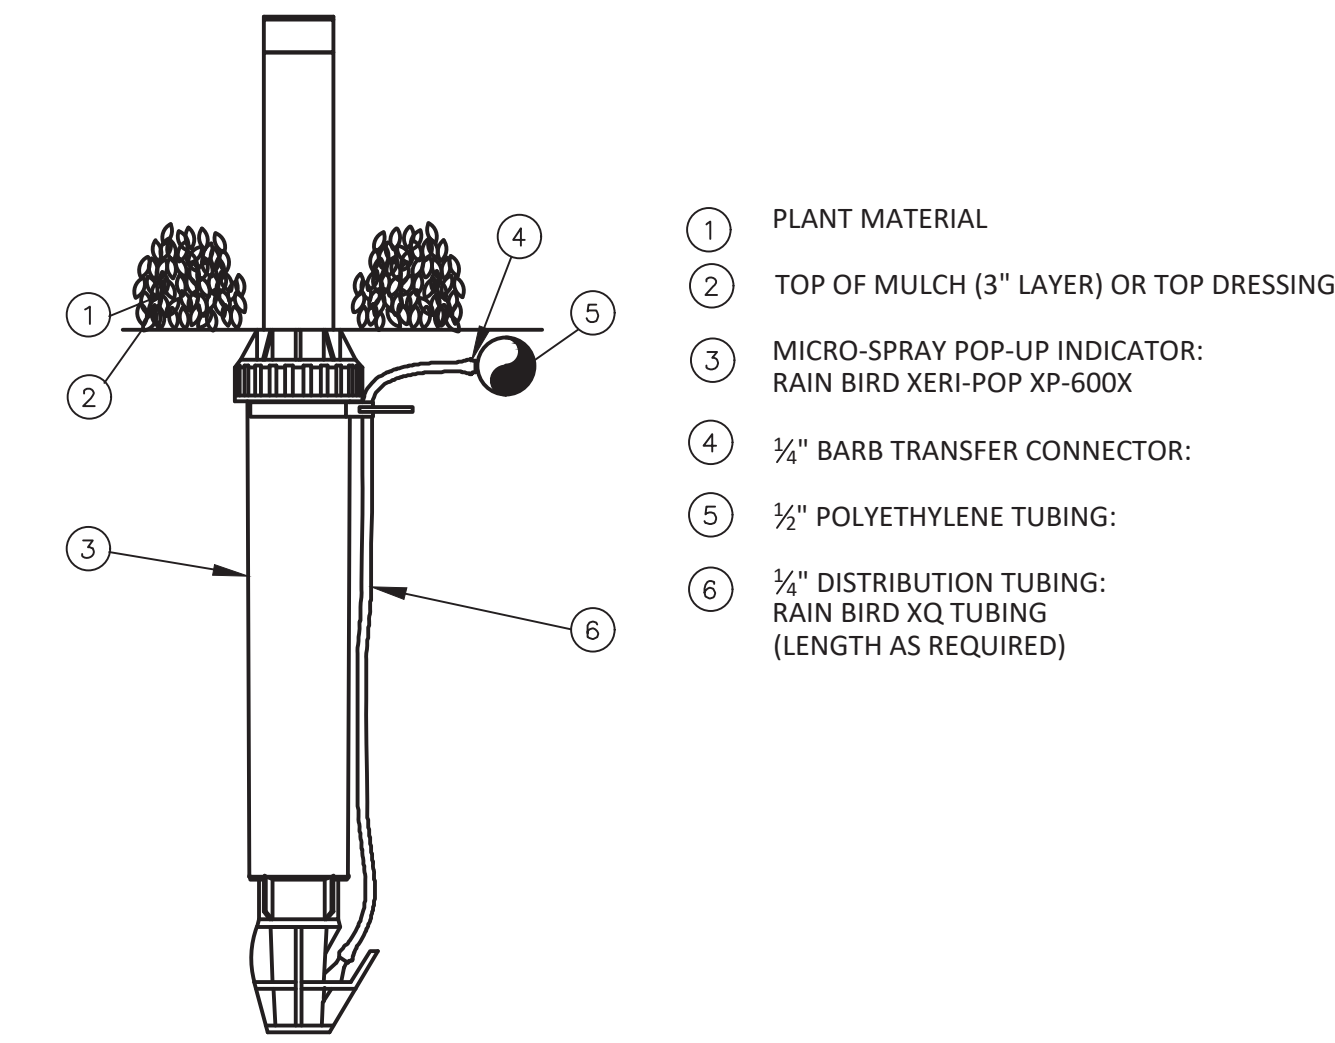


**2** 6" POP UP DRIP INDICATOR  
RAIN BIRD OPERATION INDICATOR NTS  
AB-IR-DRI-03

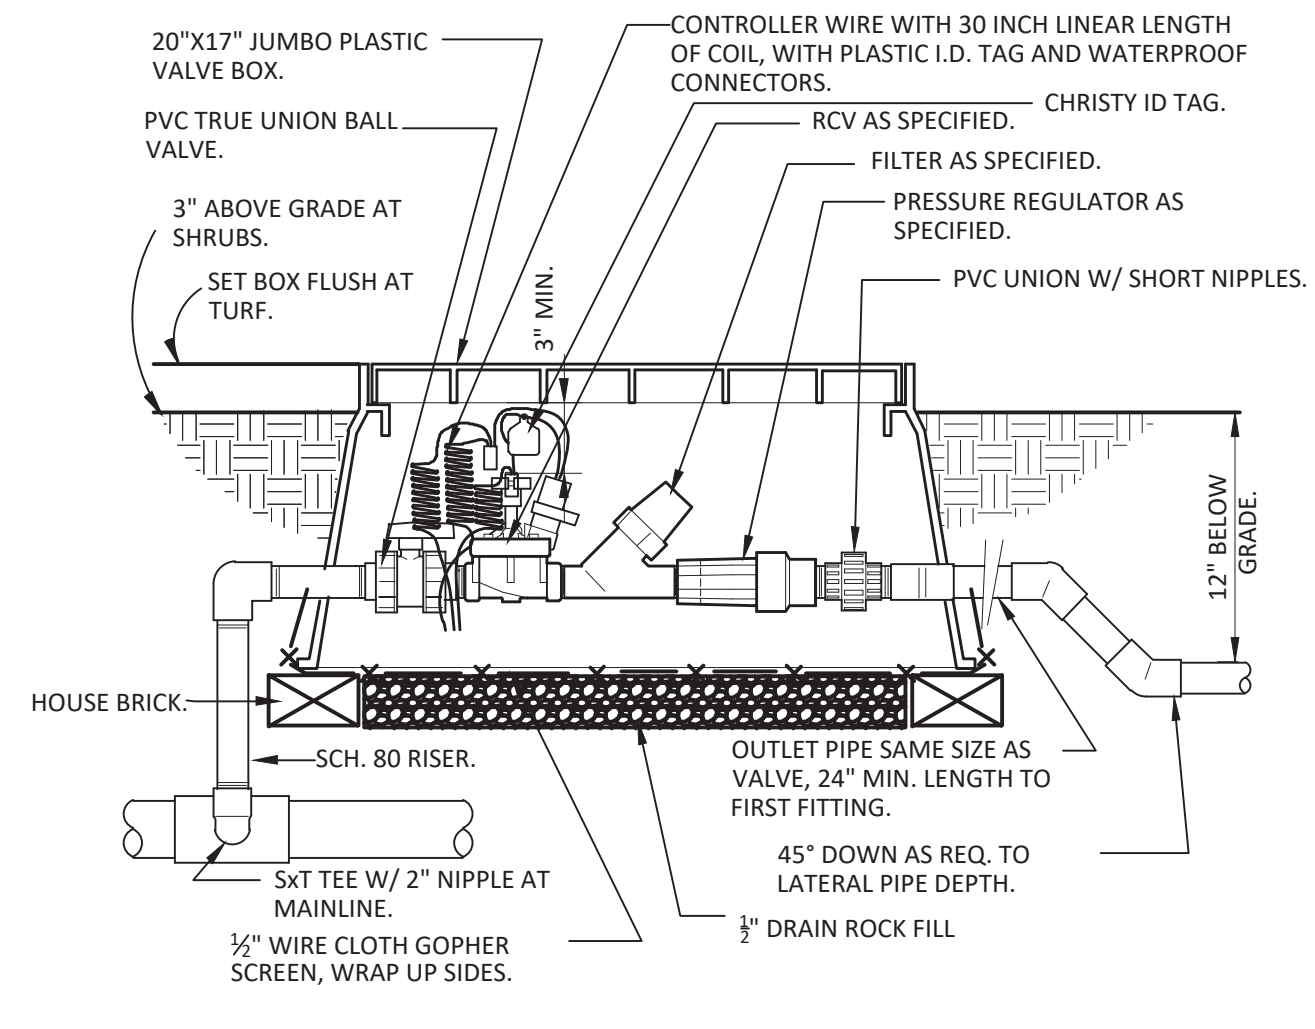


**1** 1" DRIP VALVE/FILTER/REGULATOR  
1 1/2" = 1'-0"  
AB-IR-DRI-VALV-328413-02

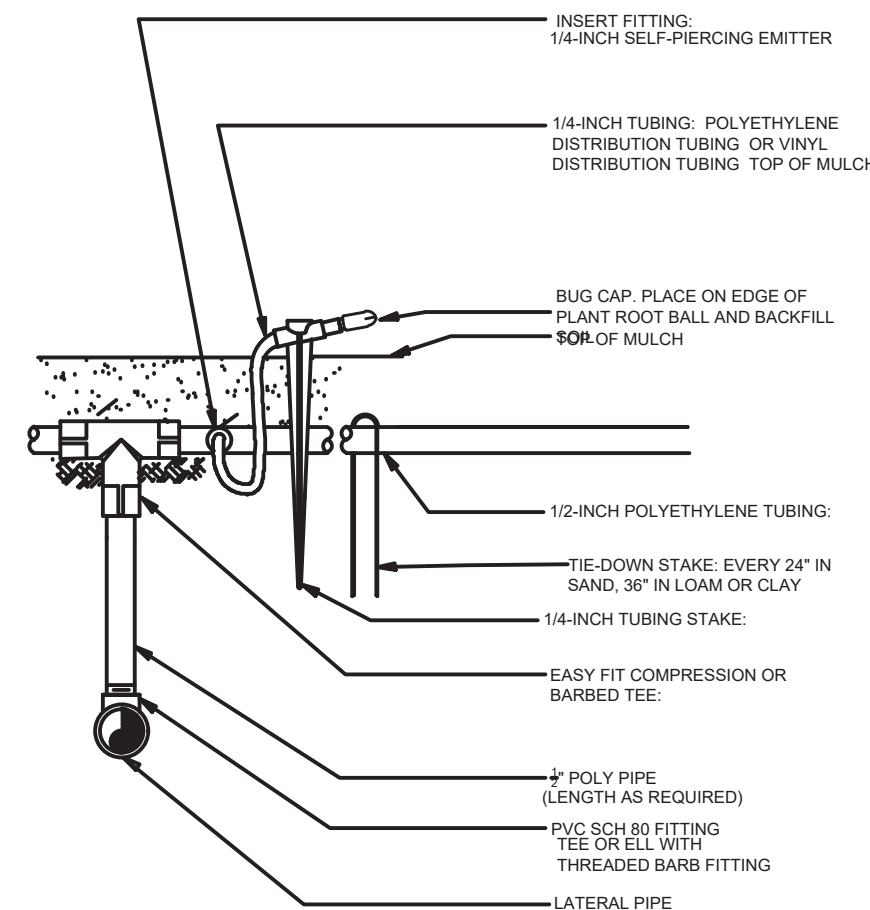


**6** PVC TO DRIP EMITTER 1/2" POLY TUBING  
6" = 1'-0"  
AB-IR-DRI-23

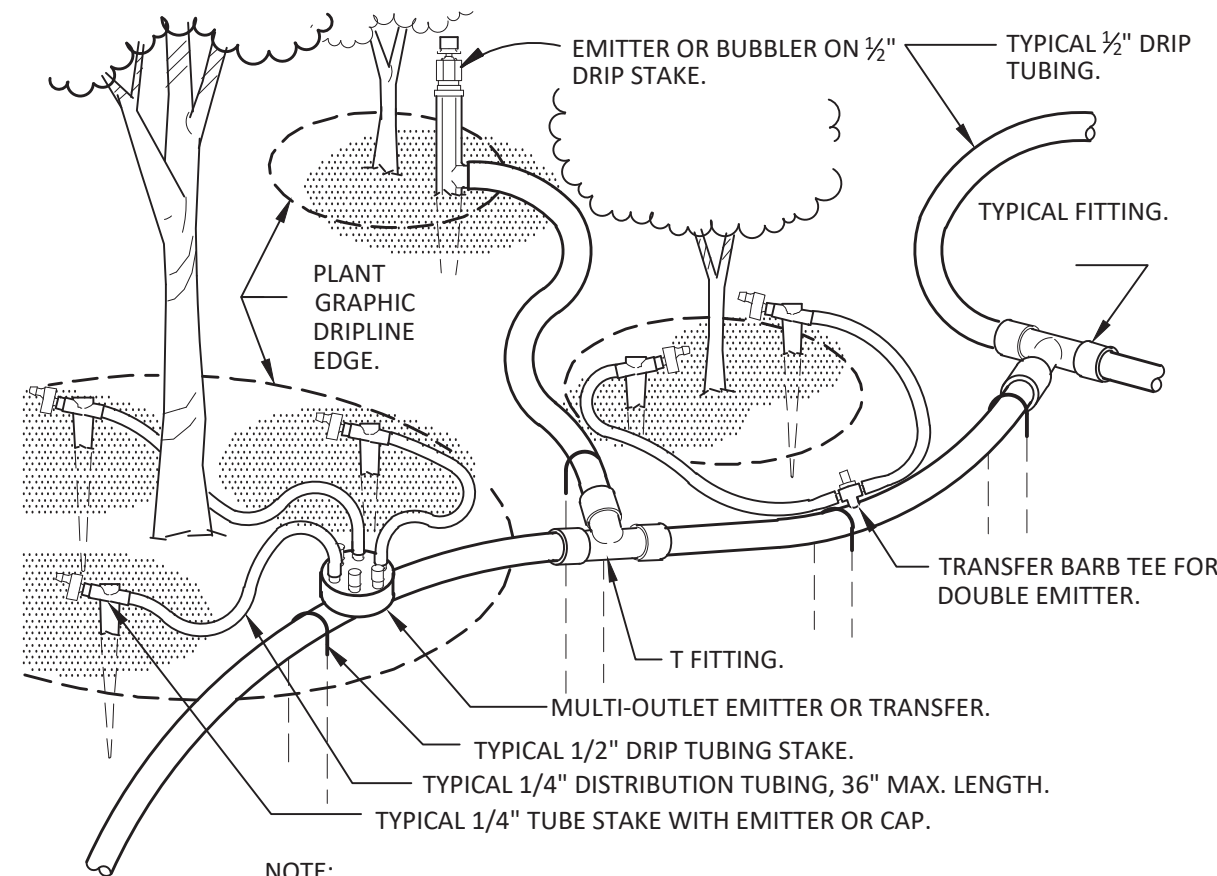


**5** TYPICAL DRIP TUBING  
NTS  
AB-IR-DRI-24

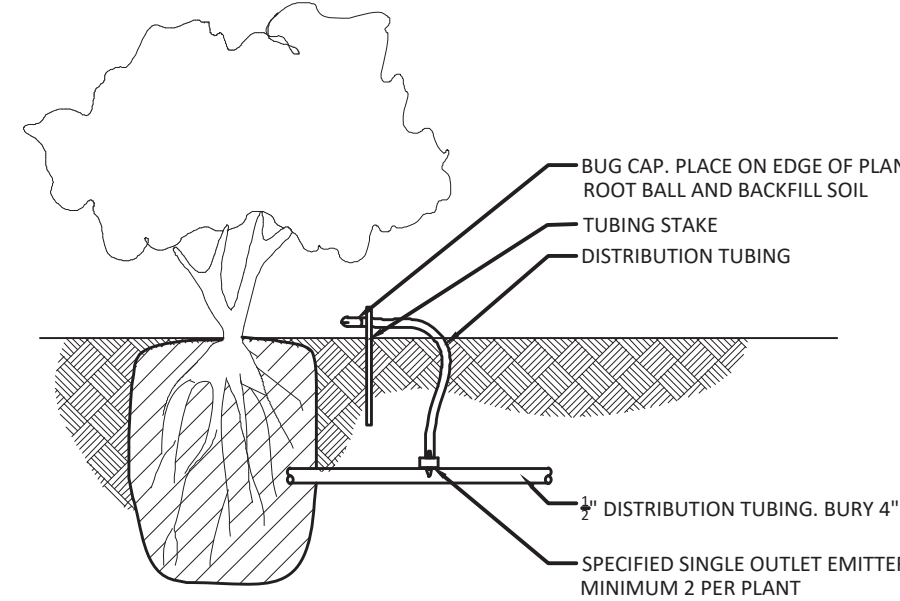


**4** DRIP EMITTER DETAIL  
NTS  
AB-IR-DRI-14

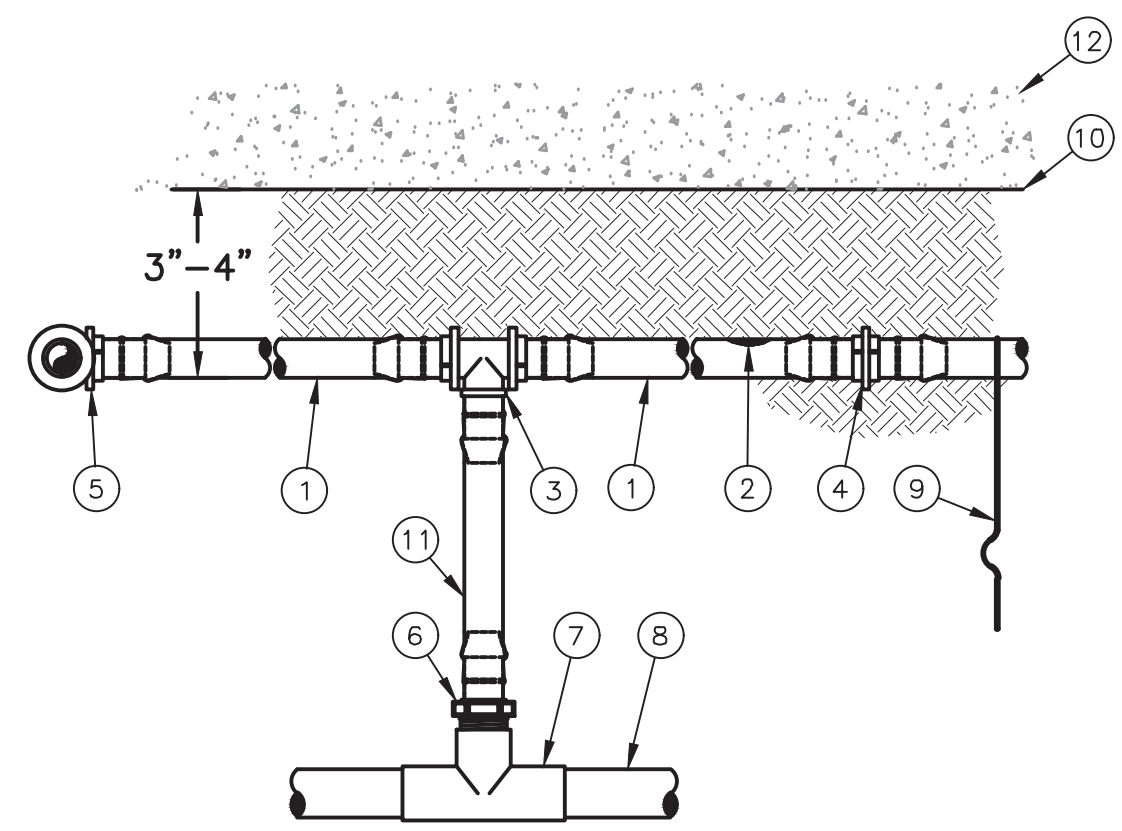

**9** PVC SUPPLY LINE TO DRIP LINE TRANSITION DETAIL  
NTS  
AB-IR-DRI-13

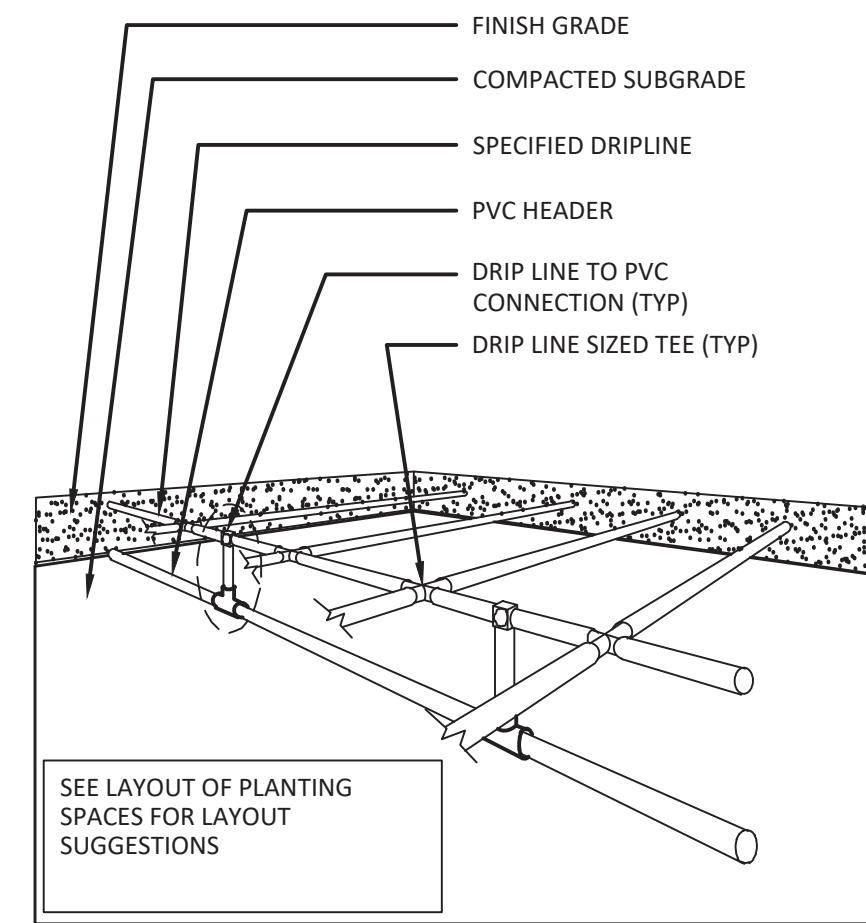

**8** SUB SURFACE HEADER INSTALLATION  
NTS  
AB-IR-DRI-INLI-11

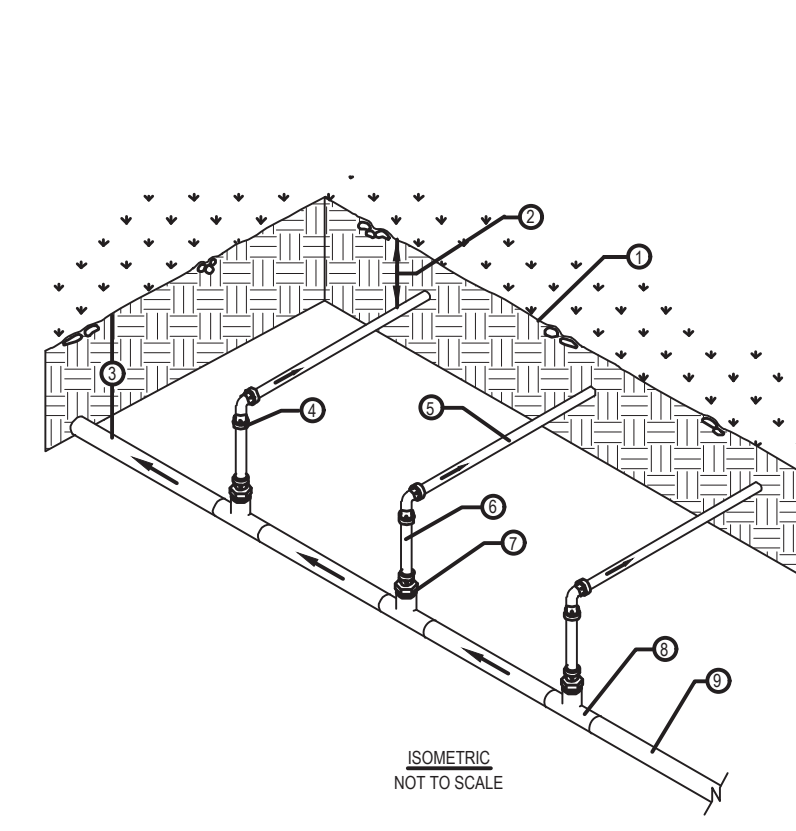

**7** DRIP END FEED HEADER  
ISOMETRIC NOT TO SCALE  
NTS  
AB-IR-DRI-INLI-06

- FINISH GRADE.
- DEPTH OF TUBING PER SPECIFICATIONS
- DEPTH OF PVC SUPPLY MANIFOLD PER - 12"
- TORO LOC-EZE TEE.
- DRIPLINE LATERAL
- POLY TUBING, LENGTH AS NECESSARY.
- TORO LOC-EZE X 1/2" MTP ADAPTER (FAM16).
- PVC TEE (SxSxT) WITH 1/2" FPT OUTLET.
- PVC SUPPLY MANIFOLD FROM DRIP ZONE KIT.

"I HAVE COMPLIED WITH THE LANDSCAPE DESIGN CRITERIA OF THE MODEL WATER EFFICIENT LANDSCAPE ORDINANCE AND APPLIED THEM ACCORDINGLY FOR THE EFFICIENT USE OF WATER IN THIS DESIGN."  
DATED: 6/15/2020  
BY: Andrew Bolt



General Notes

**DRIP DETAILS**

**4Binc** Select Certified  
ASIC  
COMMERCIAL MEMBER

Project Name and Address  
COLUMBUS ST.  
EL GRANADA, CA

No.	Revision/Issue	Date


Project  
236-2019  
Date  
9/10/19  
Scale

Drawn By  
4Binc.  
Checked By  
4Binc.  
Approved By

Sheet  
IR-3.0

THESE PLANS ARE THE PROPERTY OF 4B INCORPORATED AND CAN NOT BE COPIED WITHOUT PERMISSION



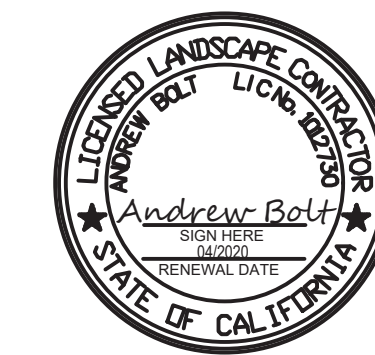

No.	Revision/Issue	Date

Firm Name and Address

**4Binc**  
Select Certified  
IRRIGATION DESIGNER

**ASIC**  
COMMERCIAL MEMBER

UCP # 1012750 | IA CERT # 51493


Project Name and Address

**COLUMBUS ST.  
EL GRANADA, CA**

Project	Drawn By
236-2019	4Binc.
Date	Checked By
9/10/19	4Binc.
Scale	Approved By




- ① PVC SUPPLY HEADER
- ② PVC SCH 40 TEE OR EL (TYPICAL)
- ③ BARB X MALE FITTING:
- ④ PVC DRIP MANIFOLD FROM CONTROL ZONE VALVE KIT (SIZED TO MEET LATERAL FLOW DEMAND)
- ⑤ SUB-SURFACE DRIPLINE: SEE IRRIGATION LEGEND FOR SPECIFICATIONS
- ⑥ PERIMETER OF AREA
- ⑦ PERIMETER DRIPLINE PIPE TO BE INSTALLED 2"-4" FROM PERIMETER OF AREA
- ⑧ FLUSH POINT (TYPICAL) - SEE DETAILS FOR FLUSH POINT INSTALLATION
- ⑨ BARB X BARB INSERT TEE OR ELBOW:
- ⑩ PVC RISER PIPE
- ⑪ PVC SUPPLY MANIFOLD
- ⑫ PVC SCH 40 SLEEVE PIPE SIZED TWICE THE SIZE OF MANIFOLD PIPE SIZE
- ⑬ PAVEMENT AND CURB
- ⑭ TURF OR MULCH
- ⑮ FINISH GRADE
- ⑯ 1/2" AIR RELIEF VALVE:

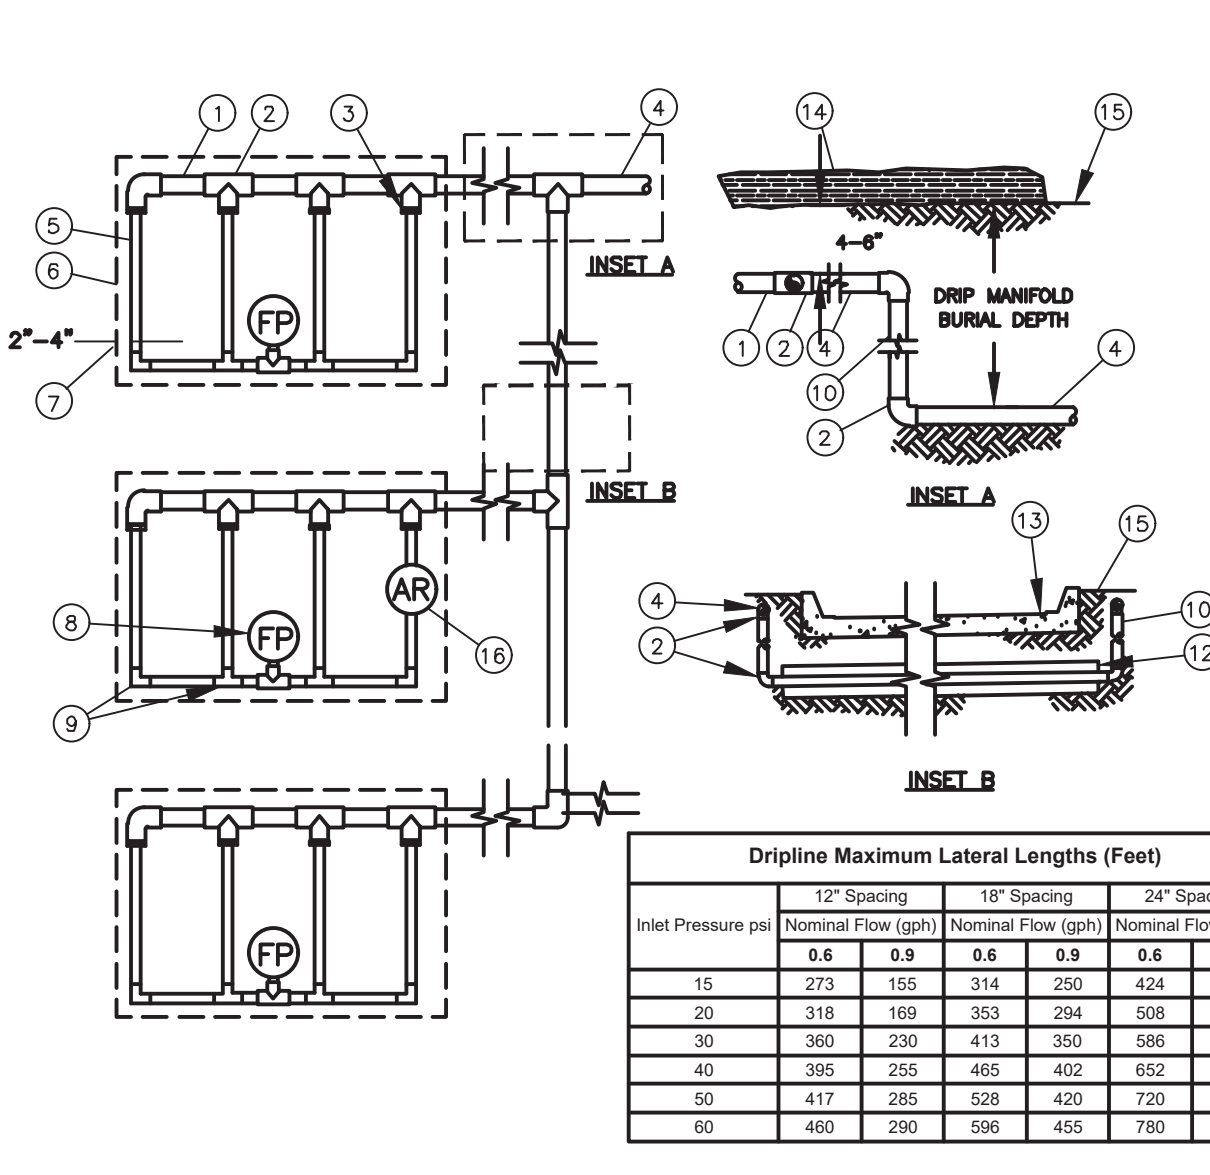

**1 DRIP IRRIGATION IN PLANTER LAYOUT**  
NTS AB-IR-DRI-DRIP-08


Inlet Pressure psi	12" Spacing		18" Spacing		24" Spacing	
	Nominal Flow (gph)	Nominal Flow (gph)	Nominal Flow (gph)	Nominal Flow (gph)	Nominal Flow (gph)	Nominal Flow (gph)
15	273	155	314	290	424	322
20	318	189	353	294	508	368
30	380	230	413	350	586	414
40	395	235	465	402	652	474
50	417	285	526	420	720	498
60	460	290	596	455	780	514

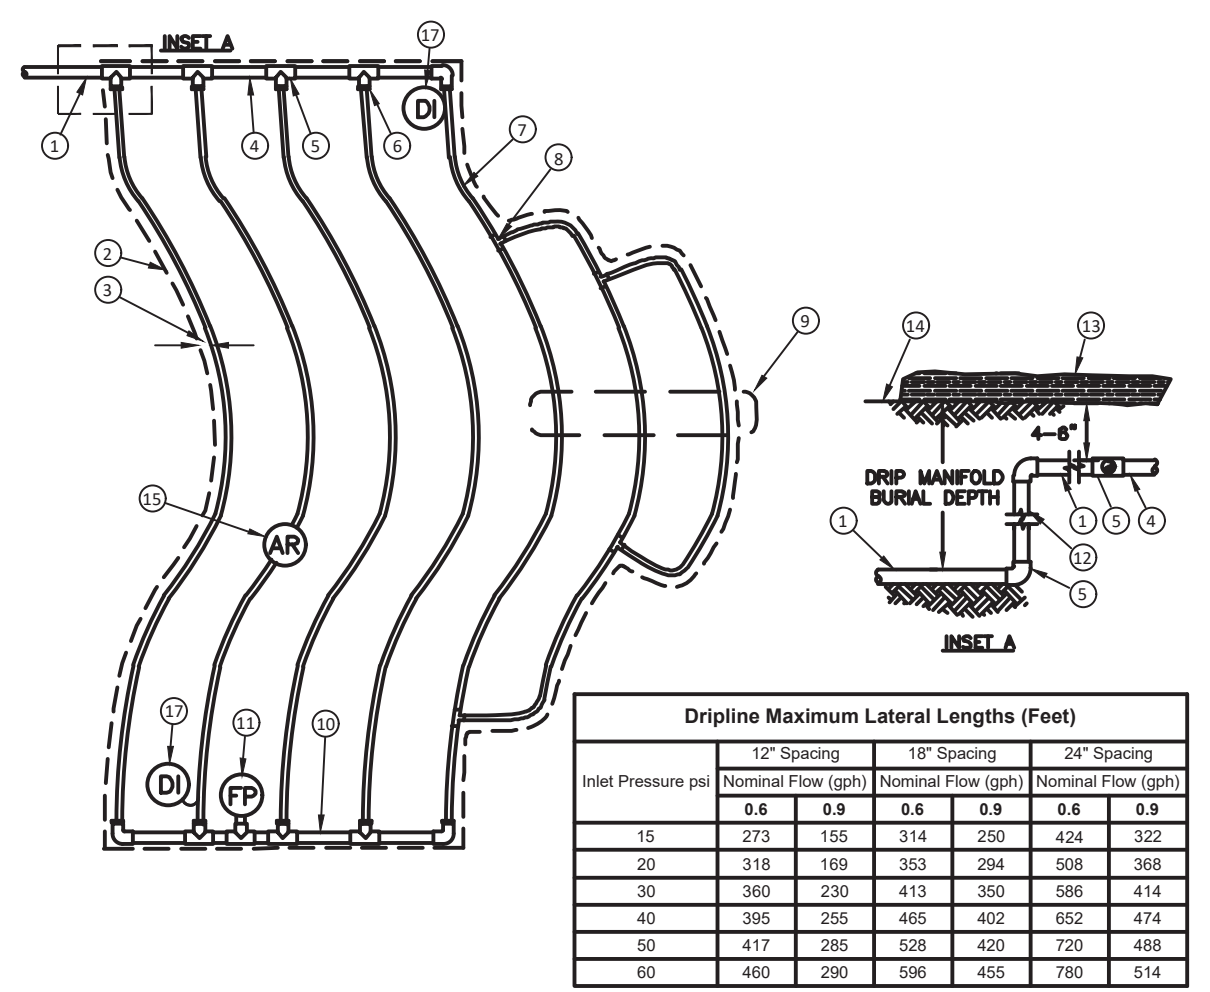


**2 DRIP LAYOUT IN ODD SHAPED PLANTER**  
NTS AB-IR-DRI-DRIP-09

1. DISTANCE BETWEEN LATERAL ROWS AND EMITTER SPACING TO BE BASED ON SOIL TYPE, PLANT MATERIALS AND CHANGES IN ELEVATION.
2. LENGTH OF LONGEST DRIPLINE LATERAL SHOULD NOT EXCEED THE MAXIMUM SPACING SHOWN IN THE ACCOMPANYING TABLE.
3. INSTALL AIR RELIEF VALVE AT HIGH POINTS IN DRIPLINE.
4. WHEN USING BARBED INSERT FITTINGS WITH DESIGN PRESSURE OVER 50PSI, IT IS RECOMMENDED THAT STAINLESS STEEL CLAMPS BE INSTALLED ON EACH FITTING.

- NOTES TO INSTALLER:**
1. INSTALL FIRST DRIPLINE LOOP 18-INCHES FROM CENTER OF TREE TRUNK. INSTALL EACH ADDITIONAL LOOP 12" APART.
  2. INSTALL DRIPLINE ON SURFACE TO MAXIMUM OF 6-INCHES BELOW GRADE. STAPLE IN PLACE PER MANUFACTURER'S RECOMMENDATIONS, BACKFILL AND SPREAD SURFACE TREATMENT AS DIRECTED BY OTHERS.
  3. INSTALL DRIPLINE IN ACCORDANCE WITH MANUFACTURER'S INSTALLATION GUIDELINES.
  4. DRIPLINE RINGS MUST BE 0.9 GPH 12" O.C. EMITTER SPACING
  5. TOTAL FLOW OF
    - 2 DRIPLINE RINGS IS 6 GPH (1.44"/H)
    - 3 DRIPLINE RINGS IS 18 GPH (1.44"/H)
    - 4 DRIPLINE RINGS IS 24 GPH (1.44"/H)

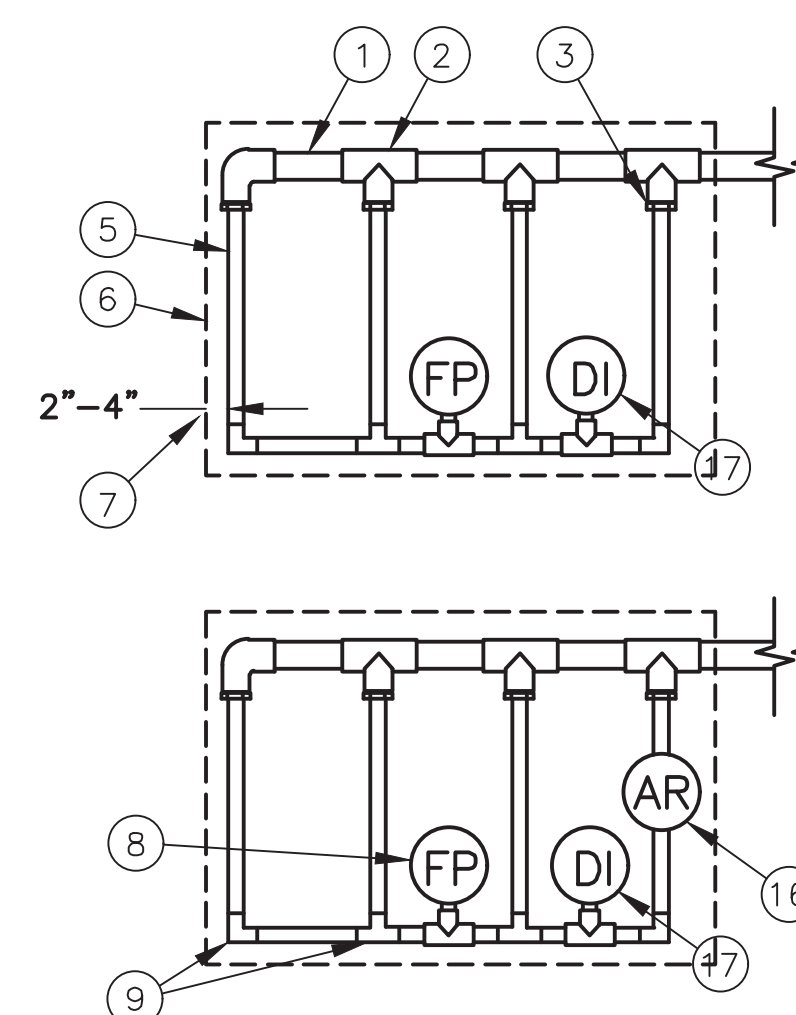

**3 DRIP HEADER DETAIL**  
NTS AB-IR-DRI-DRIP-15

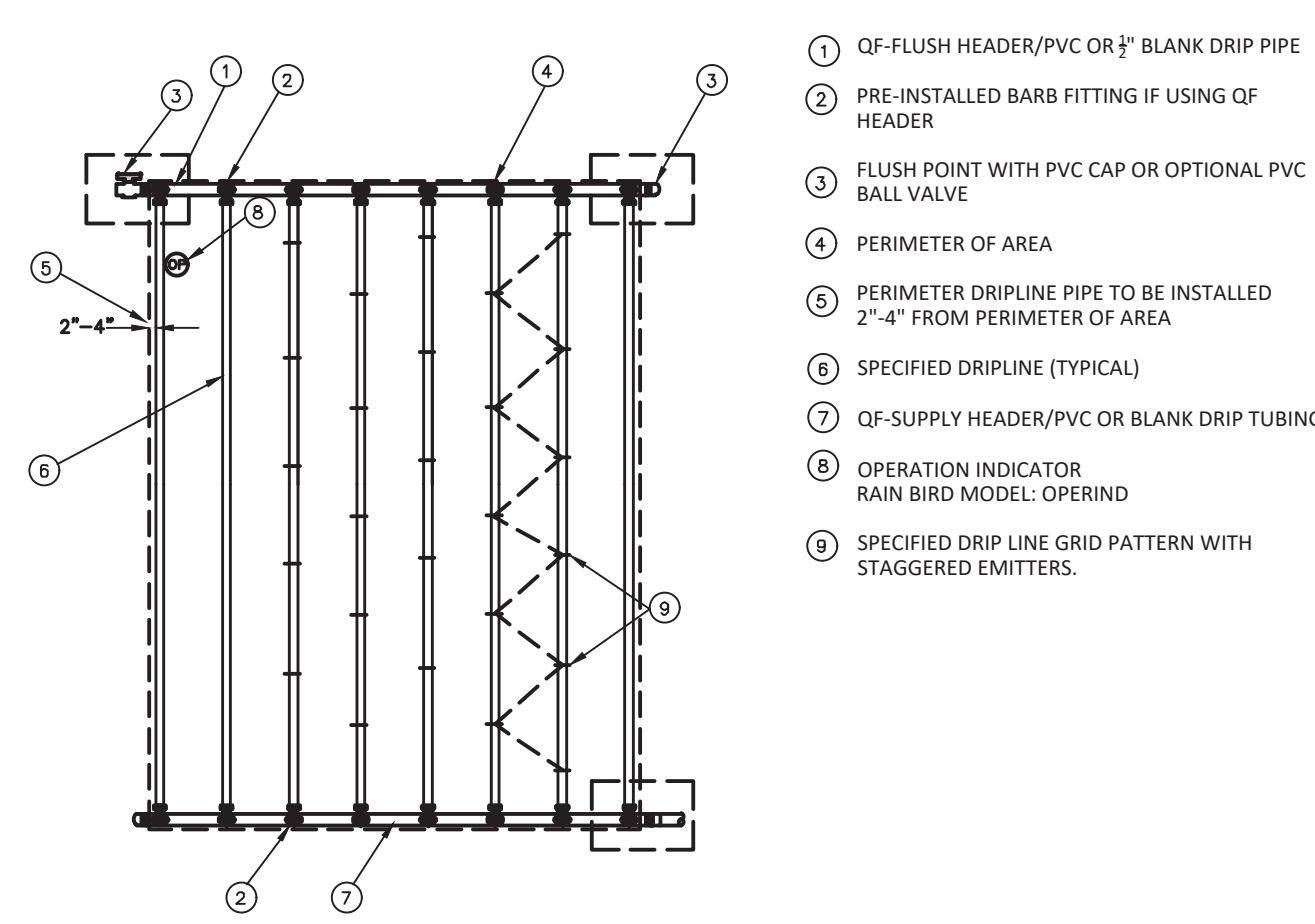

**4 DRIP LINE TREE RING DETAIL**  
1" = 1" AB-IR-DRI-DRIP-21

**5 STAGGERED DRIPLINE EMITTER PATTERN**  
NTS AB-IR-DRI-DRIP-15

- ① OF-FLUSH HEADER/PVC OR 1/2" BLANK DRIPLINE PIPE
- ② PRE-INSTALLED BARB FITTING IF USING OF HEADER
- ③ FLUSH POINT WITH PVC CAP OR OPTIONAL PVC BALL VALVE
- ④ PERIMETER OF AREA
- ⑤ PERIMETER DRIPLINE PIPE TO BE INSTALLED 2"-4" FROM PERIMETER OF AREA
- ⑥ SPECIFIED DRIPLINE (TYPICAL)
- ⑦ OF-SUPPLY HEADER/PVC OR BLANK DRIPLINE TUBING
- ⑧ OPERATION INDICATOR RAIN BIRD MODEL: OPERING
- ⑨ SPECIFIED DRIPLINE GRID PATTERN WITH STAGGERED EMITTERS.

**NOTES:**


1. DISTANCE BETWEEN LATERAL ROWS AND EMITTER SPACING TO BE BASED ON SOIL TYPE, PLANT MATERIALS AND CHANGES IN ELEVATION.

MAXIMUM LATERAL LENGTH (FEET)			
PSI	EMITTER FLOW RATE GPH		24" SPACING
	12" SPACING	18" SPACING	
10	125 96	175 135	218 171
20	249 191	350 171	442 340
30	307 236	434 333	550 422
40	350 268	495 380	627 171
50	385 296	526 420	720 171
60	417 285	596 455	780 171

GRID PRECIPITATION RATES (IN/HR)		
EMITTER SPACING	LATERAL SPACING	EMITTER FLOW RATE
12	12	0.06 1.44
18	18	0.69 1.03
24	24	0.28 0.41

LATERAL FLOW PER 100 FT (GPM)			
EMITTER FLOW	12" SPACING	18" SPACING	24" SPACING
0.6 GPH	1.0 GPM	0.67 GPM	0.50 GPM
0.9 GPH	1.5 GPM	1.0 GPM	0.75 GPM

- SLOPED CONDITION NOTE:**
1. DRIPLINE LATERALS SHOULD FOLLOW THE CONTOURS OF THE SLOPE WHENEVER POSSIBLE.
  2. INSTALL AIR RELIEF VALVE AT HIGHEST POINT.
  3. NORMAL SPACING WITHIN THE TOP 2/3 OF SLOPE,
  4. INSTALL DRIPLINE AT 25% GREATER SPACING AT THE BOTTOM 1/3 OF THE SLOPE.
  5. WHEN ELEVATION CHANGE IS 10 FT OR MORE, ZONE THE BOTTOM 1/3 ON A SEPARATE VALVE.

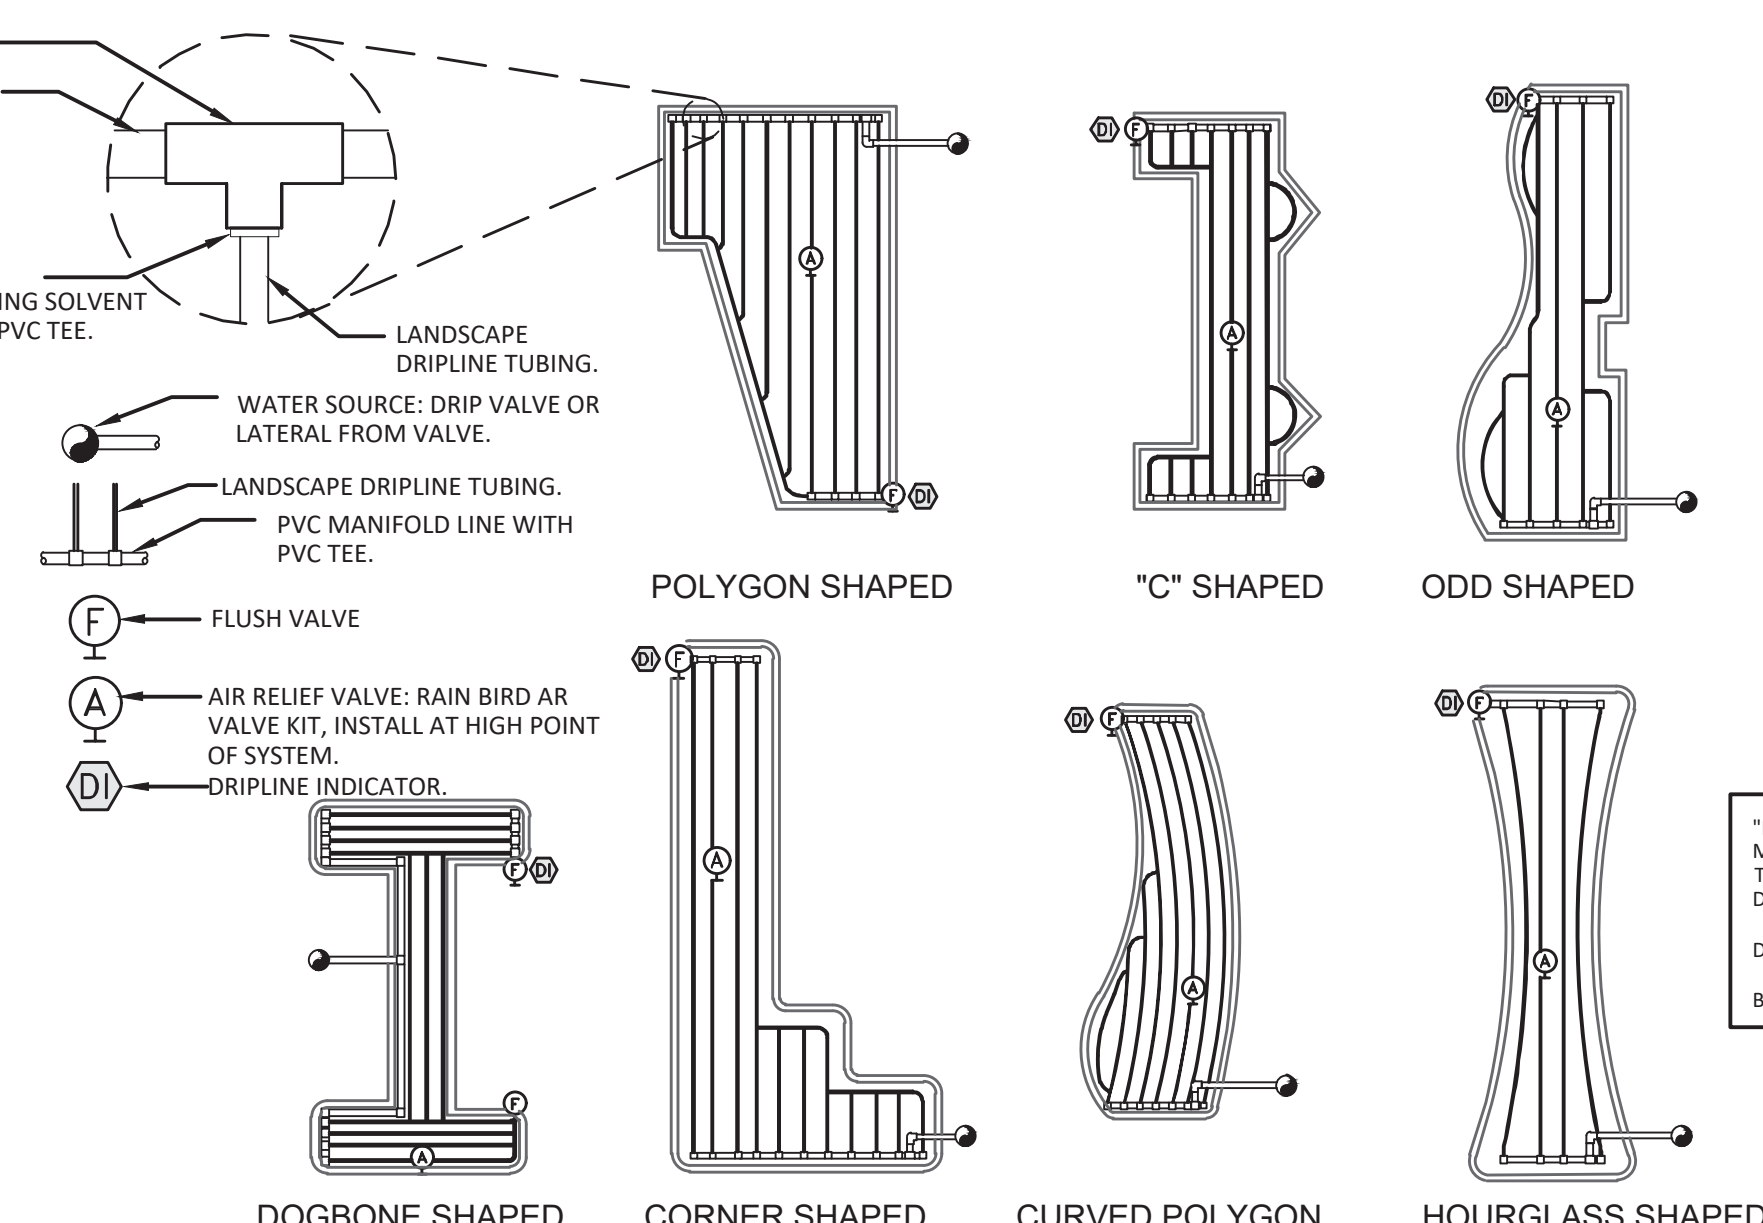

**6 TYPICAL DRIPLINE REQUIREMENTS**  
NTS AB-IR-DRI-DRIP-19

THESE PLANS ARE THE PROPERTY OF 4B INCORPORATED AND CAN NOT BE COPIED WITHOUT PERMISSION.

General Notes



IRRIGATION NOTES

Table with 3 columns: No., Revision/Issue, Date. Contains a grid for tracking revisions.

Firm Name and Address



Project Name and Address

COLUMBUS ST. EL GRANADA, CA

Table with 2 columns: Field Name, Value. Fields include Project (236-2019), Date (9/10/19), Scale, and Sheet (IR-4.0).

Project 236-2019, Date 9/10/19, Scale, Sheet IR-4.0

I HAVE COMPLIED WITH THE LANDSCAPE DESIGN CRITERIA OF THE MODEL WATER EFFICIENT LANDSCAPE ORDINANCE AND APPLIED THEM ACCORDINGLY FOR THE EFFICIENT USE OF WATER IN THIS DESIGN. DATED: 6/15/2020 BY: Andrew Bolt



THESE PLANS ARE THE PROPERTY OF 811 INCORPORATED AND CANNOT BE COPIED WITHOUT PERMISSION

SECTION 32 8400 IRRIGATION PART 1 GENERAL 1.1 SUMMARY 1.1.1 IRRIGATION SYSTEM 1.2 CONTRACT DOCUMENTS 1.3 RELATED DOCUMENTS AND REFERENCES 1.4 VERIFICATION 1.5 PERMITS AND REGULATIONS 1.6 PROTECTION OF WORK, PROPERTY AND PERSON 1.7 CHANGES IN THE WORK 1.8 CORRECTION OF WORK 1.9 DEFINITIONS 1.10 SUBMITTALS 1.11 OBSERVATION OF THE WORK 1.12 PRE-CONSTRUCTION CONFERENCE 1.13 QUALITY ASSURANCE 1.14 IRRIGATION SYSTEM WARRANTY 1.15 SITE CONDITIONS 1.16 DELIVERY, STORAGE, AND HANDLING

A. All materials and equipment shall be stored properly and protected as required by the Contractor. The Contractor shall be entirely responsible for damages or loss by weather or other cause to work under the contract. Materials shall be furnished in ample quantities and at such times as to ensure uninterrupted progress of the work. B. Deliver the products to the job site in their original unopened container with labels intact and legible at time of use. C. Store in accordance with the manufacturers' recommendations. 1.17 PROTECTION A. The Contractor shall continuously maintain adequate protection of all of their work from damage, destruction, or loss, and shall protect the owner's property from damage arising in connection with this contract. B. The Contractor shall maintain sufficient safeguards, such as railings, temporary walls, lights, etc., against the occurrence of accidents, injuries or damage to any person or property resulting from their work. C. All existing paving, structure, equipment or plant material shall be protected at all times, including the irrigation system related to plants, from damage by workers and equipment. D. All existing paving, structure, equipment or plant material shall be protected at all times, including the irrigation system related to plants, from damage by workers and equipment. 1.18 EXCAVATING AROUND UTILITIES A. Contractor shall carefully examine the civil, record, and survey drawings to become familiar with the existing underground conditions before digging. B. Do not begin any excavation until all underground utilities have been located and marked. C. Determine location of underground utilities and perform work in a manner that will avoid possible damage. D. Notification to 811 is required for all excavation activities. 1.19 POINT OF CONNECTION Point of connection option 1 - Irrigation Contractor provided A. The point of connection of the irrigation system to its electrical power sources shall be provided by the irrigation installer. B. The point of connection of the irrigation system to its potable and/or non-potable water sources, including the main shut-off valve and backflow preventer shall be provided by the irrigation installer. Point of connection option 2 - General Contractor provided A. The point of connection of the irrigation system to its electrical power sources shall be provided by the General Contractor's licensed electrical Contractor per governing codes at the location shown on the drawings. B. The point of connection of the irrigation system to its potable and/or non-potable water sources, including the main shut-off valve and backflow preventer shall be provided by the General Contractor's licensed plumbing Contractor per governing codes at the location shown on the drawings. 1.20 TEMPORARY UTILITIES A. All temporary piping, wiring, meters, panels and other related accommodations required between source of supply and point of use shall be provided by the Contractor and coordinated with the Owner's Representative. 1.21 CUTTING, PATCHING, TRENCHING AND DIGGING A. The Contractor shall do all cutting, fitting, trenching or patching of their work that may be required to make its several parts come together as shown upon, or implied by, the drawings and specifications for the completed project. B. Digging and trenching operations shall be suspended when the soil moisture is above field capacity. 1.22 USE OF PREMISES A. The Contractor shall confine their apparatus, the storage of materials, and the operations of their workers to limits indicated by the law, ordinances, or permits and shall not unreasonably encumber the premises with their materials. B. Contractor parking, and material and equipment storage shall in areas approved by the Owner's Representative. 1.23 AS BUILT RECORD SET OF DRAWINGS A. Immediately upon the installation of any buried pipe or equipment, the Contractor shall indicate on the progress record drawings the locations of said pipe or equipment. B. Before final acceptance of work, the Contractor shall provide an as built record set of drawings showing the irrigation system work as built. C. All main line pipe or irrigation equipment including sleeves, valves, controllers, irrigation wire runs which deviate from the mainline location, backflow preventers, remote control valves, grounding rods, shut-off valves, rain sensors, wire splice locations, and quick coupling valves shall be located by two (2) measured dimensions, to the nearest one-half foot. D. All changes in direction and depth of main line pipe shall be noted exactly as installed. 1.24 CONTROLLER CHARTS A. Provide one controller chart for each automatic controller installed. B. On the inside surface of the cover of each automatic controller, prepare and mount a color-coded chart showing the valves, main line, and systems serviced by that particular controller. C. All valves shall be numbered to match the operation schedule and the drawings. D. All riser nipples for that controller shall be made to a size that will fit into the controller. E. The controller chart shall be completed and approved prior to acceptance of the cabinet. 1.25 TESTING A. Provide all required system testing with written reports as described in part 3. 1.26 OPERATION AND MAINTENANCE MANUALS AND WARRANTIES A. Prepare and deliver to the Owner's Representative within ten calendar days prior to completion of construction, two 3-ring hard cover binders containing the following information: B. Index sheet stating Contractor's address and telephone number, list of equipment with name and addresses of local manufacturers' representatives. C. Catalog and parts sheets on all material and equipment. D. Guarantee statement. E. Complete operating and maintenance instruction for all major equipment. F. Irrigation product manufacturers warranties. G. In addition to the above-mentioned maintenance manuals, provide the Owner's maintenance personnel with instructions for maintaining major equipment and show evidence in writing to the Owner's Representative at the conclusion of the project that this has been rendered.

PART 2 PRODUCTS 2.1 MATERIALS GENERAL A. All materials shall be of standard, approved and first grade quality and shall be new and in perfect condition when installed and accepted. B. See the parts schedule on the drawings for specific components and manufacturers. C. Approval of any items or substitutions indicates only that the products apparently meet the requirements of the drawings and specifications on the basis of the information or samples submitted. 2.2 RECLAIMED WATER SYSTEM DESIGNATION A. Where irrigation systems use reclaimed water, all products including valve boxes, lateral and main line pipe, etc., where applicable and/or required by local code shall have the reclaimed water purple color designation. 2.3 PIPING MATERIAL A. Individual types of pipe and fittings supplied are to be compatible manufacturer unless otherwise approved. B. Plastic pipe: 1. All pipe shall be free of blisters, internal striations, cracks, or any other defects or imperfections. 2. Pressure main line for piping subsystems of remote control valves and quick coupling valves: a. Pipe smaller than 2 inch diameter shall be plastic pipe for use with solvent weld or threaded fittings. b. Pipe 2 - 3 inch diameter shall be manufactured rigid vinyl polyvinyl chloride (PVC), Type 1, Grade 2 conforming to ASTM D 1785, designated as bell gasket Class 315. c. Pipe larger than 3 inch diameter shall be manufactured rigid vinyl polyvinyl chloride (PVC), Type 1, Grade 2 conforming to ASTM D 1785, designated as bell gasket Class 200 PVC. 3. Non-pressure lateral line for piping downstream of remote control valves, plastic pipe for use with solvent weld or threaded fittings. C. Galvanized pipe shall be used for above ground connectors to, backflow prevention device assemblies, hose bibs, and booster pumps and as shown on the plans and details. 2.4 FITTINGS AND CONNECTIONS A. Polyvinyl chloride pipe fittings and connections: Type II, Grade 1, Schedule 40, high impact molded fittings, manufactured from virgin compounds as specified for piping solvent socket or molded thread type, suitable for either solvent weld or screwed connections. B. Brass pipe fittings, unions and connections: standard 125 pound class 85% red brass fittings and connections, IPS threaded. C. Solvent cements and thread lubricant: A. Solvent cements shall comply with ASTM D2564. B. Thread lubricant shall be Teflon ribbon-type, or approved equal, suitable for threaded installations as per manufacturer's recommendations. C. Pipe Joint Compound (Pipe dope) shall be used on all galvanized threaded connections. 2.5 INCIDENTAL MATERIALS AND EQUIPMENT A. Furnish all materials and equipment not specified above, but which are necessary for completion of the work as indicated. 2.6 MAIN LINE LOCATOR TAPE A. 3 - inch wide plastic detectable locator tape. 2.7 MAIN LINE AND LATERAL LINE BEDDING SAND A. Sand shall consist of natural or manufactured granular material, free of organic material, mica, loam, clay or other substances not suitable for the intended purpose. B. Sand shall be masonry sand ASTM C 144 or coarse concrete sand, ASTM C 33.

B. The main body and access covers shall be low lead bronze (ASTM B 584) C. The seat ring and all internal polymers shall be NSF Listed Noryl and the seat disc elastomers shall be silicone. D. Backflow Preventer shall be as indicated on the drawings. 2.7 PRESSURE REGULATOR A. Pressure regulator shall certified to NSF/ANSI 372, consisting of low lead bronze body bell housing, a separate access cap shall be threaded to the body and shall not require the use of ferrous screws. B. The main valve body shall be cast bronze (ASTM B 584). C. The access covers shall be bronze (ASTM B 584 or Brass ASTM B 16). D. The assembly shall be of the balanced piston design and shall reduce the pressure in both flow and no flow conditions. E. Pressure regulator shall be as indicated on the drawings. 2.7.1 WYE STRAINER A. Strainer shall conform to MIL - S-16293, and be ANSI 300 party certified to comply with the states lead plumbing law 0.25% maximum weighted average lead content. B. The main body shall be low lead bronze (ASTM B 584). C. The access covers shall be yellow brass or cast bronze (ASTM B 16 or ASTM B 584). D. Strainer screen shall be 300 series stainless steel available in 20, 40, 60, 80, or 100 mesh. E. Wye strainer shall be as indicated on the plans. G. 2.8 BACKFLOW PREVENTER CAGE & FROST BLANKET H. A heavy-duty steel mesh cage with rust proof finish. I. Provide a concrete base as detailed on the drawings. J. The cage shall include the manufacturers' standard tamper proof locking mechanism. K. Backflow Preventer Cage type, manufacturer and color shall be as indicated on the plans. L. A Frost Blanket, manufacturer and color shall be as indicated on the plans. 2.9 BOOSTER PUMP (where applicable) A. Booster pump shall be housed in a sturdy, locking, weather-resistant case, furnished for maximum exterior protection. B. Booster pump shall be as indicated on the drawings. 2.10 BALL VALVES A. Ball valves for 3/4 inch through 2 - 1/2 inch shall be of PVC, block, tri-union design with EPDM seals and o-ring. B. Ball valves for 3 inch and larger shall be gate design and shall be iron body, brass or bronze monel AWWA gate valves, and shall have a clear watertight equal to the full nominal diameter of the valve, and shall be rubber gasket, flanged or mechanical joint only, and shall be able to withstand a continuous working pressure of 150 PSI. C. All ball valves located in a valve manifold shall be the same size as the main line (1-1/2 inch size minimum). D. Ball valves shall be as indicated on the drawings. 2.11 CHECK VALVES A. Swing check valves 2 inch and smaller shall be 200 lbs. W.O.G., bronze construction with replaceable composition, neoprene or rubber disc and shall meet or exceed federal specification WW-V-36, class a, type k. B. Anti drain valves shall be of heavy-duty virgin PVC construction with female iron pipe thread inlet and outlet. C. Check valves shall be as indicated on the drawings. 2.12 REMOTE CONTROL VALVES A. Remote control valves shall be electrically operated, single seat, normally closed configuration, equipped with flow control adjustment and capability for manual operation. B. Valves shall be actuated by a normally closed low wattage solenoid using 24 volts, 50/60 cycle solenoid power requirement. C. Remote control valves shall be wired to controller in same numerical sequence as indicated on drawings. D. Remote control valves shall be as indicated on the drawings. 2.13 MASTER CONTROL VALVES E. Master Control Valve shall be compatible with the irrigation controller. F. Master control valves shall be as indicated on the drawings. 2.14 FLOW SENSOR A. Flow sensor shall be compatible with the irrigation controller. B. Flow sensor shall be as indicated on the drawings. 2.15 HYDROMETER C. Hydrometer shall be compatible with the irrigation controller. D. Hydrometer shall be as indicated on the drawings. 2.16 QUICK COUPLER VALVES A. Quick coupler valves shall be a one or two piece, heavy-duty brass construction with a working pressure of 150 PSI with a built in flow control and a self closing valve. B. Quick coupler shall be equipped with locking red brass cap covered with durable yellow thermoplastic rubber cover. C. Quick coupler valves shall be as indicated on the drawings. 2.17 SPRINKLER HEADS D. All sprinkler heads shall have check valves installed. E. All sprinkler heads shall be as indicated on the drawings. F. Riser nipples for all sprinkler heads shall be the same size as the riser opening in the sprinkler body and fabricated as shown on the drawings. 2.18 AUTOMATIC CONTROLLER A. Controller shall be housed in a sturdy, locking, weather resistant case, furnished for maximum exterior protection. B. Controller shall be equipped with evapo-transpiration (ET) sensor, which adjusts the controller programming based on local climatic conditions. C. Remote control valves shall be wired to controller in same numerical sequence as indicated on drawings. D. Decoder model number shall be as shown on the drawings. 2.20 ELECTRICAL CONTROL WIRING A. Low voltage 1. The electrical control wire shall be direct burial type UF, no. 14 AWG, solid, single conductor, copper wire UL approved or larger, if required to operate system as designed. 2. For 2-Wire controllers all irrigation wire for the controller, flow sensor, master valve, hydrometer, remote control valves and moisture sensors shall be per the controller manufacturer's specifications and recommendations. 3. Color code wires to each valve. Common wire shall be white. 4. If multiple controllers are being utilized, and wire paths of different controllers cross each other, both common and control wires from each controller to be of different colors. 5. Control wire splices: Splices are when required shall be placed in splice boxes. 6. Wire connections shall be per the controller manufacturer's specifications and recommendations. B. High voltage 1. Shall be of type as required by local codes and ordinances. 2. Shall be of proper size to accommodate needs of equipment it is to serve. 2.21 VALVE BOXES AND MATERIALS A. Valve boxes: valve boxes shall be constructed of ABS (acrylonitrile butadiene styrene) plastic, green in color, with rigid base and sides and shall be supplied with bolt lock cover secured with stainless steel bolts. B. Master valves, flow sensors, remote control irrigation valves, gate valves, and ball valves 3 inch or less in size shall use a 1 1/4 inch x 1 1/2 inch rectangular box. C. Quick coupler valves, wire splices, and grounding rods shall use a 1 inch circular box. 2.22 CONCRETE THRUST BLOCKS A. Concrete thrust blocks shall be sized per the pipe manufacturers requirement or as indicated on the drawings. 2.23 VALVE IDENTIFICATION TAGS A. Valve Identification Tags shall be 2.25 inch x 2.85 inch polystyrene. B. Valve Identification Tags shall be permanently attached to each remote control valve with tamper proof seals as indicated on the drawings. 2.24 EQUIPMENT TO BE FURNISHED TO OWNER A. Two (2) sets of keys for each automatic controller. B. Two (2) sets of keys for each operating the gate valves. C. Three (3) sets of special tools required for removing, disassembling and adjusting each type of sprinkler and valve supplied on this project. D. Five (5) Extra sprinkler heads, nozzles, shrub adapters, nozzle filter screens, for each type used on the project. E. Two (2) quick coupler keys to match manufacturer type of quick coupler. 2.25 INCIDENTAL MATERIALS AND EQUIPMENT A. Furnish all materials and equipment not specified above, but which are necessary for completion of the work as indicated. 2.26 MAIN LINE LOCATOR TAPE A. 3 - inch wide plastic detectable locator tape. 2.27 MAIN LINE AND LATERAL LINE BEDDING SAND A. Sand shall consist of natural or manufactured granular material, free of organic material, mica, loam, clay or other substances not suitable for the intended purpose. B. Sand shall be masonry sand ASTM C 144 or coarse concrete sand, ASTM C 33.

PART 3 EXECUTION

3.1 GENERAL REQUIREMENTS

- A. Code requirements shall be those of state and municipal codes and regulations locally governing this work... B. Extreme care shall be exercised at all times by the Contractor in excavating and working in the project area... 1. The Contractor is responsible for identifying and maintaining existing irrigation main lines... C. Plan locations of backflow preventers, valves, controllers, irrigation lines, sleeves, spray heads... D. Prior to any work the Contractor shall stake out locations of all pipe, valves, equipment and irrigation heads... E. Stub out main line at all end runs and as shown on drawings... F. Point of connection shall be approximately as shown on drawings... G. Permission to shut off any existing in-use water line must be obtained 48 hours in advance... H. No fittings shall be installed on pipe underneath pavement or walls... I. Prior to starting any work, Contractor shall obtain a reading of existing static water pressure...

3.2 TRENCHING, DIRECTIONAL BORING AND SLEEVING

- A. Perform all trenching, directional boring, sleeving and excavations as required for the installation of the work... B. The Contractor may directional bore lines where it is practical or where required on the plans... 1. Extend the bore 1" past the edge of pavement unless noted differently on the plans... 2. Cap ends of each bore and locate ends at finished grade using metal stakes... 3. All boring and sleeving shall have detectable locator tape placed at the ends of the pipe... C. Excavate trenches wide enough to allow a minimum of 4 - inch between parallel pipelines and 8 inch from lines of other trades... D. Trenches for pipelines shall be made of sufficient depth to provide the minimum cover from finished grade... E. Pressure main line: 18 inches below finish grade and 24-30 inches below paved areas... F. Reclaimed water constant pressure main lines shall cross at least twelve (12) inches below potable water lines... G. When trenching through areas of imported or modified soil, deposit imported or modified soils on one side of trench... H. Backfill the trench per the requirements in paragraphs "Backfilling and Compacting" below...

3.3 PIPE INSTALLATION

- A. General Pipe Installation
1. Exercise caution in handling, loading and storing... a. The pipe and fittings shall be stored under cover... b. All pipe that has been dented or damaged shall be discarded...
2. Trench depth shall be as specified above from the finish grade to the top of the pipe...
3. Install a detectable pipe locator tape 6 to 8 inches above all main line pipes...
B. Polyvinyl Chloride Pipe (PVC) Installation
1. Under no circumstance is pipe to rest on concrete, rock, wood blocks, construction debris or similar items...
2. No water shall be permitted in the pipe until a period of at least 24 hours has elapsed...
3. Install assemblies and pipe to conform to respective details and where shown diagrammatically on drawings...
4. Dielectric bushings shall be used in any connections of dissimilar metals...
5. Gasketed plastic pipe: pipe-to-pipe joints or pipe to fittings shall be made in accordance with manufacturer's specifications...
6. Solvent weld or threaded plastic pipe:
a. Installation of all pipe and fittings shall be in strict accordance with manufacturer's specifications...
b. Pipe shall be cut using approved PVC pipe cutters only...
c. Welded joints shall be given a minimum of 15 minutes to set before moving...
d. Plastic to metal connections shall be made with plastic adapters...
e. Snake pipe horizontally in trench to allow one (1) foot of expansion and contraction per 100 feet of straight run...
f. Threaded pipe joints shall be made using Teflon tape...
g. No close nipples or risers are allowed...
h. Center lead pipe at 10 feet on center intervals with small amount of backfill...
i. Concrete thrust blocks shall be constructed behind all pipe fittings...
C. Galvanized Pipe Installation
1. All joints shall be threaded with pipe joint compound used on all threads...
2. Dielectric bushings shall be used in any connections of dissimilar metals...

3.4 TRENCHING, DIRECTIONAL BORING, AND SLEEVING REVIEW:

A. Upon completion and installation of all trenching, directional boring, and sleeving, all installed irrigation control wiring, lines and fittings shall be visually observed by the Owner's Representative unless otherwise authorized...

3.5 FLUSHING

- A. Openings in piping system during installation are to be capped or plugged to prevent dirt and debris from entering pipe and equipment... B. After completion and prior to the installation of any terminal fittings, the entire pipeline system shall be thoroughly flushed to remove dirt, debris or other material...

3.6 HYDROSTATIC PRESSURE TESTING

- A. After flushing, and the installation of valves the following tests shall be conducted... B. Water pressure tests shall be performed on all pressure main lines before any couplings, fittings, valves and the like are concealed... C. Immediately prior to testing, all irrigation lines shall be purged of all entrapped air... D. Test all pressure main line at 150 PSI... E. Re test as required until the system meets the requirements... F. The Contractor is responsible for proving documentation stating the weather conditions... G. Submit a written report of the pressure testing results... 3.7 BACKFLOW PREVENTER TESTING
A. The backflow preventer shall be tested according to procedures and results per the requirements of the Foundation for Cross-Connection Control and Hydraulic Research... B. Testing shall be performed by a Backflow Prevention Assembly Tester... 3.8 CONTROLLER AND BOOSTER PUMP TESTING AND CERTIFICATION
A. Controller and booster Pump shall be certified by a factory approved certified professional... 3.9 BACKFILLING AND COMPACTING
A. Irrigation trenches shall be carefully backfilled with material approved for backfilling... B. Backfill shall be compacted with approved equipment... C. Backfill of imported planting mixes or modified existing planting soil... D. Any setting of backfill material during the maintenance or warranty period shall be repaired...

3.10 RESURFACING PAVING OVER TRENCHES

- A. Restore all surfaces and repair existing underground installations damaged or cut as a result of the excavation... B. Trenches through paved areas shall be resurfaced with same materials quality and thickness as existing material... C. The cost of all paving restoration work shall be the responsibility of the irrigation Contractor...

3.11 INSTALLATION OF EQUIPMENT

- A. General:
1. All equipment shall be installed to meet all installation requirements of the product manufacturer...
2. Install all equipment at the approximately at the location(s) and as designated and detailed on the drawings...
3. Install all valves within a valve box of sufficient size to accommodate the installation...
4. All sprinkler irrigation systems that are using water from potable water systems shall require backflow prevention...
B. Pressure regulator:
1. Set regulator for required PSI per manufacturer's specifications...
C. Check Valve:
1. Install check valves approximately at the locations necessary to prevent low head run off...
D. Remote control valves:
1. Install one remote control valve per valve box...
2. Remote control valve manifolds and quick coupler valves shall be separate allowing use of a quick coupler...
3. Install boxes no farther than 12 inches from edge of paving and perpendicular to edge of paving...
E. Quick coupler valve:
1. Install each quick coupler valve in its own valve box...
2. Install thrust blocks on quick couplers...
3. Place no closer than 12 inches to adjacent paving...
4. Install 18 inches off set from main line...
F. Sprinkler heads:
1. All main lines and lateral lines, including risers, shall be flushed and pressure tested before installing sprinkler heads...
2. Install specified sprinkler heads as shown in details at locations shown on the drawings...
3. All sprinkler heads shall be set perpendicular to finish grade unless otherwise designated...
G. Irrigation controllers:
1. Remote control valves shall be connected to controller in numerical sequence...
2. Controller shall be tested with complete electrical connections...
3. Connections to control wiring shall be made within the pedestal of the controller...
4. Electrical wiring shall be in a rigid gray PVC plastic conduit...
H. Wiring:
1. Low Voltage
a. Control wiring between controller and electrical valves shall be installed in the same trench...
b. When the control wiring cannot be installed in the same main line trench it shall be installed a minimum of 18 inches below finish grade...
c. An expansion loop shall be provided every 500 feet in a box and inside each valve box...
d. Provide one control wire to service each valve in system...
e. Provide 03 common wire(s) per controller, or as needed...
f. Run two (2) spare #14 - 1 wires from controller along entire main line...
g. All control wire splices not occurring at control valve shall be installed in a separate splice valve box...
h. Wire markers (sealed, 1 inch to 3 inch square) are to identify control wires at valves and at terminal strips...
2. High Voltage
a. All electrical work shall conform to local codes, ordinances and any authorities having jurisdiction...
b. The Contractor shall provide 120-volt power connection to the automatic controller unless noted otherwise on drawings...
I. Valve boxes:
1. Install one valve box for each type of valve installed...
2. Gravel sump shall be installed after compaction of all trenches...
3. Permanently label valve number and/or controller label on top of valve box lid using a method approved by the Owners

- Representative.
J. Tracer wire:
1. Tracer wire shall be installed with non-metallic plastic irrigation main lines...
2. The tracer wire shall be placed on the bottom of the trench...
3. Tracer wire shall be of a color not used for valve wiring...
K. Drip installation:
1. Clamp fittings with Oetiker clamps or approved equal when operating pressure exceeds specific drip tubing fitting requirements...
2. When installing drip tubing, install soil staples as listed below:
a. Sandy Soil - One staple every three (3) feet...
b. Loam Soil - One staple every four (4) feet...
c. Clay Soil - One staple every five (5) feet...
3. Cap or plug all openings as soon as lines have been installed...
4. Thoroughly flush all water lines before installing valves...
3.12 ADJUSTMENT AND COVERAGE TEST
A. Adjustment:
1. The Contractor shall flush and adjust all sprinkler heads, valves and all other equipment...
2. Adjust all sprinkler heads not to overspray onto walks, roadways and buildings...
B. Coverage test:
1. The Contractor shall perform the coverage test in the presence of the Owner's Representative...
2. Any systems that require adjustments for full and even coverage shall be done by the Contractor...
3. The Contractor at no additional cost shall immediately correct all unauthorized changes...
4. The entire irrigation system shall be operating properly with written approval of the installation...

3.13 REPAIR OF PLANTING SOIL

A. Any areas of planting soil including imported or existing soils or modified planting soil which become compacted or degraded as a result of the installation of the irrigation system shall be restored to the specified quality and compaction prior to beginning planting operations...

3.14 CLEAN-UP

- A. During installation, keep the site free of trash, pavements reasonably clean and work area in an orderly condition...
a. Immediately clean up any spilled or tracked soil, fuel, oil, trash or debris deposited by the Contractor...
B. Once installation is complete, wash all soil from pavements and other structures...
1. Make all repairs to grades ruts, and damage to the work or other work at the site...
2. Remove and dispose of all excess soil, packaging, and other material brought to the site by the Contractor...

3.15 PROTECTION

- A. The Contractor shall protect installed irrigation work from damage due to operations by other Contractors or trespassers...
1. Maintain protection during installation until Acceptance...
3.16 PRE-MAINTENANCE OBSERVATION:
A. Once the entire system shall be completely installed and operational and all planting is installed...
B. The irrigation/landscape contractor is responsible for scheduling an irrigation audit...
C. This is not final acceptance and does not relieve the Contractor from any of the responsibilities in the contract documents...

3.17 GENERAL MAINTENANCE AND THE MAINTENANCE PERIOD

- A. General maintenance shall begin immediately after installation of irrigation system...
1. On a weekly basis the Contractor shall keep the irrigation system in good running order...
2. Records of all timing changes to control valves from initial installation to time of final acceptance...
3. During the last week of the maintenance period, provide equipment familiarization and instruction...
4. At the end of the maintenance period, turn over all operations logs, manuals, instructions, schedules...
B. The maintenance period for the irrigation system shall coincide with the maintenance period for the Planting...
3.18 SUBSTANTIAL COMPLETION ACCEPTANCE
A. Upon written notice from the Contractor, the Owners Representative shall review the work...
B. The date of substantial completion of the irrigation shall be the date when the Owner's Representative accepts that all work in Planting, Planting Soil, and Irrigation installation sections is complete...
3.19 FINAL ACCEPTANCE / SYSTEM MALFUNCTION CORRECTIONS
A. At the end of the Plant Warranty and Maintenance period...
1. Restore any soil settlement over trenches and other parts of the irrigation system...
2. Replace, repair or reset any malfunctioning parts of the irrigation system...
B. The Contractor shall show all corrections made from punch list...
C. The Contractor shall show evidence that the Owner's Representative has received all charts, records, drawings...
D. Failure to pass review: If the work fails to pass final review, any subsequent observations must be rescheduled...

END OF SECTION 32 8400

General Notes
LANDSCAPE CONTRACTOR
Andrew Bolt
SIGN HERE
ISSUE DATE
RENEWAL DATE
STATE OF CALIFORNIA

IRRIGATION NOTES

Table with 3 columns: No., Revision/Issue, Date

Firm Name and Address
4Binc
Irrigation Certified
ASIC
COMMERCIAL MEMBER

Project Name and Address
COLUMBUS ST.
EL GRANADA, CA

Table with 2 columns: Project, Date, Scale, Sheet. Contains project details and sheet number IR-4.1

"I HAVE COMPLIED WITH THE LANDSCAPE DESIGN CRITERIA OF THE MODEL WATER EFFICIENT LANDSCAPE ORDINANCE AND APPLIED THEM ACCORDINGLY FOR THE EFFICIENT USE OF WATER IN THIS DESIGN."
DATED: 6/15/2020
BY: Andrew Bolt



THESE PLANS ARE THE PROPERTY OF 4B INCORPORATED AND CAN NOT BE COPIED WITHOUT PERMISSION





Sunland Analytical

11419 Sunrise Gold Circle, #10
Rancho Cordova, CA 95742
(916) 852-8557

DATE 06/12/2020
SUN NUMBER 171992

Information requested by: Andrew Bolt
Architectural Solutions
Information for: 1120 COLUMBUS ST.
Sample ID: BACK GARDEN HILL

SOIL RECOMMENDATIONS FOR LANDSCAPE GARDENING
SOIL pH (Acidity and Alkalinity)
The pH of this sample indicates the soil is moderately acid and should be modified for non acid-tolerant plants.

DISSOLVED SALTS (Indicated by E.C. & TDS)
These conditions are in the normal range for plant growth.

SOIL TEXTURE AND RATE OF WATER INFILTRATION
The infiltration rate for all soil textures decreases with increasing ground slope. At 0 to 4%, 5 to 8%, 9 to 12%, 13 to 16% and above 16% the infiltration rate of this sample decreases from 0.54 to 0.43, 0.32, 0.22, 0.14, respectively.

WATER PENETRATION OF SOIL DUE TO CHEMICAL CHARACTERISTICS
When exchangeable Sodium increases in the soil, water penetration decreases. Based on SAR and ESP values this sample will have increasing problems with water penetration.

ORGANIC MATTER
Organic matter provides a slow nitrogen release and aids water retention. This sample has a moderate Organic Matter content. To maintain moisture and provide sustained nitrogen release a level of 10% organic matter is recommended.



Sunland Analytical

11419 Sunrise Gold Circle, #10
Rancho Cordova, CA 95742
(916) 852-8557

Date Reported 06/12/2020
Date Submitted 06/09/2020

To: Andrew Bolt
Architectural Solutions
918 Sycamore Ave.
Modesto, CA 95350

From: Gene Oliphant, Ph.D. \ Randy Horney
General Manager \ Lab Manager

The reported analysis was requested for the following:
Location : 1120 COLUMBUS ST. Site ID : BACK GARDEN HILL.
Thank you for your business.

\* For future reference to this analysis please use SUN # 82318-171992.

SOIL ANALYSIS

Table with 4 columns: Parameter, Value, Soil Texture, Loam. Includes Saturation Percent (SP), pH, E.C., Tot. Dissolved Salts, Infiltration Rate (0% Slope), % Organic Matter, C.E.C., Sodium Absorption Ratio (SAR), Exchangeable Sodium Percent (ESP), Gypsum Req. (CaSO4\*2H2O), and est. Nitrogen Release.

Table with 2 columns: Element, Concentration (ppm). Includes Nitrate, Phosphorus, Potassium, Sulfur, Chloride, Carbonates, Sodium, Calcium, Magnesium, Boron, Copper, Iron, Manganese, and Zinc.



Sunland Analytical

11419 Sunrise Gold Circle, #10
Rancho Cordova, CA 95742
(916) 852-8557

DATE 06/12/2020
SUN NUMBER 171992

Information requested by: Andrew Bolt
Architectural Solutions
Information for: 1120 COLUMBUS ST.
Sample ID: BACK GARDEN HILL

SOIL RECOMMENDATIONS FOR LANDSCAPE GARDENING

Summary and Suggested Sequence of Soil Improvements (#/1000 Sq.Ft.)
Table with 3 columns: Material, Amount, and Notes. Includes Gypsum, Lime, Organic Amendment, N-P-K Fertiliser, and Sulfate-Sulfur.

Maintenance Fertilization
Apply 5 pounds of Ammonium sulfate (21-0-0) per 1000 sq.ft. every month until plants become established.



Sunland Analytical

11419 Sunrise Gold Circle, #10
Rancho Cordova, CA 95742
(916) 852-8557

DATE 06/12/2020
SUN NUMBER 171992

Information requested by: Andrew Bolt
Architectural Solutions
Information for: 1120 COLUMBUS ST.
Sample ID: BACK GARDEN HILL

SOIL RECOMMENDATIONS FOR LANDSCAPE GARDENING


SOIL BORON
Boron concentrations are in a range allowing normal plant growth.
SOIL MACRONUTRIENTS : NITROGEN-PHOSPHORUS-POTASSIUM (N-P-K)
GENERAL N-P-K RECOMMENDATION

Table with 2 columns: Fertilizer, Customer Choice. Includes Standard NPK, Iron, and Preparations for 1000 sq.ft.

GRASS OR SOD PREPARATION
Till in organic matter, N,P,K and micro nutrients in addition to any lime gypsum or sulfur as directed above.

TREES AND SHRUBS
Excavate holes for planting shrubs and trees to at least twice the volume of the container. Prepare backfill for tree and shrub planting holes by mixing three parts of native soil (or imported top soil) with one part organic amendment.

General Notes

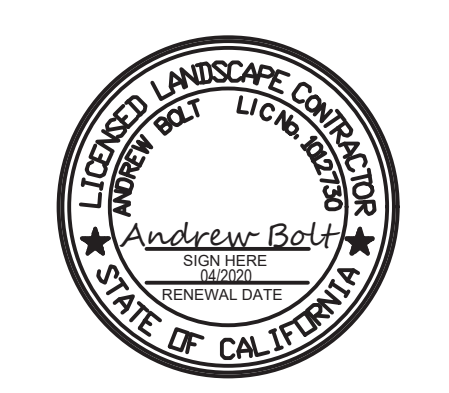

SOILS REPORTING

Table with 3 columns: No., Revision/Issue, Date



Project Name and Address
COLUMBUS ST.
EL GRANADA, CA





Table with 2 columns: Field Name, Value. Includes Project, Date, Scale, Drawn By, Checked By, Approved By, and Sheet.

I HAVE COMPLIED WITH THE LANDSCAPE DESIGN CRITERIA OF THE MODEL WATER EFFICIENT LANDSCAPE ORDINANCE AND APPLIED THEM ACCORDINGLY FOR THE EFFICIENT USE OF WATER IN THIS DESIGN.
DATED: 6/15/2020
BY: Andrew Bolt



THESE PLANS ARE THE PROPERTY OF 4B INCORPORATED AND CAN NOT BE COPIED WITHOUT PERMISSION.

**PREVIOUSLY APPROVED  
LANDSCAPE PLANS**

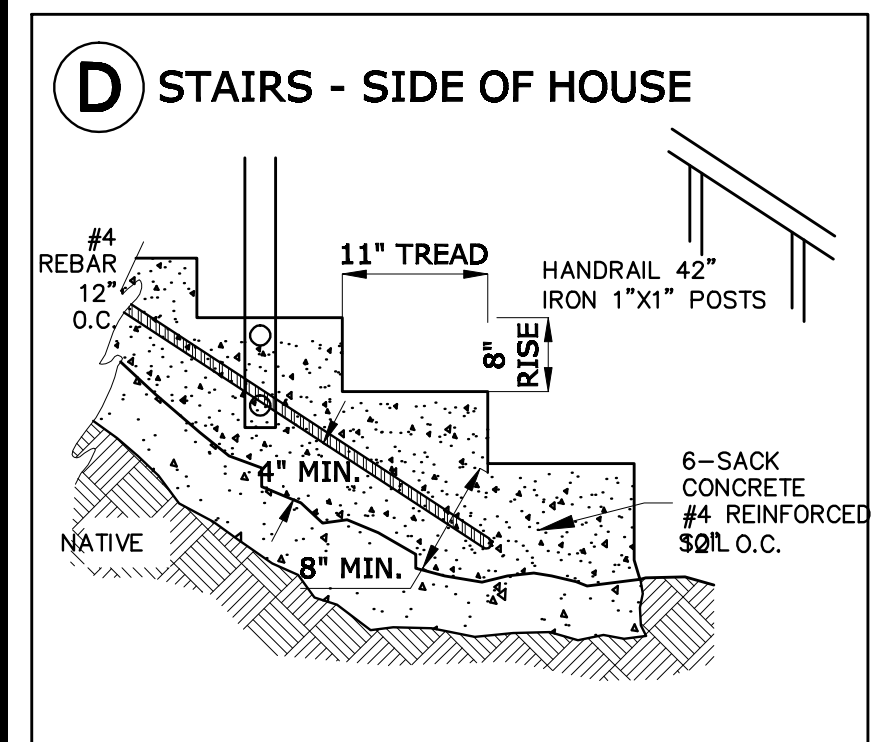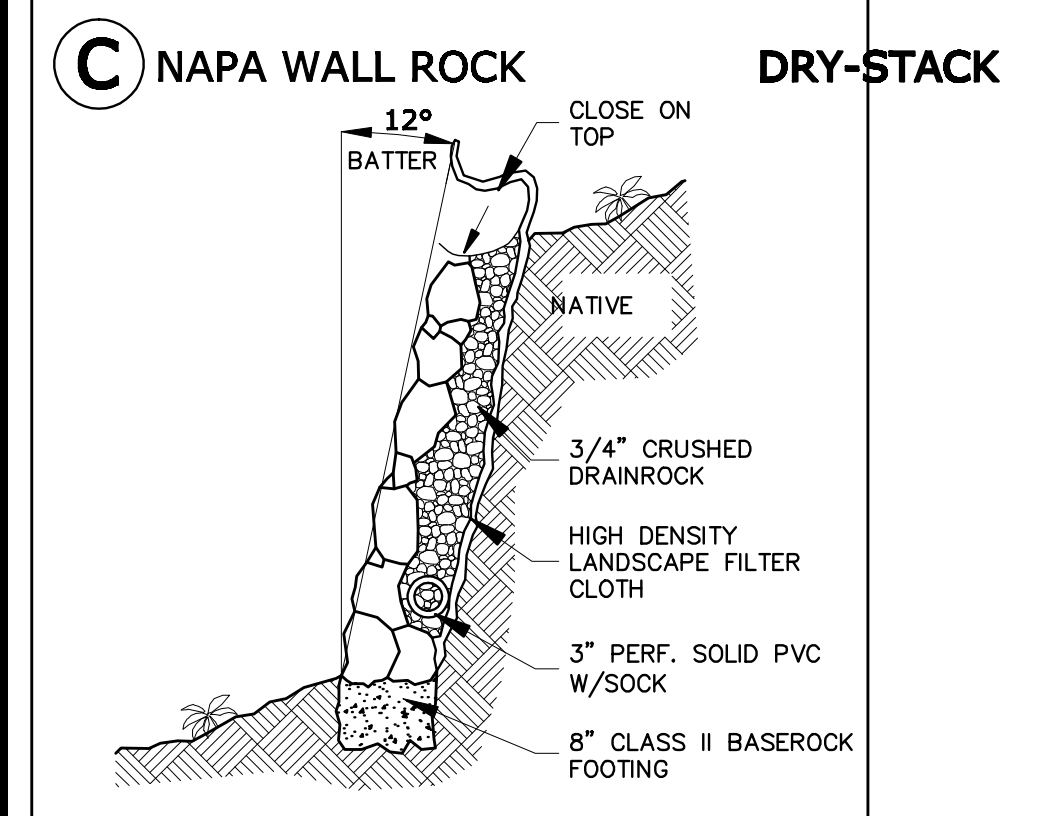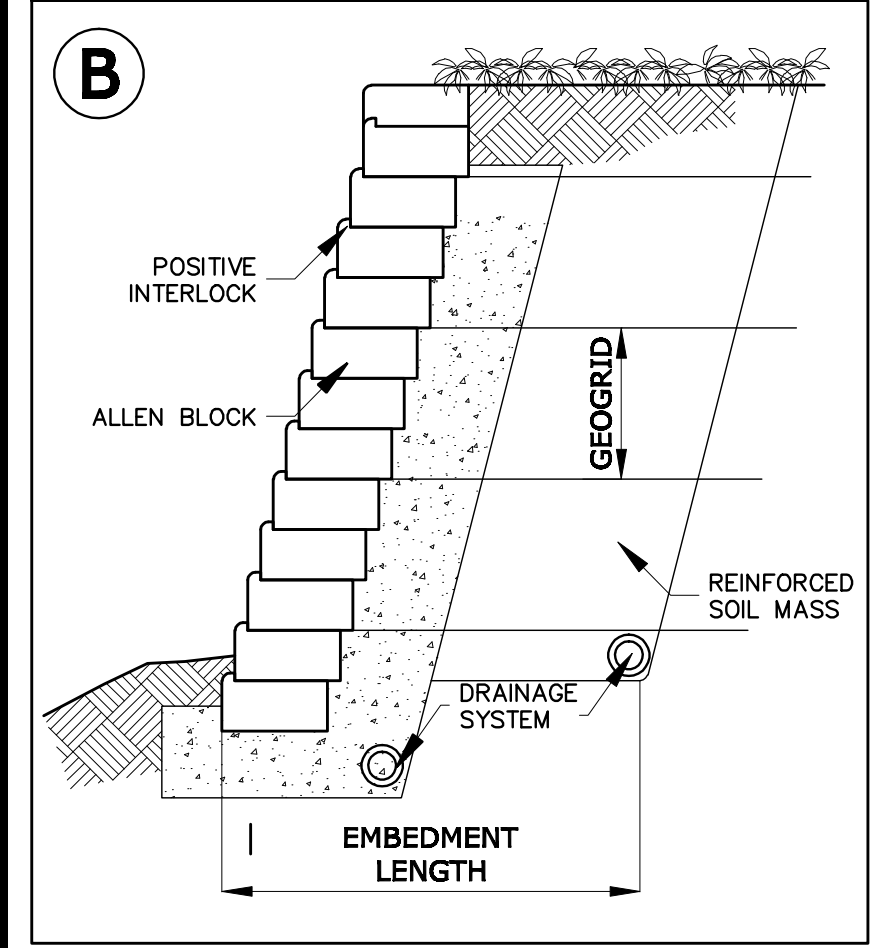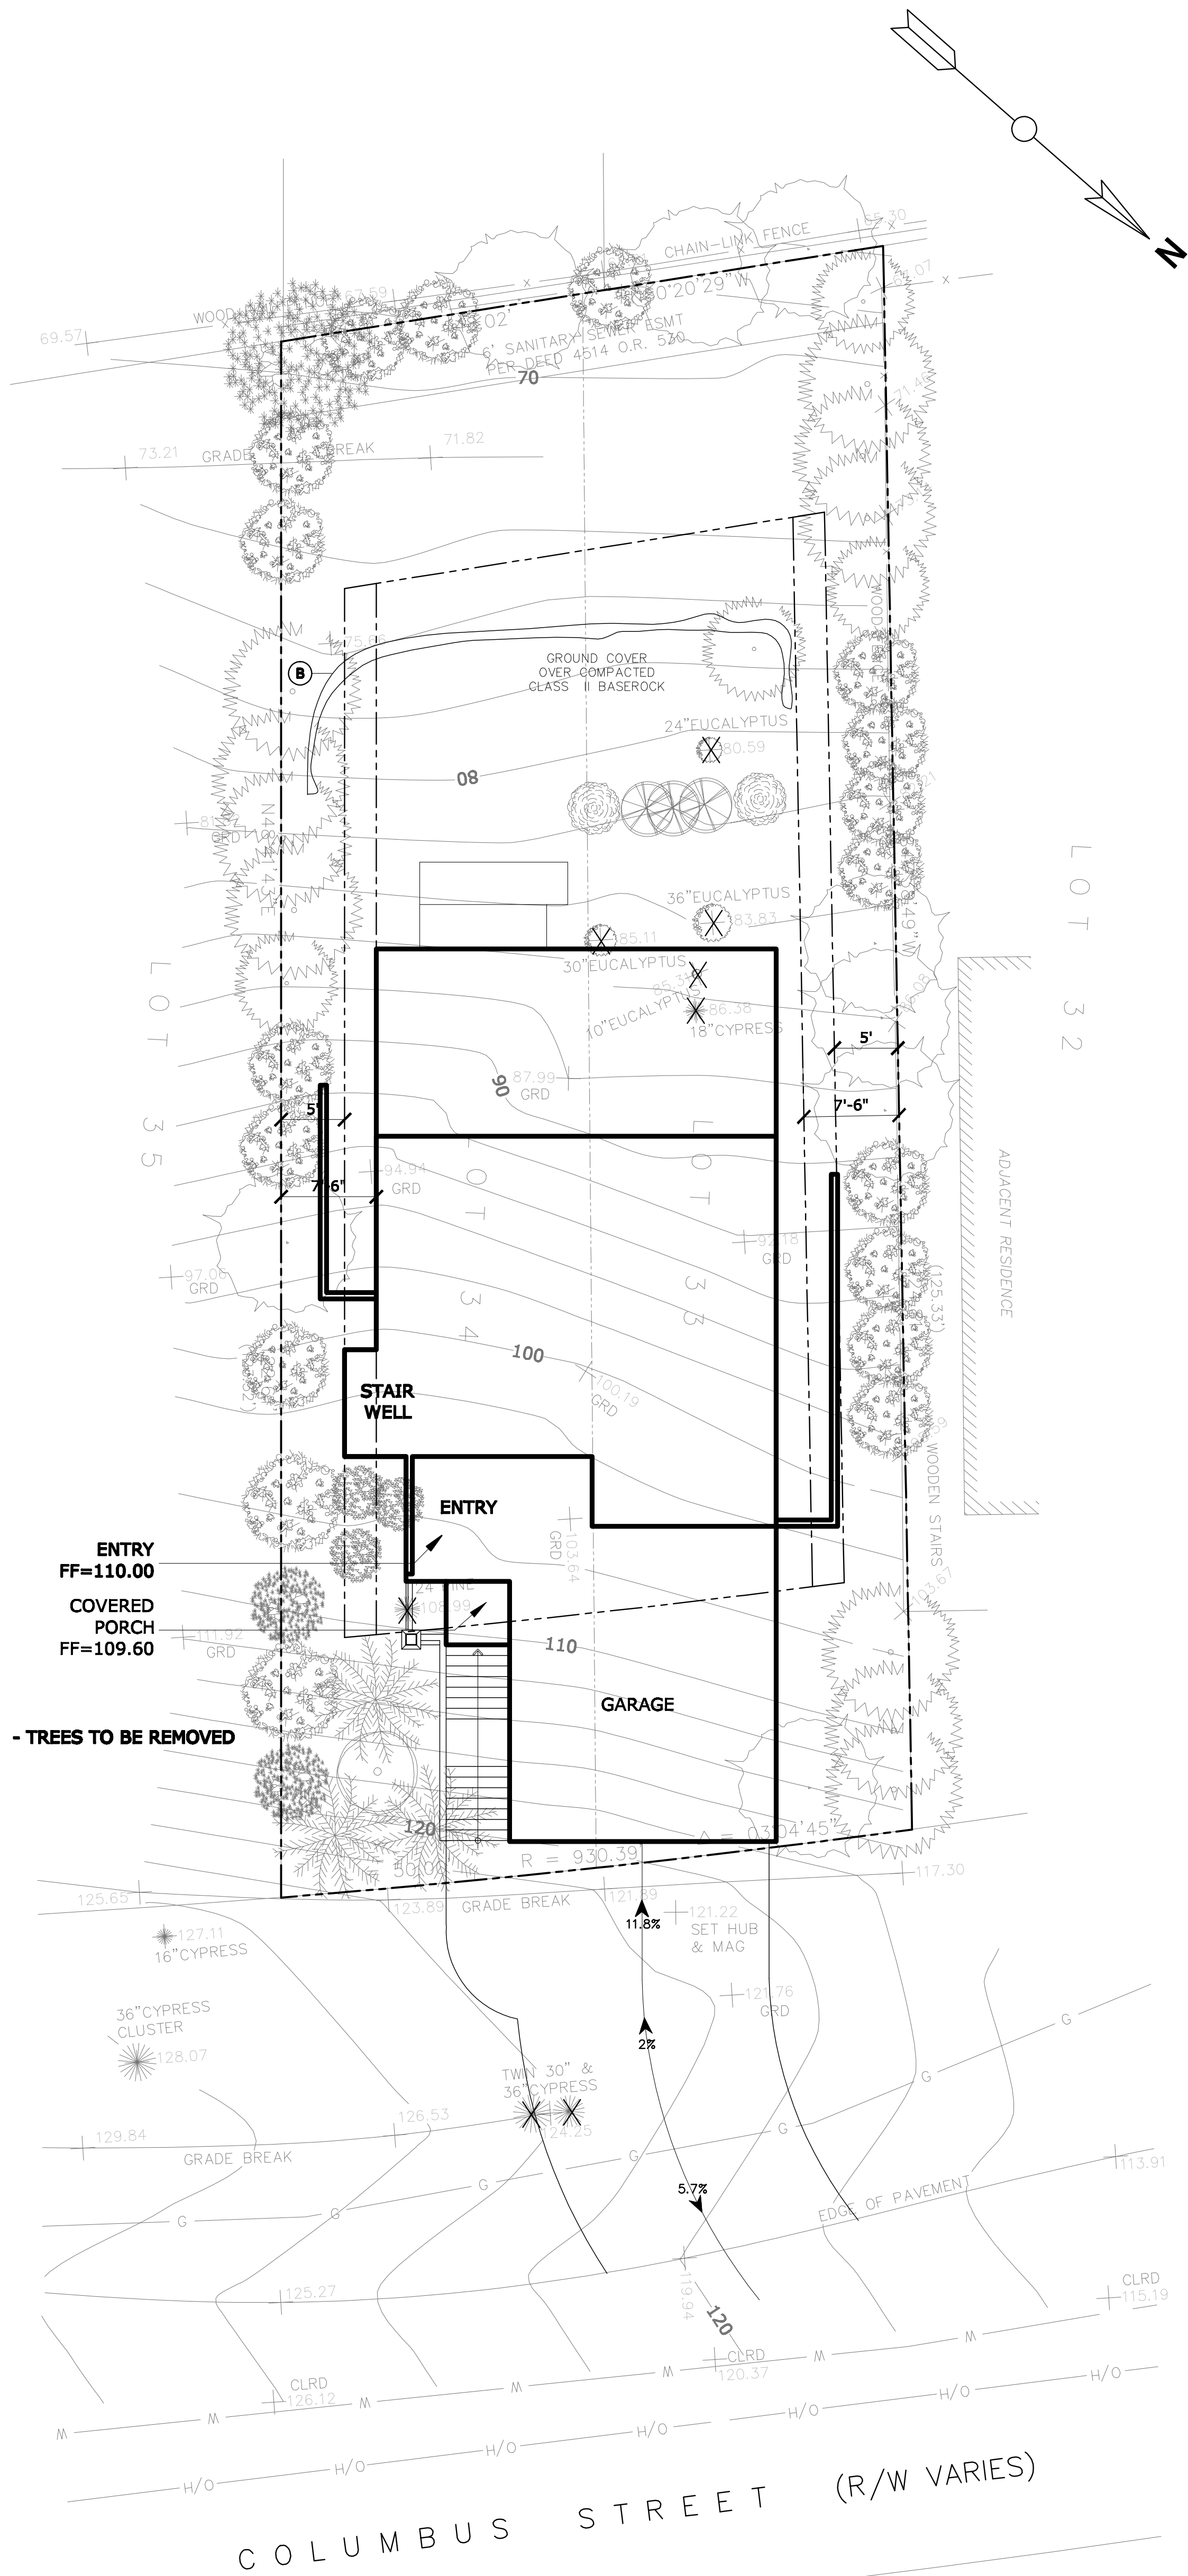

**LANDSCAPE HARDSCAPE CALCULATIONS**

Total Lot Area: 6,026 ft<sup>2</sup>  
 Structure: 2,700 ft<sup>2</sup>  
 Landscaped Area, Lot: 3,326 ft<sup>2</sup>  
 Landscaped Area, R.O.W.: 0 ft<sup>2</sup>  
 Total Landscaped Area: 3,326 ft<sup>2</sup>  
 Total Irrigated Landscape Area: 1,676 ft<sup>2</sup>  
 (All planted areas minus no-irrigate meadow)

Total Front Hardscape: 917 ft<sup>2</sup>  
 Front Permeable: 750 ft<sup>2</sup> Paver Driveway & Wall footings  
 Front Impervious: 167 ft<sup>2</sup> Stairs, Porch & Driveway footing

Total Back & Side Hardscape: 60 ft<sup>2</sup>  
 Back Permeable: 60 ft<sup>2</sup> Wall footing  
 Back Impervious: 0 ft<sup>2</sup>

Total Hardscape coverage: 977 ft<sup>2</sup>  
 Total Landscaped Area: 3,326 ft<sup>2</sup>  
 = % Covered: 29% coverage  
 810 ft<sup>2</sup> Permeable = 24% permeable

**Construction Notes:**

**Concrete Staircase:**  
 Side of house: set on #4 steel reinforced concrete steps: 7 3/4" rise, 11" tread. Handrail 1"x1" steel posts

**Napa Wall Rock Retaining Walls:**  
 Front Yard: Installed Over 8" Class II base rock footing: Construct Napa Wall Rock Dry-Stack retaining wall. Rocks interlock and are constructed w/ 12 Degree batter, drain installed behind wall 3" Perforated pipe w/ 3/4" drain-rock to Daylight.

**Paver Driveway:** Install concrete driveway Pavers (style to be determined) over Compacted Class II base rock. Edges to Retained w/ #4 steel reinforced concrete Footings forming 8" thick x 4" above driveway paver grade

**Engineered Block Retaining Wall:**  
 Back Yard: 4.0' tall Block Wall Installed Over 8" Class II base rock footing: Construct Allen Block or similar manufactured Retaining wall blocks set w/ Geogrid. and are constructed w/ 12 Degree batter, drain installed behind wall 3" Perforated pipe w/ 3/4" drain-rock to Daylight.

**Artsapes Landscape Design & Construction**  
 340 Arlington Road Redwood City, CA  
 License #732462

PREVIOUSLY APPROVED LANDSCAPE PLANS

**C-1**  
 CONSTRUCTION DETAIL  
 SCALE: 1/8" = 1'0"  
 DATE: 08/23/2018

REVISION TABLE			
NUMBER	DATE	REVISED BY	DESCRIPTION

Scott Soden  
 Artsapes Landscape Design  
 Phone: 650-839-1704  
 Cell 650-823-5824

APN 047-275-050

COLUMBUS ST.  
 EL GRANADA, CA.

**PLANT LEGEND:**

**Tall Screen Plants:**  
 R- Rhododendron Red, Pink, Purple 15gal (2)  
 PO- Podocarpus henkelli, 15gal (3)  
 TB- Tibouchina urvilleana, 15gal (1)  
 AR- Arbutus Marina standard, 15gal (9)  
 T- Toyon, 15gal (3)  
 GR- Grevelia "Red Hooks", 5gal (10)  
 D- Dodonaea purpurea, 15gal (17)  
 BS- Buxus Sempervirens, 15gal (1)


**Foundation Plants:**  
 W- Woodwardia fimbriata, 5gal  
 P- Polystichum munitum, 1gal (3)  
 SC- Salvia Cacafolia, 1gal  
 CW- Correa Wyn's Wonder 5gal (3)  
 LO- Loropectalum Hines Purple 5gal  
 CP- Coleema "Montary Rose", 5gal  
 CG- Coleonema Golden 5gal  
 GS- grevillea 'superb', 5 gal

**Border Plants:**  
 CA- Campanula Perskiania, Flat  
 WS- Wild Strawberry (Chiloensis) Flat  
 MZ- Arctostaphylos Emerald Carpet 1gal (37)

**Focal Plants:**  
 DA- Dicksonia antarctica 15gal (3)  
 J- Acer Japonica, 'Emperor 1', 24" Box (1)

**This is a WELO Compliant Landscape:**

- Compost: (4) yd<sup>3</sup>/1,000ft<sup>2</sup> to a depth of 6" to all planted areas.
- Plant Water Use: Install climated adapted plants that require occasional, little or no summer water (average WUCOLS plant factor 0.3) for 75% of the plants used.
- Mulch: 3" layer of mulch on all exposed soil surfaces of planting areas.
- Turf, (Sod Rolls): Total turf area does not exceed 25% of the landscape area.
- Landscape Water Meter: A Landscape privately owned dedicated water meter shall be installed and maintained by the owner.
- A weather based irrigation computer shall be used to control the irrigation system.

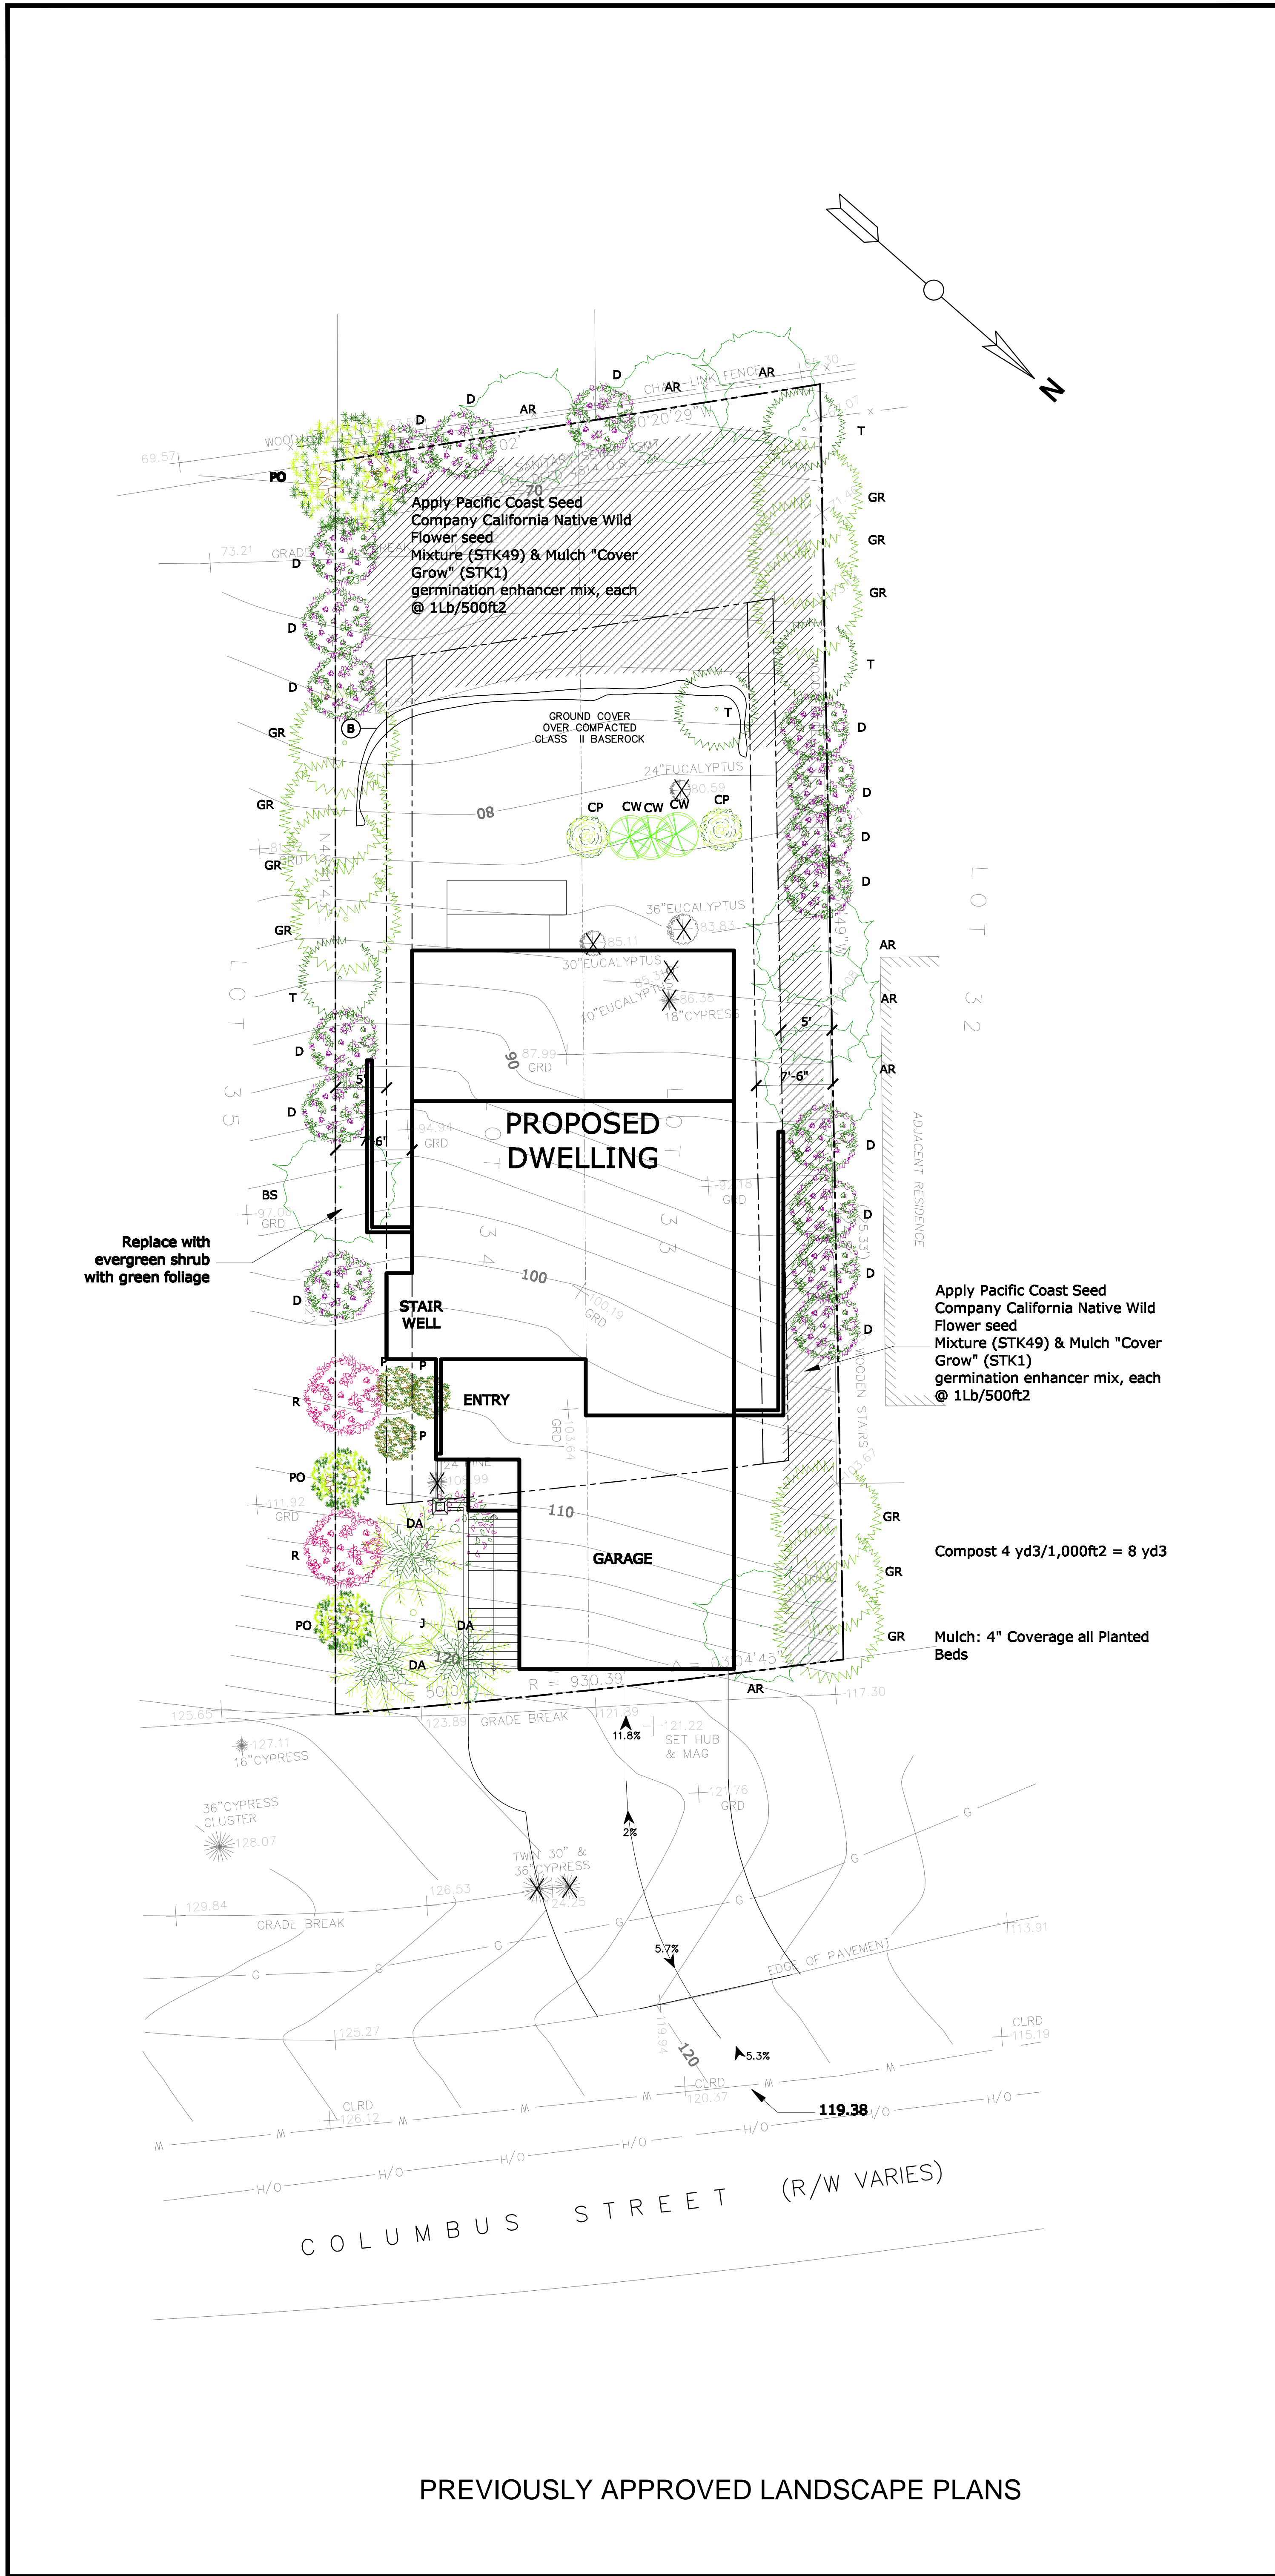

PREVIOUSLY APPROVED LANDSCAPE PLANS

**P-1**  
 PLANTING  
 PLAN

SCALE: 1/8" = 1'0"  
 DATE: 08/23/2018



REVISION TABLE			
NUMBER	DATE	REVISED BY	DESCRIPTION

Scott Soden  
 Artscapes Landscape Design  
 Phone: 650-839-1704  
 Cell 650-823-5824

APN 047-275-050  
 COLUMBUS ST.  
 EL GRANADA, CA.





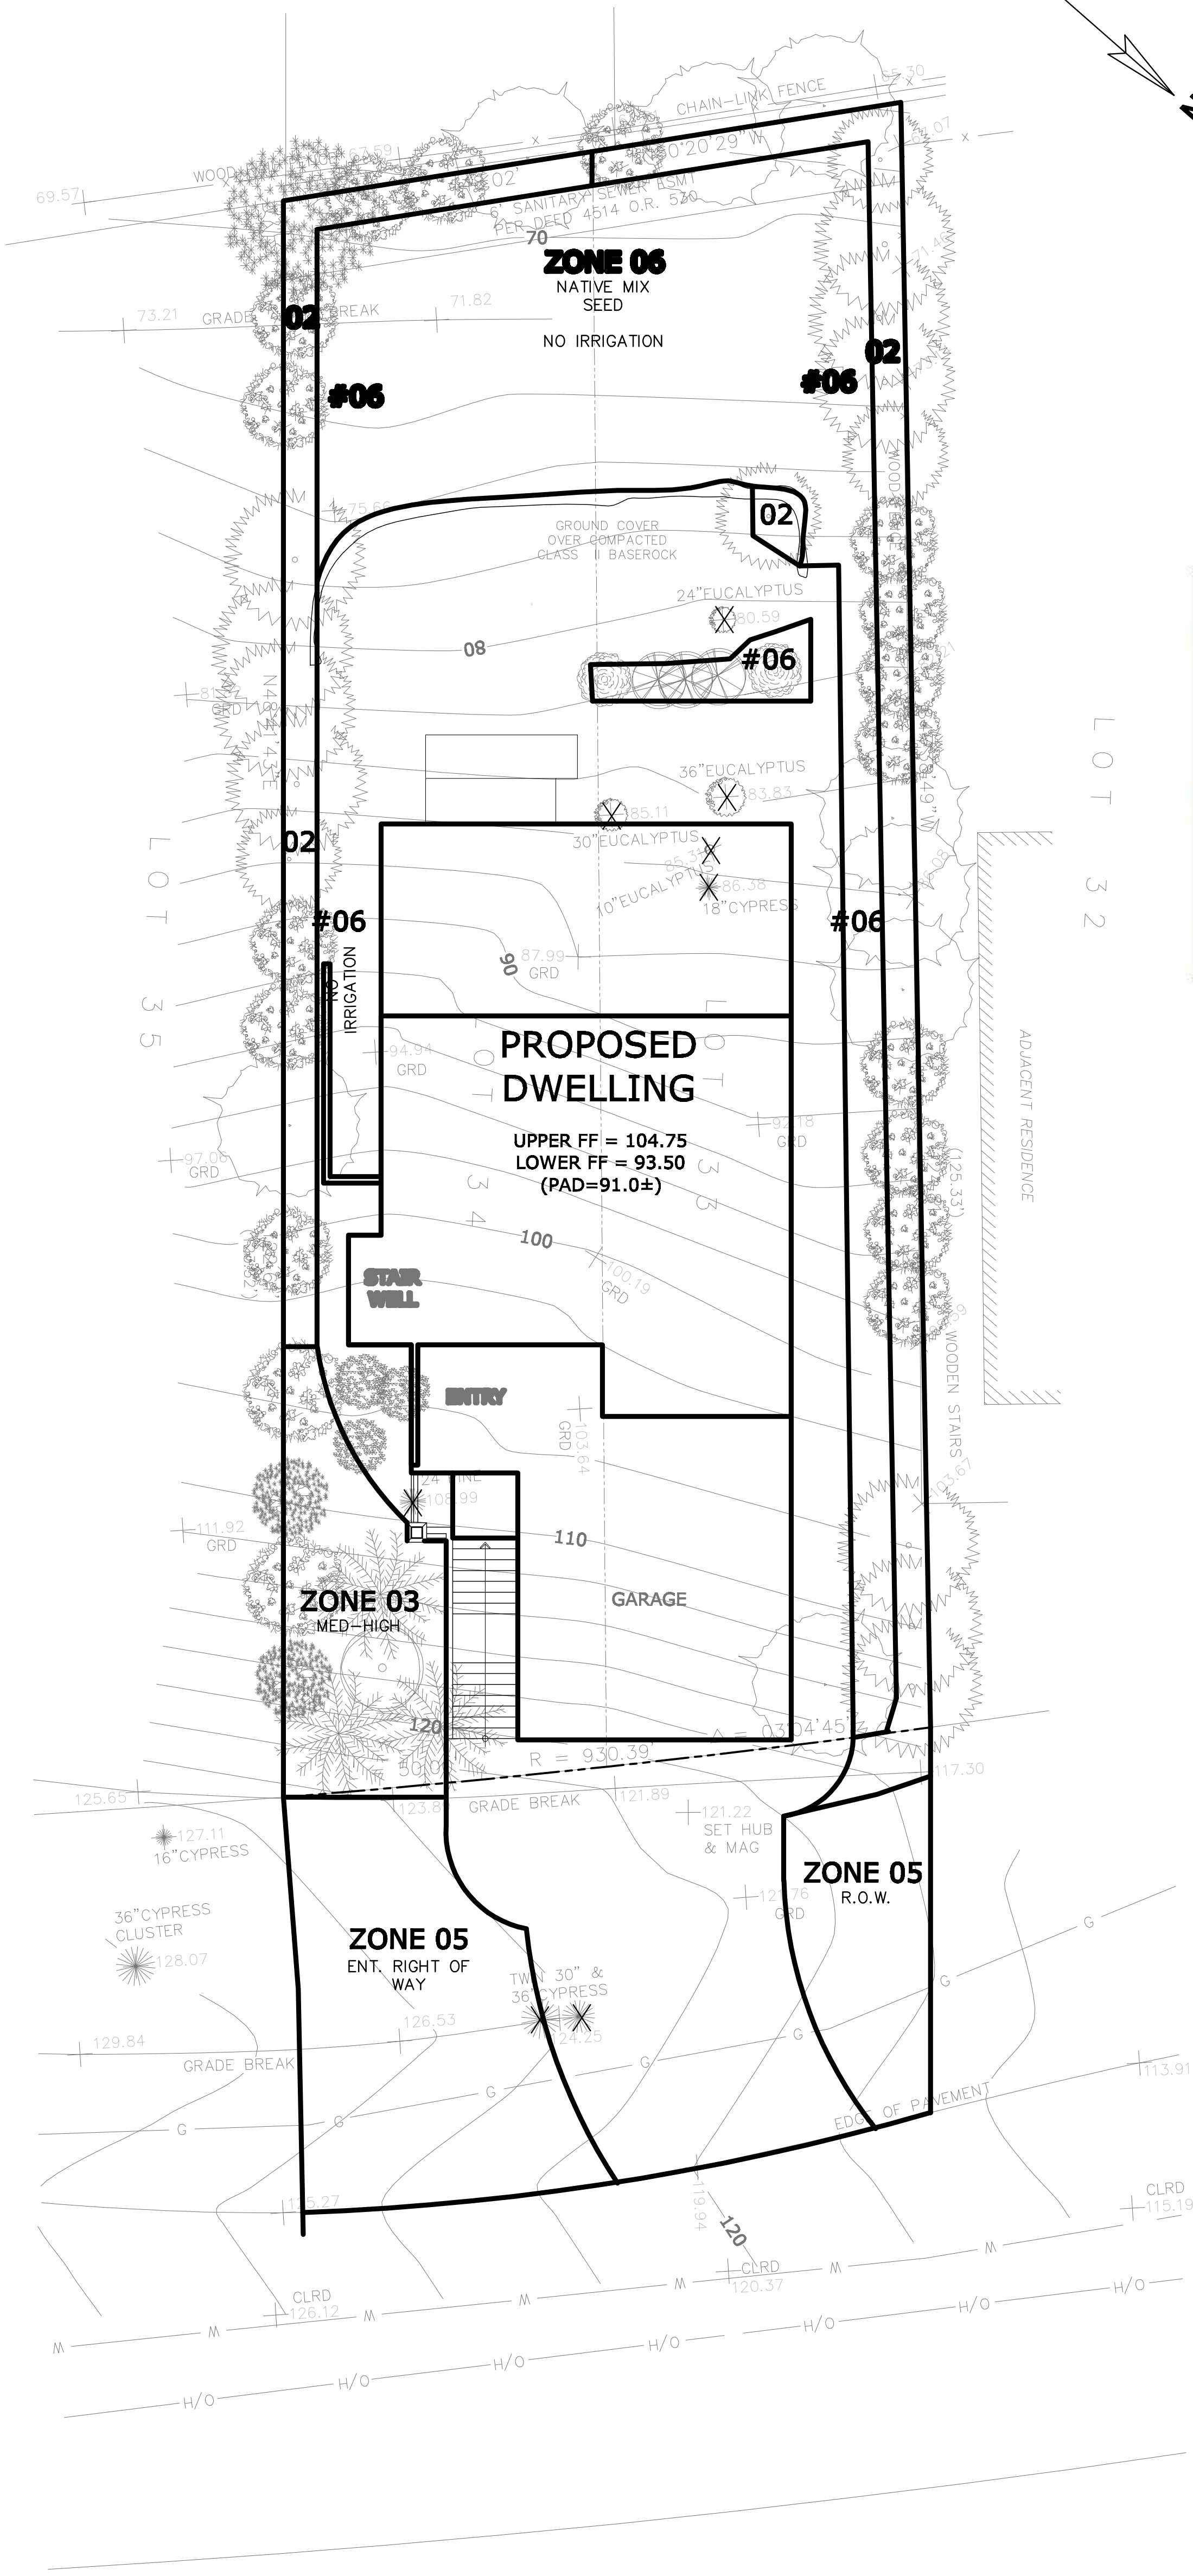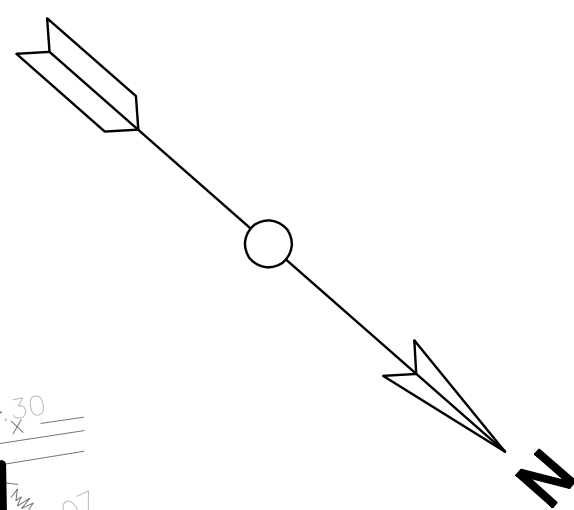

**WATER EFFICIENT LANDSCAPE WORKSHEET**

This worksheet is filled out by the project applicant and it is a required element of the Landscape Documentation Package.

**Reference Evapotranspiration (Eto)** 44.24

Hydrozone # / Planting Description*	Plant Factor (PF)	Irrigation Method*	Irrigation Efficiency (IE)*	ETAF (PF/IE)	Landscape Area (sq. ft.)	ETAF x Area	Estimated Total Water Use (ETWU)*
<b>Regular Landscape Areas</b>							
#02 Low	0.3	Drip	0.81	0.37	825	305	8,373
#03 med/high	0.8	Drip	0.81	0.98	336	329	9,031
#05 low	0.3	Drip	0.81	0.37	515	191	5,236
				Totals	1676(A)	825 (B)	
<b>Special Landscape Areas</b>							
				1			
				1			
				1			
				Totals	0 (C)	0 (D)	
						<b>ETWU Total</b>	22,629
						<b>Maximum Allowed Water Allowance (MAWA)*</b>	22,640

\*Hydrozone #/Planting Description  
 E.g.  
 1.) front lawn  
 2.) low water use plantings  
 3.) medium water use planting  
 \*MAWA (Annual Gallons Allowed) = (Eto) ( 0.62 ) [ (ETAF x LA) + ((1-ETAF) x SLA) ]  
 where 0.62 is a conversion factor that converts acre-inches per acre per year to gallons per square foot per year. LA is the total landscape area in square feet, SLA is the total special landscape area in square feet, and ETAF is .55 for residential areas and 0.45 for non-residential areas.

\*Irrigation Method  
 overhead spray or drip  
 \*Irrigation Efficiency  
 0.75 for spray head  
 0.81 for drip  
 \*ETWU (Annual Gallons Required) =  
 Eto x 0.62 x ETAF x Area  
 where 0.62 is a conversion factor that converts acre-inches per acre per year to gallons per square foot per year.

**ETAF Calculations**

Regular Landscape Areas

Total ETAF x Area	(B)	825
Total Area	(A)	1,676
Average ETAF	B ÷ A	0.49

Average ETAF for Regular Landscape Areas must be 0.55 or below for residential areas, and 0.45 or below for non-residential areas.

All Landscape Areas

Total ETAF x Area	(B+D)	825
Total Area	(A+C)	1,676
Site-wide ETAF	(B+D) ÷ (A+C)	0.49

A copy of this form may be obtained from Department of Water Resources website: <http://www.water.ca.gov/wateruseefficiency/landscapeordinance/>

PREVIOUSLY APPROVED LANDSCAPE PLANS


<b>H-1</b> HYDROZONE PLAN	SCALE: 1/8" = 1'0"	DATE: 08/23/2018	<b>REVISION TABLE</b> <table border="1"> <thead> <tr> <th>NUMBER</th> <th>DATE</th> <th>REVISED BY</th> <th>DESCRIPTION</th> </tr> </thead> <tbody> <tr><td> </td><td> </td><td> </td><td> </td></tr> <tr><td> </td><td> </td><td> </td><td> </td></tr> <tr><td> </td><td> </td><td> </td><td> </td></tr> <tr><td> </td><td> </td><td> </td><td> </td></tr> </tbody> </table>	NUMBER	DATE	REVISED BY	DESCRIPTION																	<b>Scott Soden</b> Artscape Landscape Design Phone: 650-839-1704 Cell 650-823-5824	APN 047-275-050  COLUMBUS ST. EL GRANADA, CA.
	NUMBER	DATE		REVISED BY	DESCRIPTION																				

**DRIP IRRIGATION SYSTEM:**

Consists of Pressure Reducer, Y-Filter, Hydraulic Anti-Siphon Valve, 1/2" Tubing to all Plants, 1/2 Gallon, & 1 Gallon Emitters only.  
 NO MICRO-SPRAYS SHALL BE USED ON THIS SYSTEM.  
 Drip Emitters shall be placed up-slope of the plants to be watered.  
 Watering Schedule shall be 1 hour, three times per week, divided into (4) Intervals of 15 minute duration to prevent water run-off.

**This is a WELO Compliant Landscape:**

- **Compost:** (4) Yd3 / 1,000 Ft2 to a depth of 6" to All Planted Areas.
- **Plant Water Use:** Install climate adapted plants that require occasional, little or no summer water (average WUCOLS plant factor 0.3) for 75% of the plants used.
- **Mulch:** 3" layer of mulch on all exposed soil surfaces of planting areas.
- **Turf, (Sod Rolls):** Total turf area does not exceed 25% of the landscape area.
- **Landscape Water Meter:** A Landscape privately owned dedicated water meter shall be installed and maintained by the owner.
- **A weather based irrigation** computer shall be used to control the irrigation system.

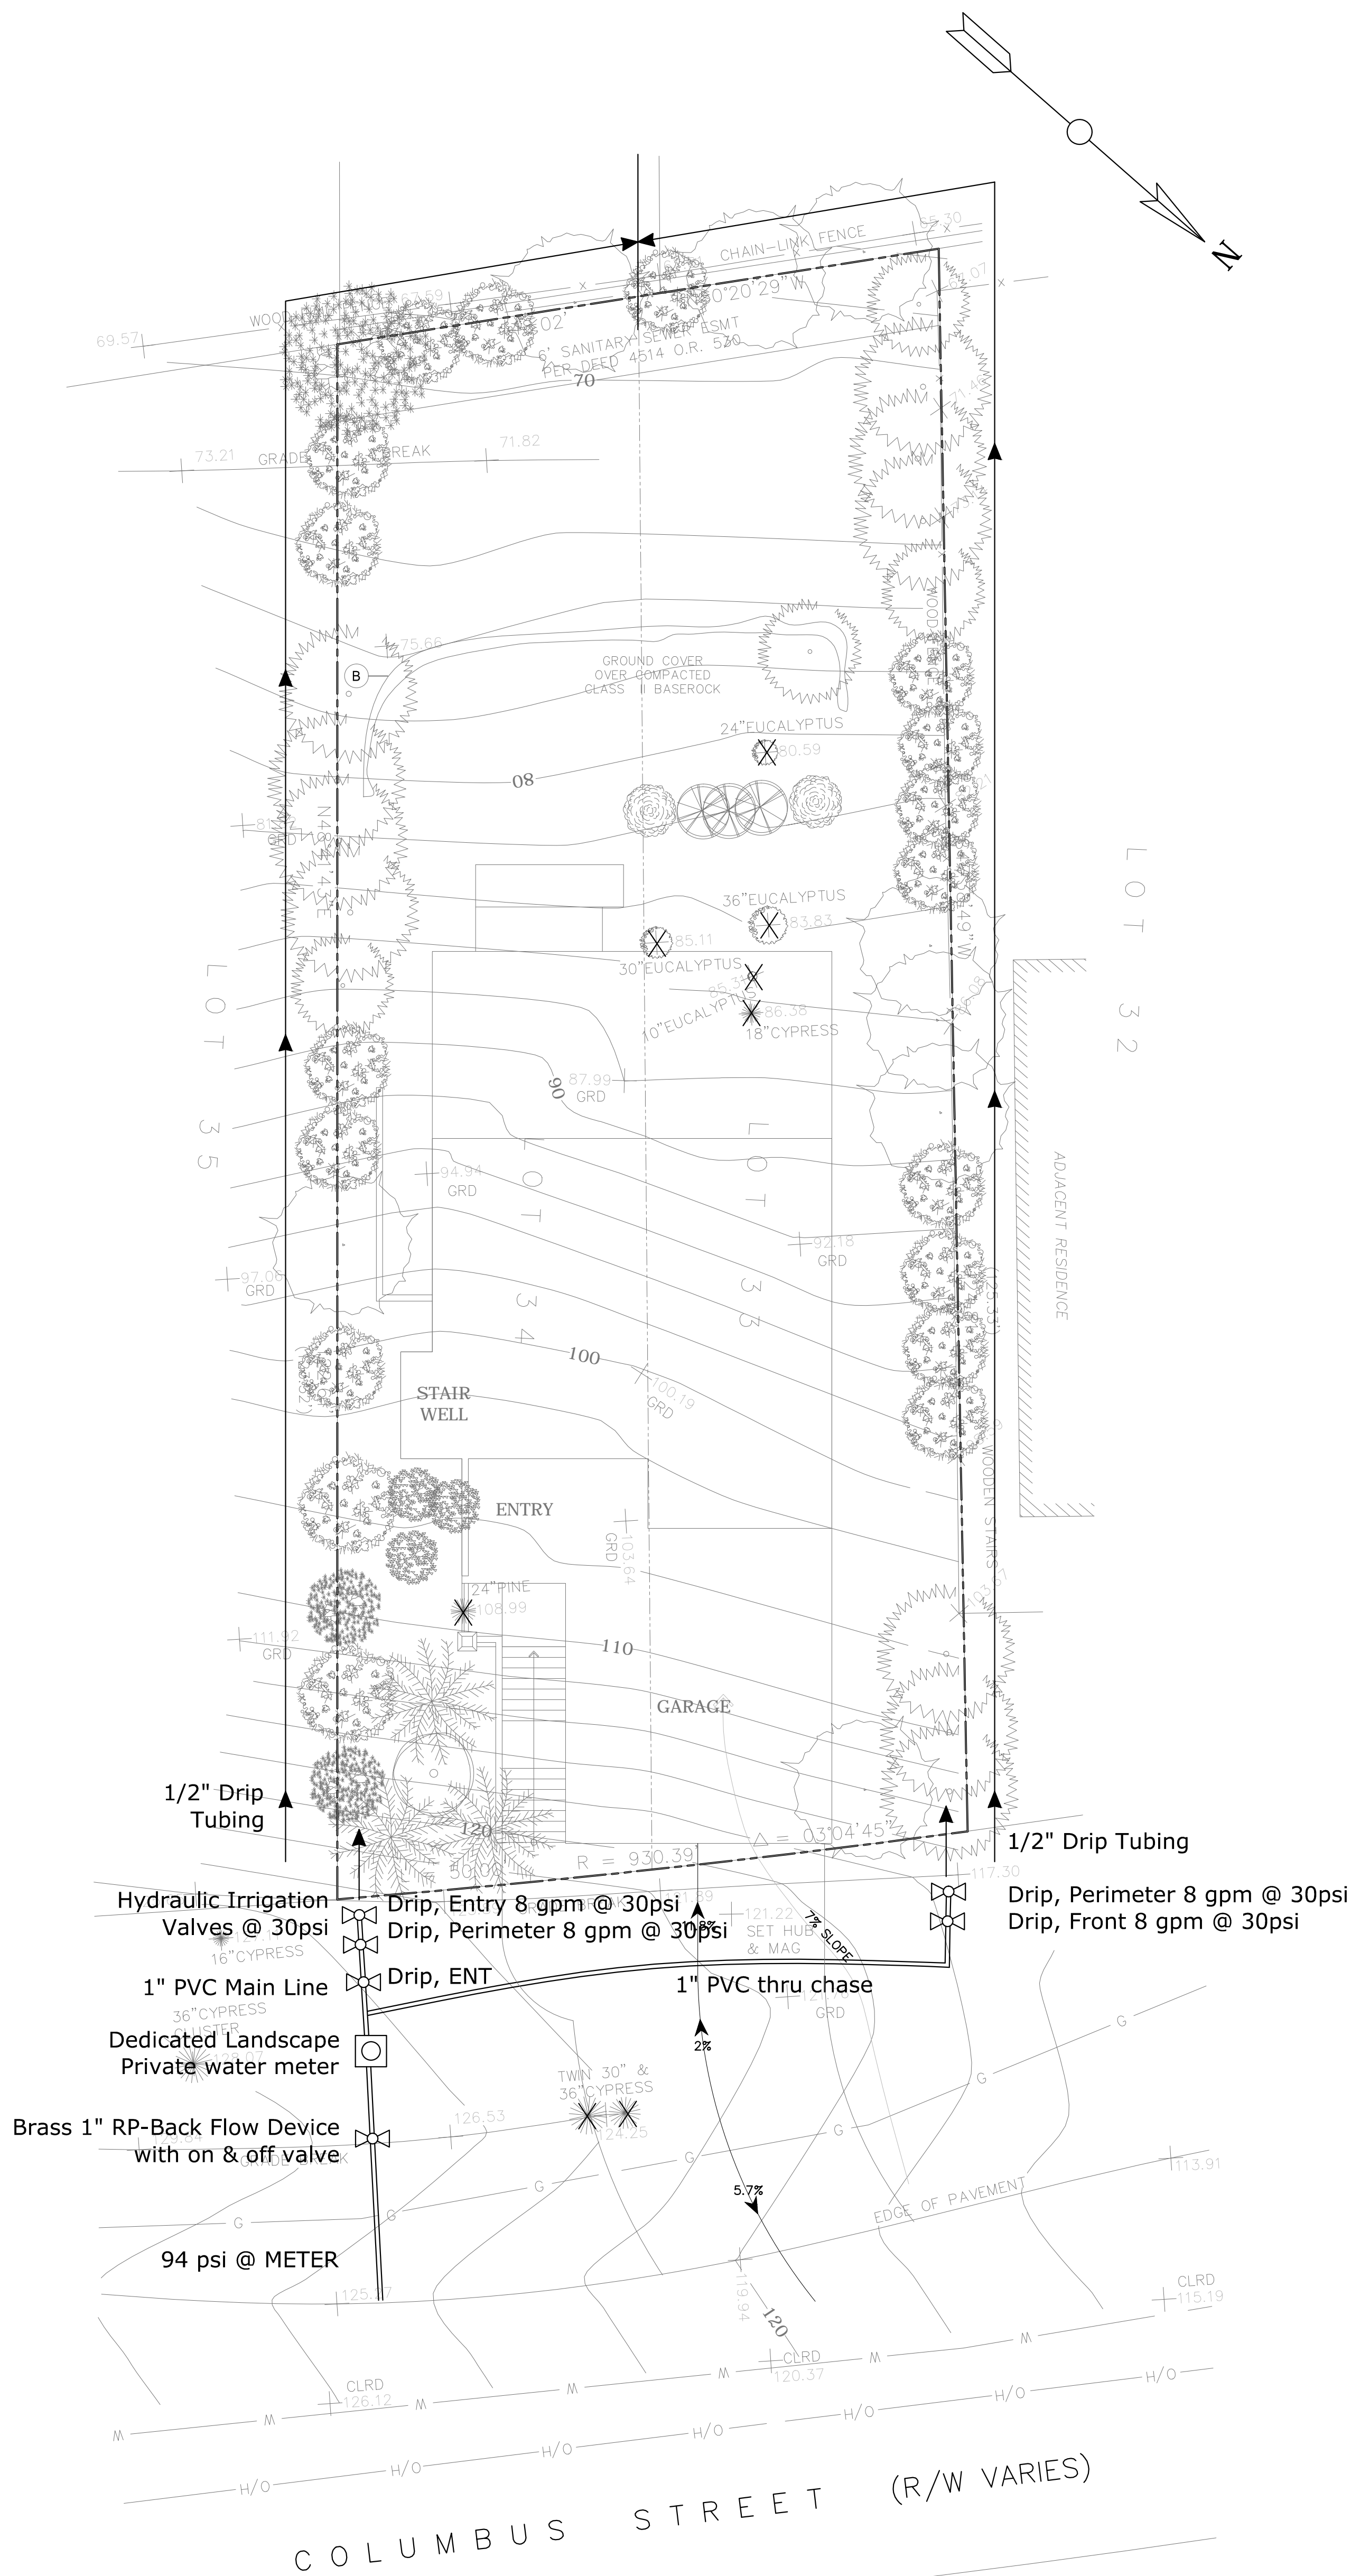

PREVIOUSLY APPROVED LANDSCAPE PLANS